


515 Appian Ave

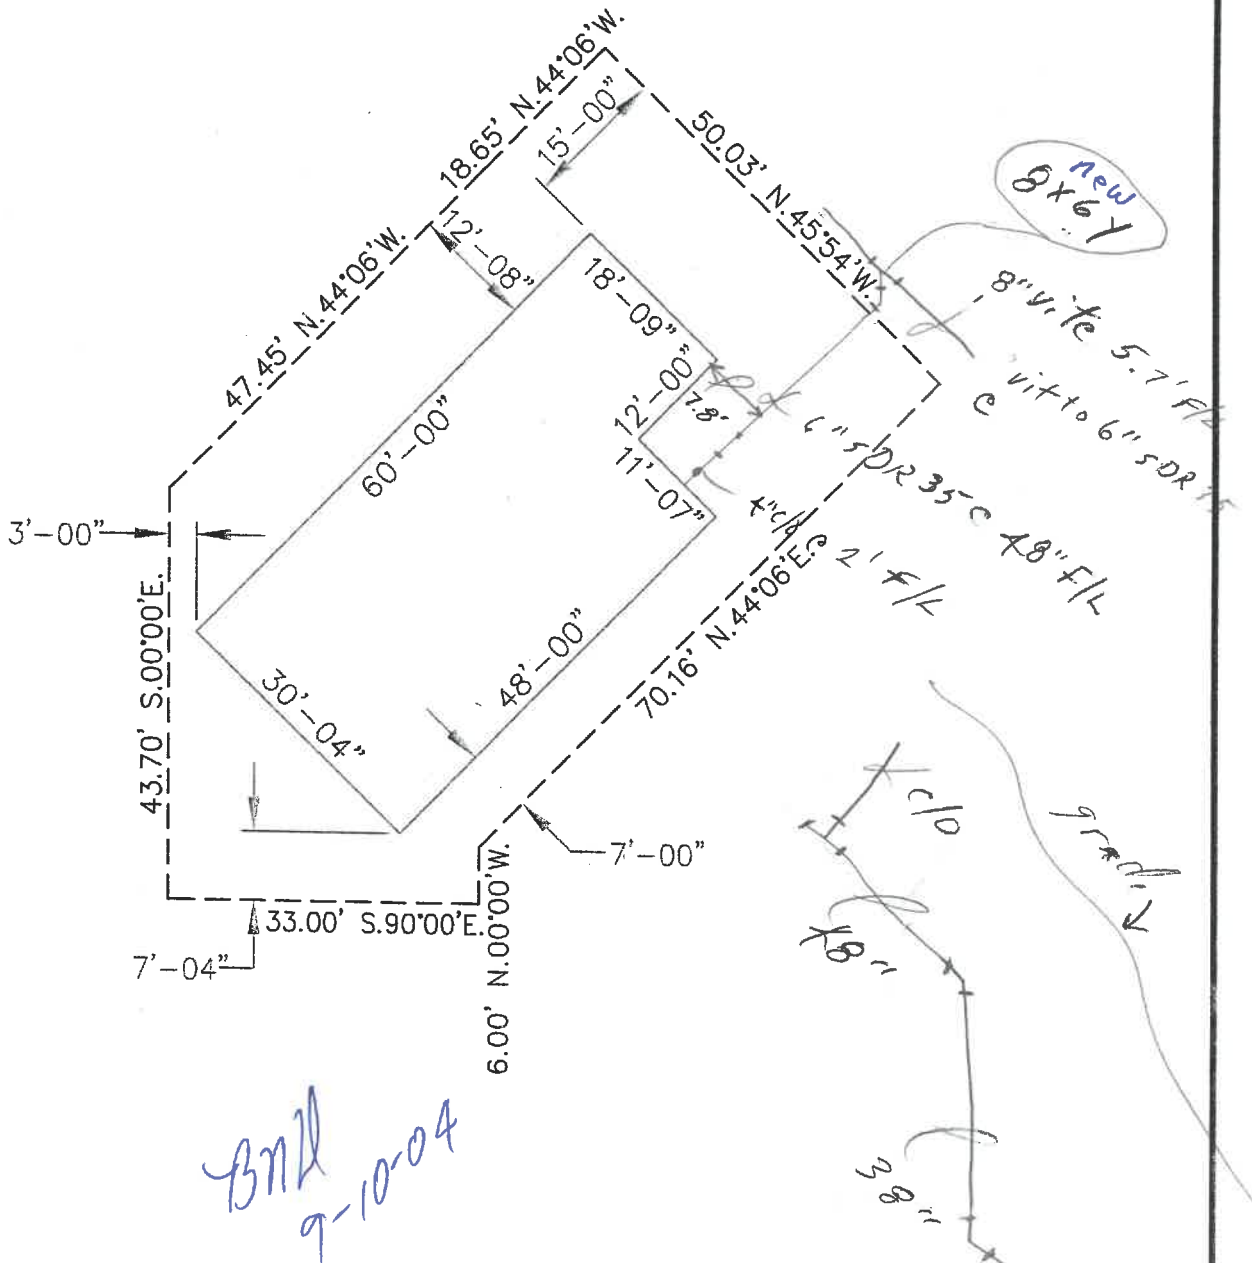


City Of Napoleon  
Engineering Department

P.O. Box 151/255 W. Riverview Ave.  
Napoleon, Ohio 43545  
Phone: (419) 592-4010  
Fax: (419) 599-8393

Board Of  
Zoning Appeals  
Exhibit A-BZA-03-13

Date: 9-10-04  
Drawn By: J.R.K.  
Approved By: J.R.K.  
Scale: 1"=20'

Sheet \_\_\_ Of \_\_\_

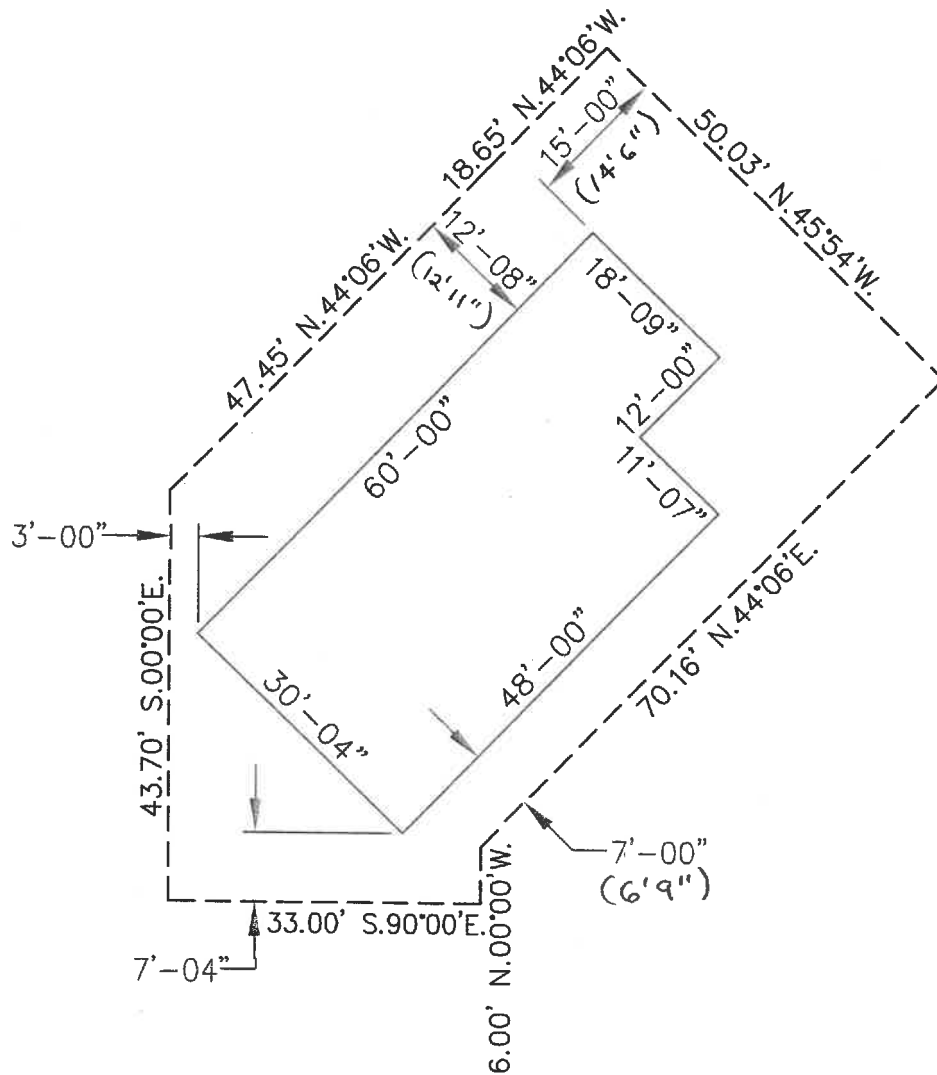

0'-00" - approved  
 (0'-00") - As Built

City Of Napoleon  
 Engineering Department

P.O. Box 151/255 W. Riverview Ave.  
 Napoleon, Ohio 43545  
 Phone: (419) 592-4010  
 Fax: (419) 599-8393

Board Of  
 Zoning Appeals  
 Exhibit A-BZA-03-13

Date: 12/04/03  
 Drawn By: M.B.S.  
 Approved By: J.R.K.  
 Scale: 1"=20'

Sheet \_\_\_ Of \_\_\_