

CITY OF NAPOLEON WATER TAPPING PERMIT FORM

PERMIT #:

ISSUED:

JOB LOCATION: _____

SUBDIVISION NAME: _____ LOT #: _____

OWNER: N.H.S. Ball Field

ADDRESS: 1380 Bales + Westmoreland

CONTRACTOR: _____ PHONE: _____

TAP SIZE: 1" X 1.5" _____ 2" _____ OTHER _____

AMOUNT PAID: _____ YOKE SIZE: _____


PLUMBING CONTRACTOR: _____ PH: _____

DATE OF TAP: 5-24-01 OLD TAP #: 7455 NEW TAP #: 0117

SIZE AND KIND OF MAIN: 8" AC

LOCATION OF MAIN: Under cart path DEPTH OF MAIN: 5'

DIST FROM HYDRANT VALVE: 3' W of Hyd 170 DIST TO CURB STOP FROM CORP: 72'

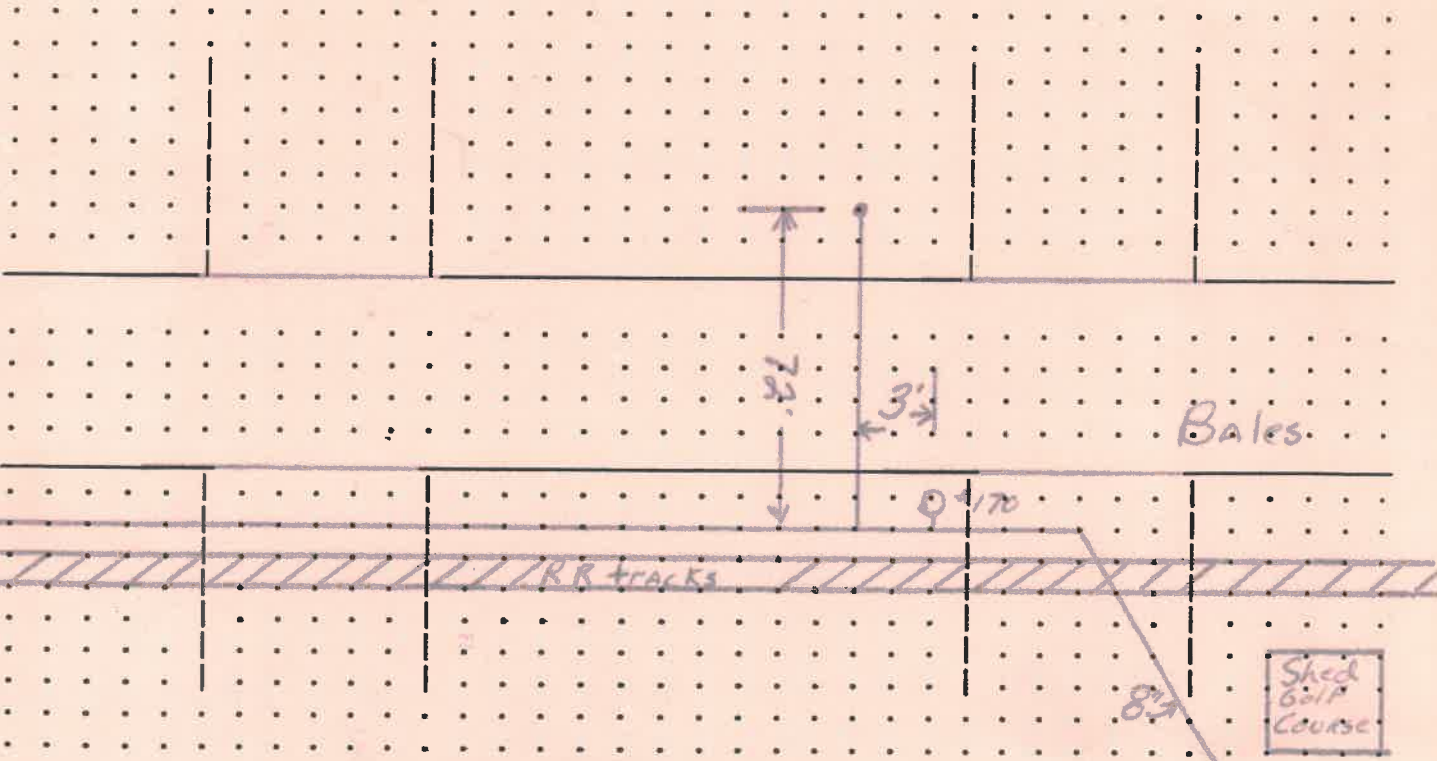

DATE APPROVED: Alley C. Mairlugh BY: June 5, 01

→ Please note that this service was installed over 10 years ago, but has just become metered.