

SEWER TAPPING PERMIT

Issued by

The City of Napoleon Engineering Dept.

255 West Riverview Ave. Napoleon, Ohio 43545 Pn. 592-4010

Entry No. _____

Permit No. _____ Issued 5-13-91 Build. Permit No. _____

Permit Fee \$ 45.00

Job Location 211 E. Barnes St.

Street Bond \$ _____

Lot _____ sub div. or legal disc. _____

Date Paid 5-13-91

Issued By _____

Owner Madess Patcher Pn. _____

Address 211 E. Barnes St.

Agent _____ Pn. _____

Address _____

for office use only
.....

WORK INFORMATION

Sanitary Sewer Tap	_____	Size of Tap	_____	Size and Type of Sewer	_____	Street to be Opened	_____
	yes no						yes no
Storm Sewer Tap	_____	Size of Tap	_____	Size and Type of Sewer	_____	Street to be Opened	_____
	yes no						yes no

Street opening Agreement Approval Date _____ Opening Bond Fee (Set by Engineer) _____

READ AND SIGN BELOW; The undersigned hereby agrees complete the work described above and to make use of said sewers only as allowed by and in strict accordance with all applicable provisions of The Napoleon Engineering Dept. Rules and Regulations, The Napoleon Standard Specification for Water Main, Sanitary Sewer and Storm Sewer Construction and other Pertinent Sections of the Napoleon Code of Ordinances.

Date 5-13-91 Signature of Applicant Jerry Alan

Permit not valid without signature

INSPECTION RECORD _____ to be completed by the Field Inspector

Date Inspection is made _____ Size and Type of Sewer _____

Location _____ Depth _____ Type of Test _____ Additional Information _____

Date _____ Inspected By _____ signature of inspector

Sketch Of Installation on Back or Attached

PAID
MAY 13 1991
CITY OF NAPOLEON

5-16-91


Jerry Blanz

211 Barnes St

Woburn Ketchikan

3' deep

2.0%
Grade

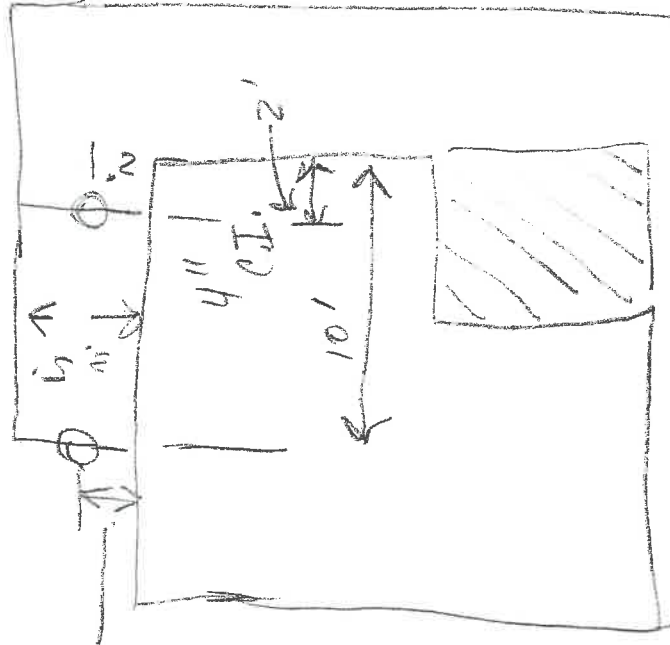

alley

(C)

(M)

6" Main

Barnes

127 Ft

5-16-91


Jerry Glanz

211 Barnard

Melrose Restone


Alley

Partitions

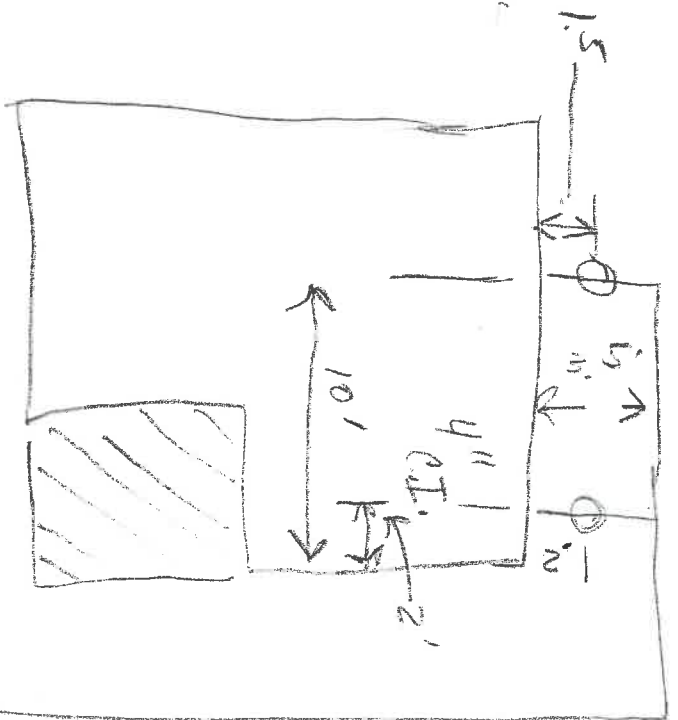

3' deep

2.0%
Grade

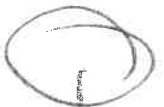


Barnard

6" Main

127 FT



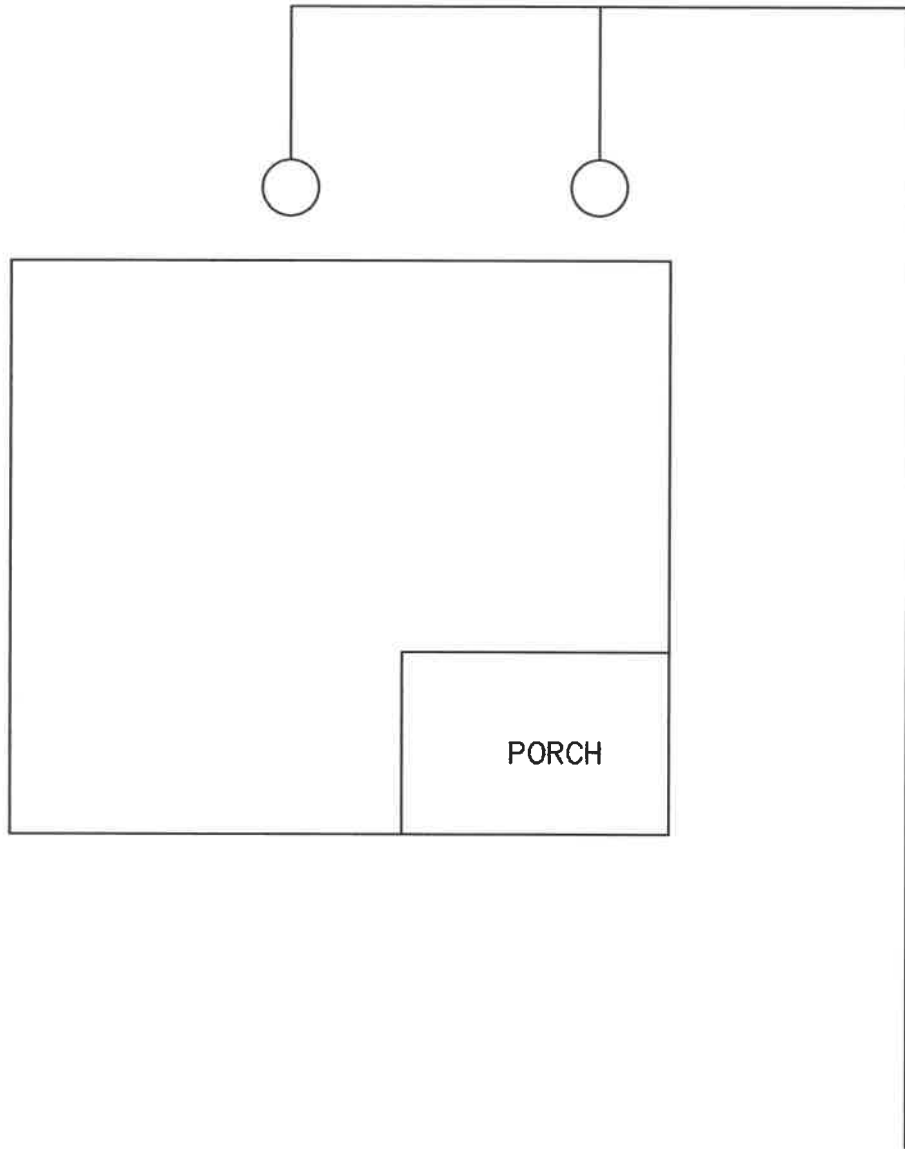

CITY OF NAPOLEON
ENGINEERING DEPARTMENT
PO BOX 151 / 255 W. RIVERVIEW AVE.
NAPOLEON, OHIO 43545
PHONE NO. (419) 592-4010
FAX NO. (419) 599-8393

MODESS RETCHER
211 BARNES
CLEAN OUTS

DATE: 08/12/96
DRAWN BY: M.B.S.
APPROVED BY: M.G.H.
SCALE: NTS
SHEET ___ OF ___