

CITY OF NAPOLEON
255 W. Riverview
NAPOLEON, OHIO 43545

message

reply

to

DON BISHOFF

FOLD

subject ENCLOSED FIND 1- COPY OF THE

SEWER TAP MARK FOR LOT # 17B

AND THE STUB PUT ACROSS FORTH

ST. FOR FUTURE LOT # 18-B (THE SOUTH

END OF YOUR LOT # 18) OF BARNS FIRST
ADDITION,

THIS IS FOR YOUR RECORDS SHOULD

YOU EVER SELL OR BUILD ANOTHER

HOUSE ON THE SOUTH PORTION OF THE LOT,

date 7-7-88 signed ELOON AUBER

date _____ signed _____

SENDER: Mail white and pink copies with carbon intact.

RECEIVER: Reply, retain white copy, return pink copy.

REF FUTORN LOT @ 304 E. BARNES

SEWER INSPECTION NOTE
4-9-88

THE SANITARY SEWER TAP FOR
THIS PROPERTY ^{304 E. BARNES} WAS INSTALLED
ON THIS DATE IN COMBINATION WITH
THE SEWER TAP AT 232 EAST BARNES,
SEWER TAP NO SA 0028-87



THIS WAS DONE TO ALLOW THE SUB-DIVISION
OF THIS PROPERTY KNOWN AS LOT # 18
OF BARNES 1ST ADDITION INTO 2 LOTS
~~IF THE OWNER OF~~ IF THE OWNER OF
LOT # 18 WOULD WANT TO DO SO
IN THE FUTURE.

ALSO REFER TO INSPECTION NOTES FOR
232 E. BARNES.

SITE PLAN

THE SOUTHERLY 84' OF LOT NO. 17-B
 BARNES 1ST ADDITION
 CITY OF NAPOLEON, OHIO

SCALE: 1" = 20'

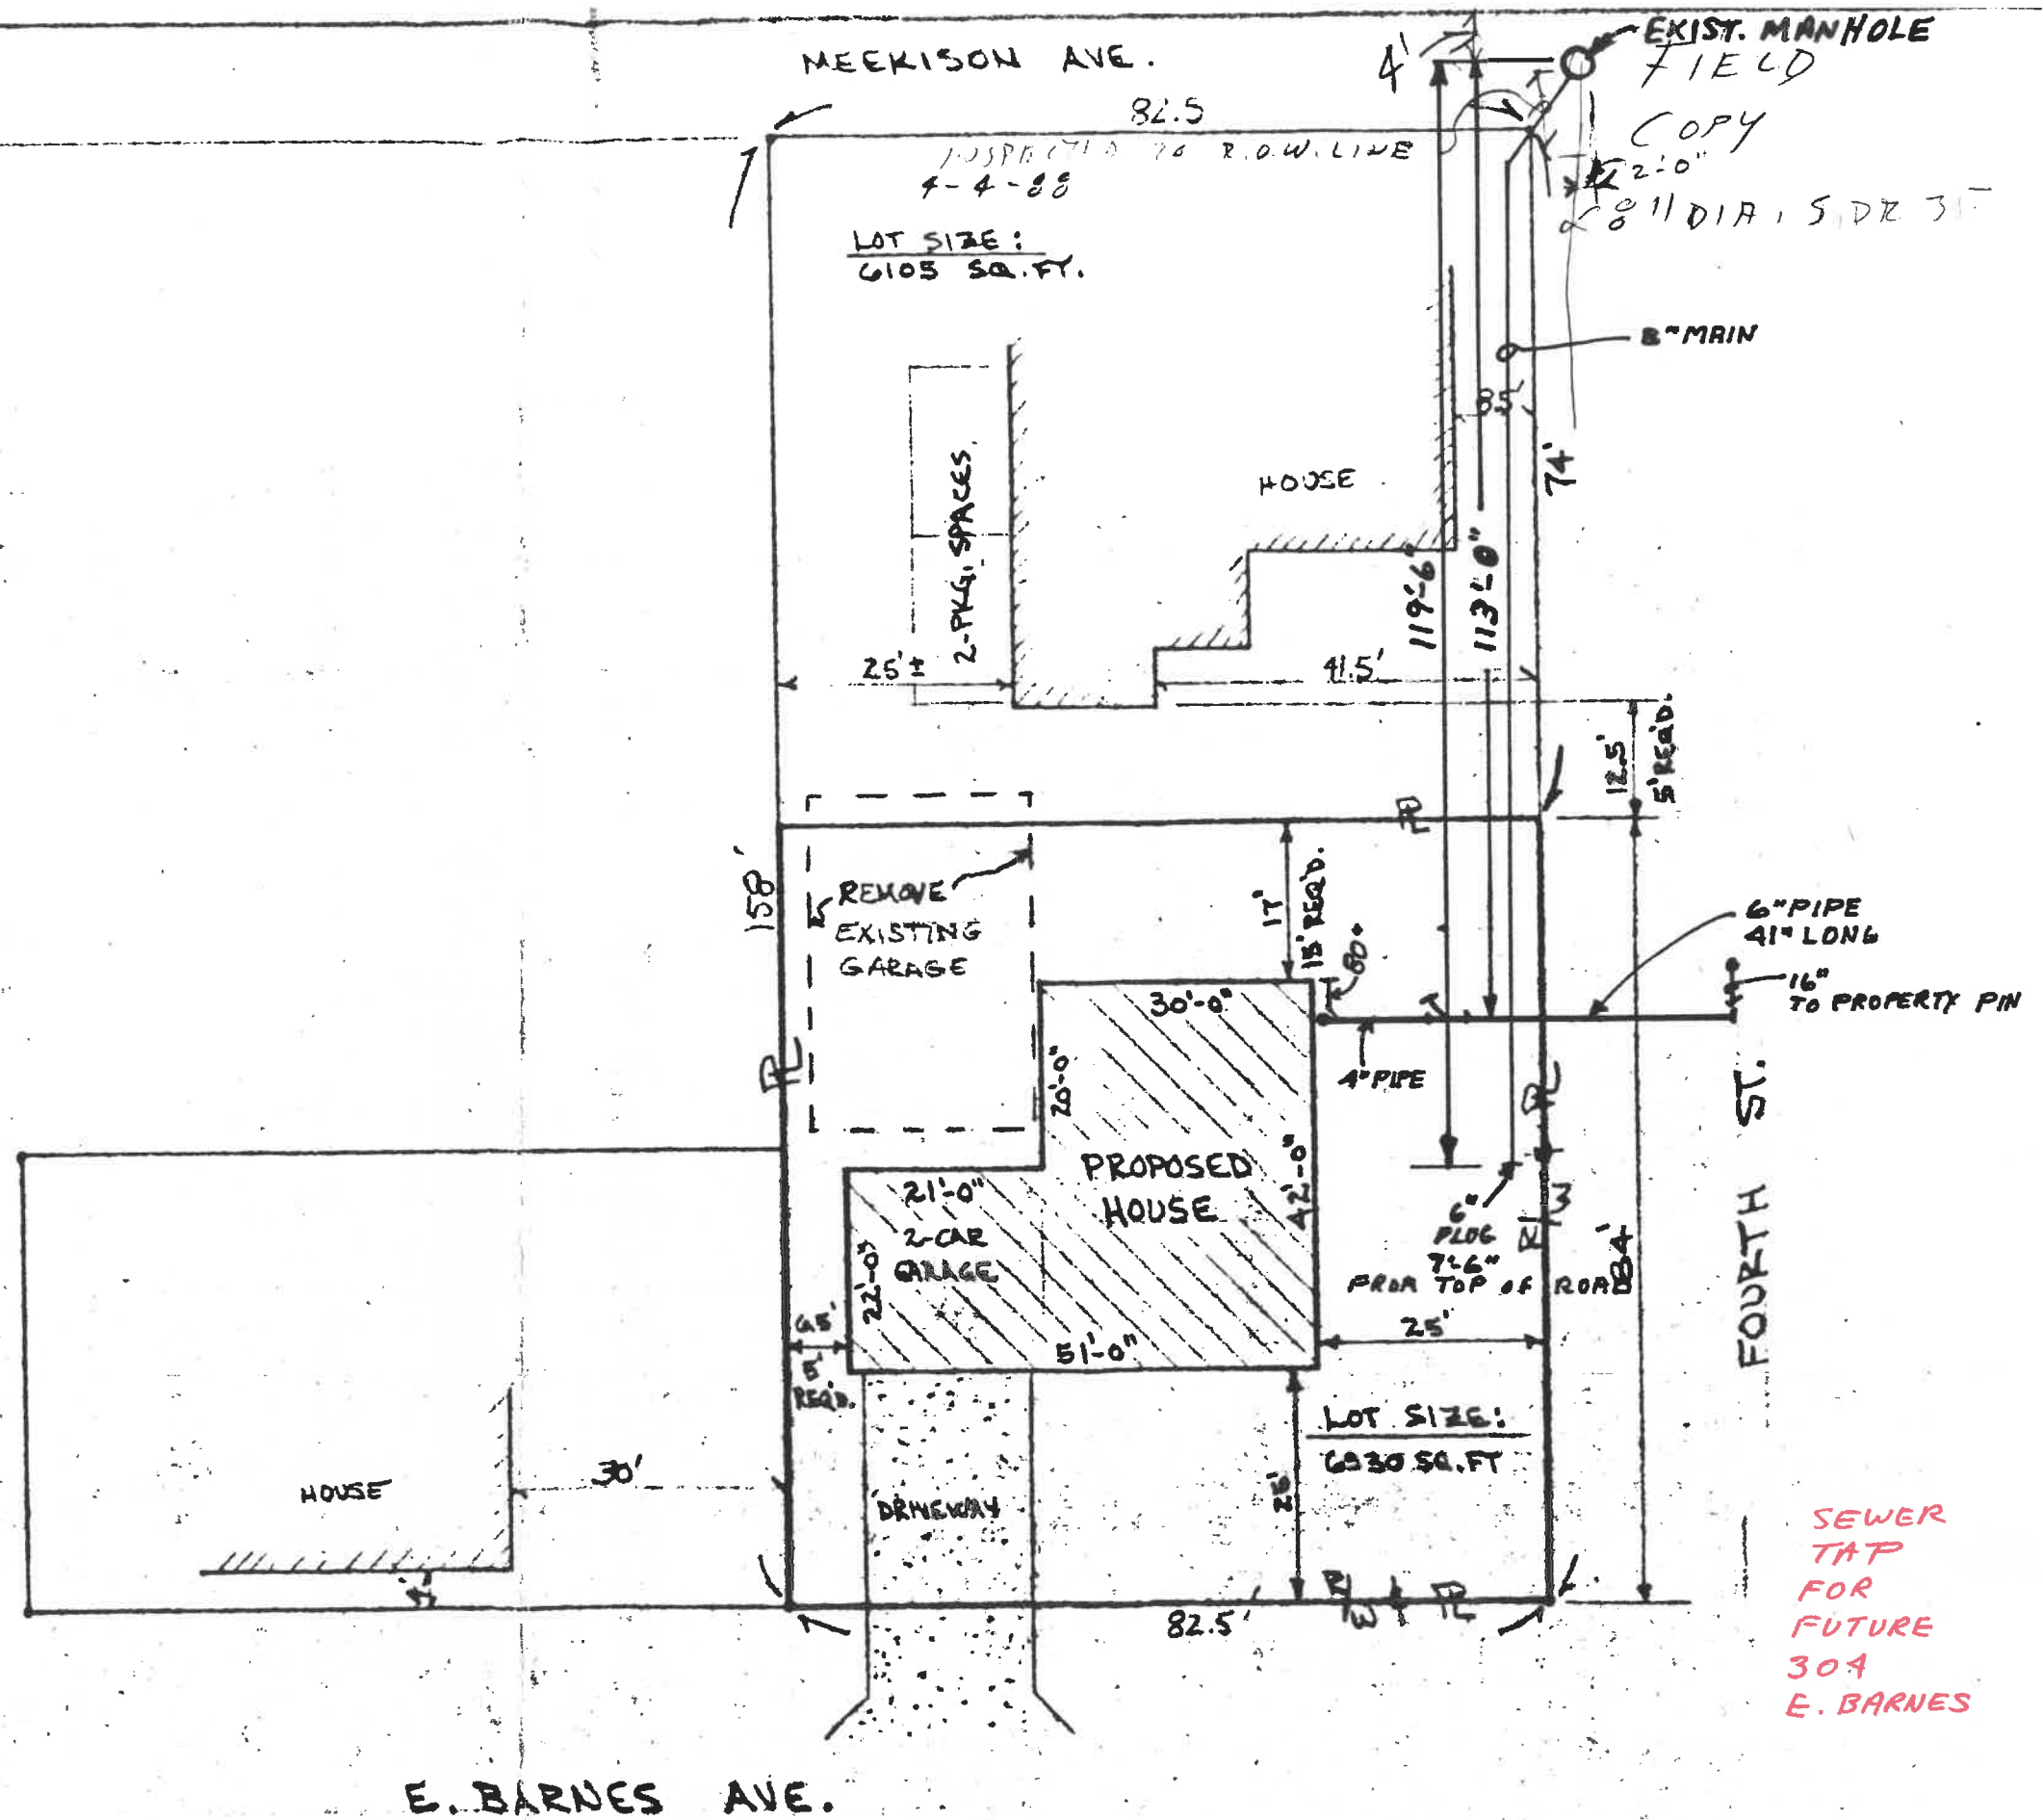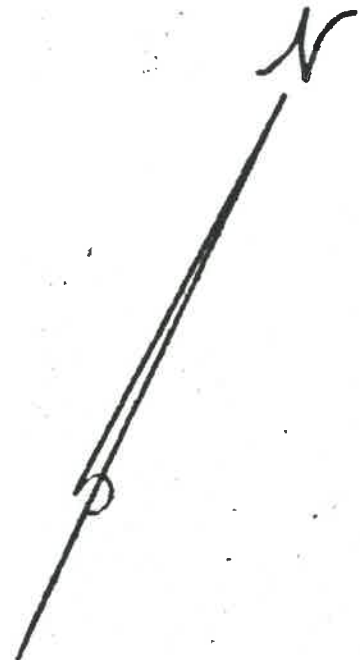

SEWER TAP FOR FUTURE 304 E. BARNES