

# APPLICATION FOR PERMIT TO TAP SEWER

(Print or Type)

Owner LEROY GERBAUGH  
Address 7 BAUMAN PLACE  
Contractor J.A. SCHULTZ & SON INC.  
Address RT. 2 NAP. O. Tel. 592-3946

NO. \_\_\_\_\_  
BLDG. PERMIT \_\_\_\_\_  
PERMIT FEE \$ \_\_\_\_\_  
DATE PAID \_\_\_\_\_  
for office use only

### LOCATION OF CONNECTION

Street and No. 7 BAUMAN PLACE Sanitary  Storm \_\_\_\_\_  
Lot No. \_\_\_\_\_ Subdivision \_\_\_\_\_ Size of Tap 6"  
Size and Type of Sewer 6" P.V.C.

ALL WORK MUST BE INSPECTED

I certify that the sewer will be used only as indicated and no other Drainage will be connected.


Date 11-7-80 Signature J. A. Schultz & Son Inc. owner-builder-agent  
do not write below this line

### INSPECTION RECORD

Date Inspected 11-26-1980 Size and Type of Sewer 6" PVC  
Location See Drawg Depth See Drawg Type of Test N/A  
Inspected and Approved By: Bruce W. Wainwright Inspector Date 11-26-80  
Additional Information Septic Tank Filled w/stone

Send copy to: \_\_\_\_\_

### SKETCH OF INSTALLATION

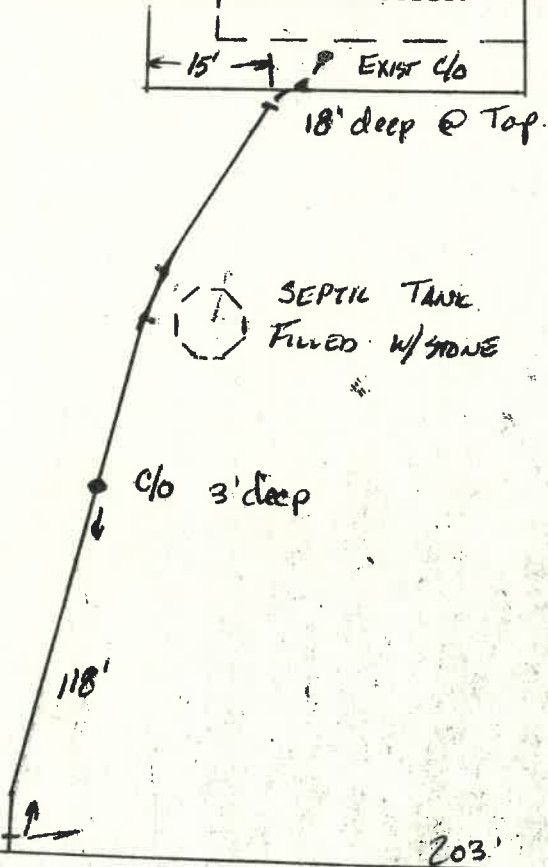

To MH #19

MH #18

White-Applicant

Yellow Building Dept.

Pink-Clerk-Treasurer

