

Print Date: 04/26/2017



City of Napoleon Building Department

255 W. Riverview
P.O. Box 151
Napoleon, OH 43545
Phone: (419) 592-4010
Fax: (419) 599-8393
Email:

Sidewalk/Curb Replacement

Permit Number: P-17-0137
Expiration Date: 04/26/2018

Napoleon City Schools
701 Briarheath

Napoleon, OH 43545

Description:

Building Permit Info

Project Description:	Sidewalk replacement
Construction Value:	\$6,021.00

Authorizing Signature

Date

INVOICE TO CITY OF NAPOLEON

Curbing and/or Sidewalk replacement

Location of project Briarheath Drive

Napoleon Area City School District 701 Briarheath Drive
 Owner of Property address

Napoleon 43545 (419) 599-7015
 City Zip Phone

Type of work performed: Curbing replacement X Sidewalk replacement X

Total length of curbing replaced 86 ^{86.5} x \$20.00 ----- \$ 1,320.00 ~~\$1,730.00~~

Total square footage of sidewalk replaced 3,134 ^{3,203} x \$1.50 ----- \$ 4,701.00 ~~\$4,804.50~~

Total to be reimbursed to the owner ----- \$ 6,021.00 ~~\$6,534.50~~

The City may reimburse the owner for sidewalk replacement in the right of way at a rate of one dollar and fifty cents (\$1.50) per square foot, if installed in accordance to City specification. The City will reimburse the owner for curbing replacement in the right of way at a rate of twenty dollars (\$20.00) per linear foot, if installed in accordance to City specification.

Name of City registered contractor who performed such work; (If none involved mark "Self") TBD ENGELKE CONSTRUCTION SOLUTIONS ^{ROW PERMIT #} City Lic.# P-17-0185

Michael R. Besterman ^{Treasurer}
 Signature of property owner 4-18-17
 Date

The work referenced herein has been performed in accordance with the City of Napoleon minimum requirements and therefore is eligible for reimbursement accordingly.
[Signature]
 City Engineer 2017-04-18
 Date

City Purchase order number _____ City Permit number P-17-0137

NAPOLÉON SCHOOL 2017

SIDEWALK

CURB

33

35

136

20.5

125

31

80

86.5 LF

204

1205

1055

365

3,203 SF



DGL Consulting Engineers, LLC
Experience that matters! • Founded 1926

NAPOLEON AREA SCHOOLS SIDEWALK RENOVATIONS

NAPOLEON AREA SCHOOL DISTRICT

PRE-CONSTRUCTION MEETING

May 5, 2017 10:00pm

Napoleon Area Schools District Office

1. Introductions
 - a. Sign-in Sheet
2. Project Staffing
 - a. Owner Representative
 - b. Prime/Subs and Project Responsibilities
 - i. Material Testing
 - c. Normal and Emergency Contacts
 - i. Provide names and phone numbers
 - ii. List in order to contact
3. Schedule
 - a. Start Date
 - i. On or about June 1, 2017
 - b. Completion Date
 - i. Contract August 24, 2017
 - c. Work Days Allowed = 120 days
 - d. Working days/hours
 - e. Softball field area access
 - i. Available August 1, 2017
 - ii. Complete by August 31, 2017
4. Safety
 - a. Building Access by public
 - b. School contact for building access coordination
 - c. Summer activities
5. Maintenance of Traffic/Detour Notifications
6. Pay Requests
7. Change Orders & Claims Resolution
 - a. No change orders until authorized in writing
8. RFI's
9. R/W

jasoneengelkecs.com
↳ ROW permit
-STAINED CONCRETE

① SLOAN

4 WEEKS TO FINISH PROJECT (APPROX)



-TRY TO FIND SCHEDULE FOR ONE MOBILIZATION

-DRIVE W/ STONE

*5 DAYS WEEK
 - DAY LIGHT HRS*

(NOT ALLOWED ON MOODLAND AVE) BRIDGE

PLOTTED: Mar 07, 2017 - 4:24pm
DRAWING: AE\16119 (Napoleon Jr-Sr High Walks)\Civil\Draw\16119 CD.dwg: C05 MAIN NORTH DEMO NAPOLEON

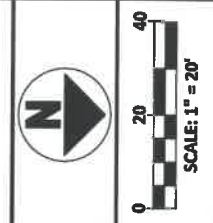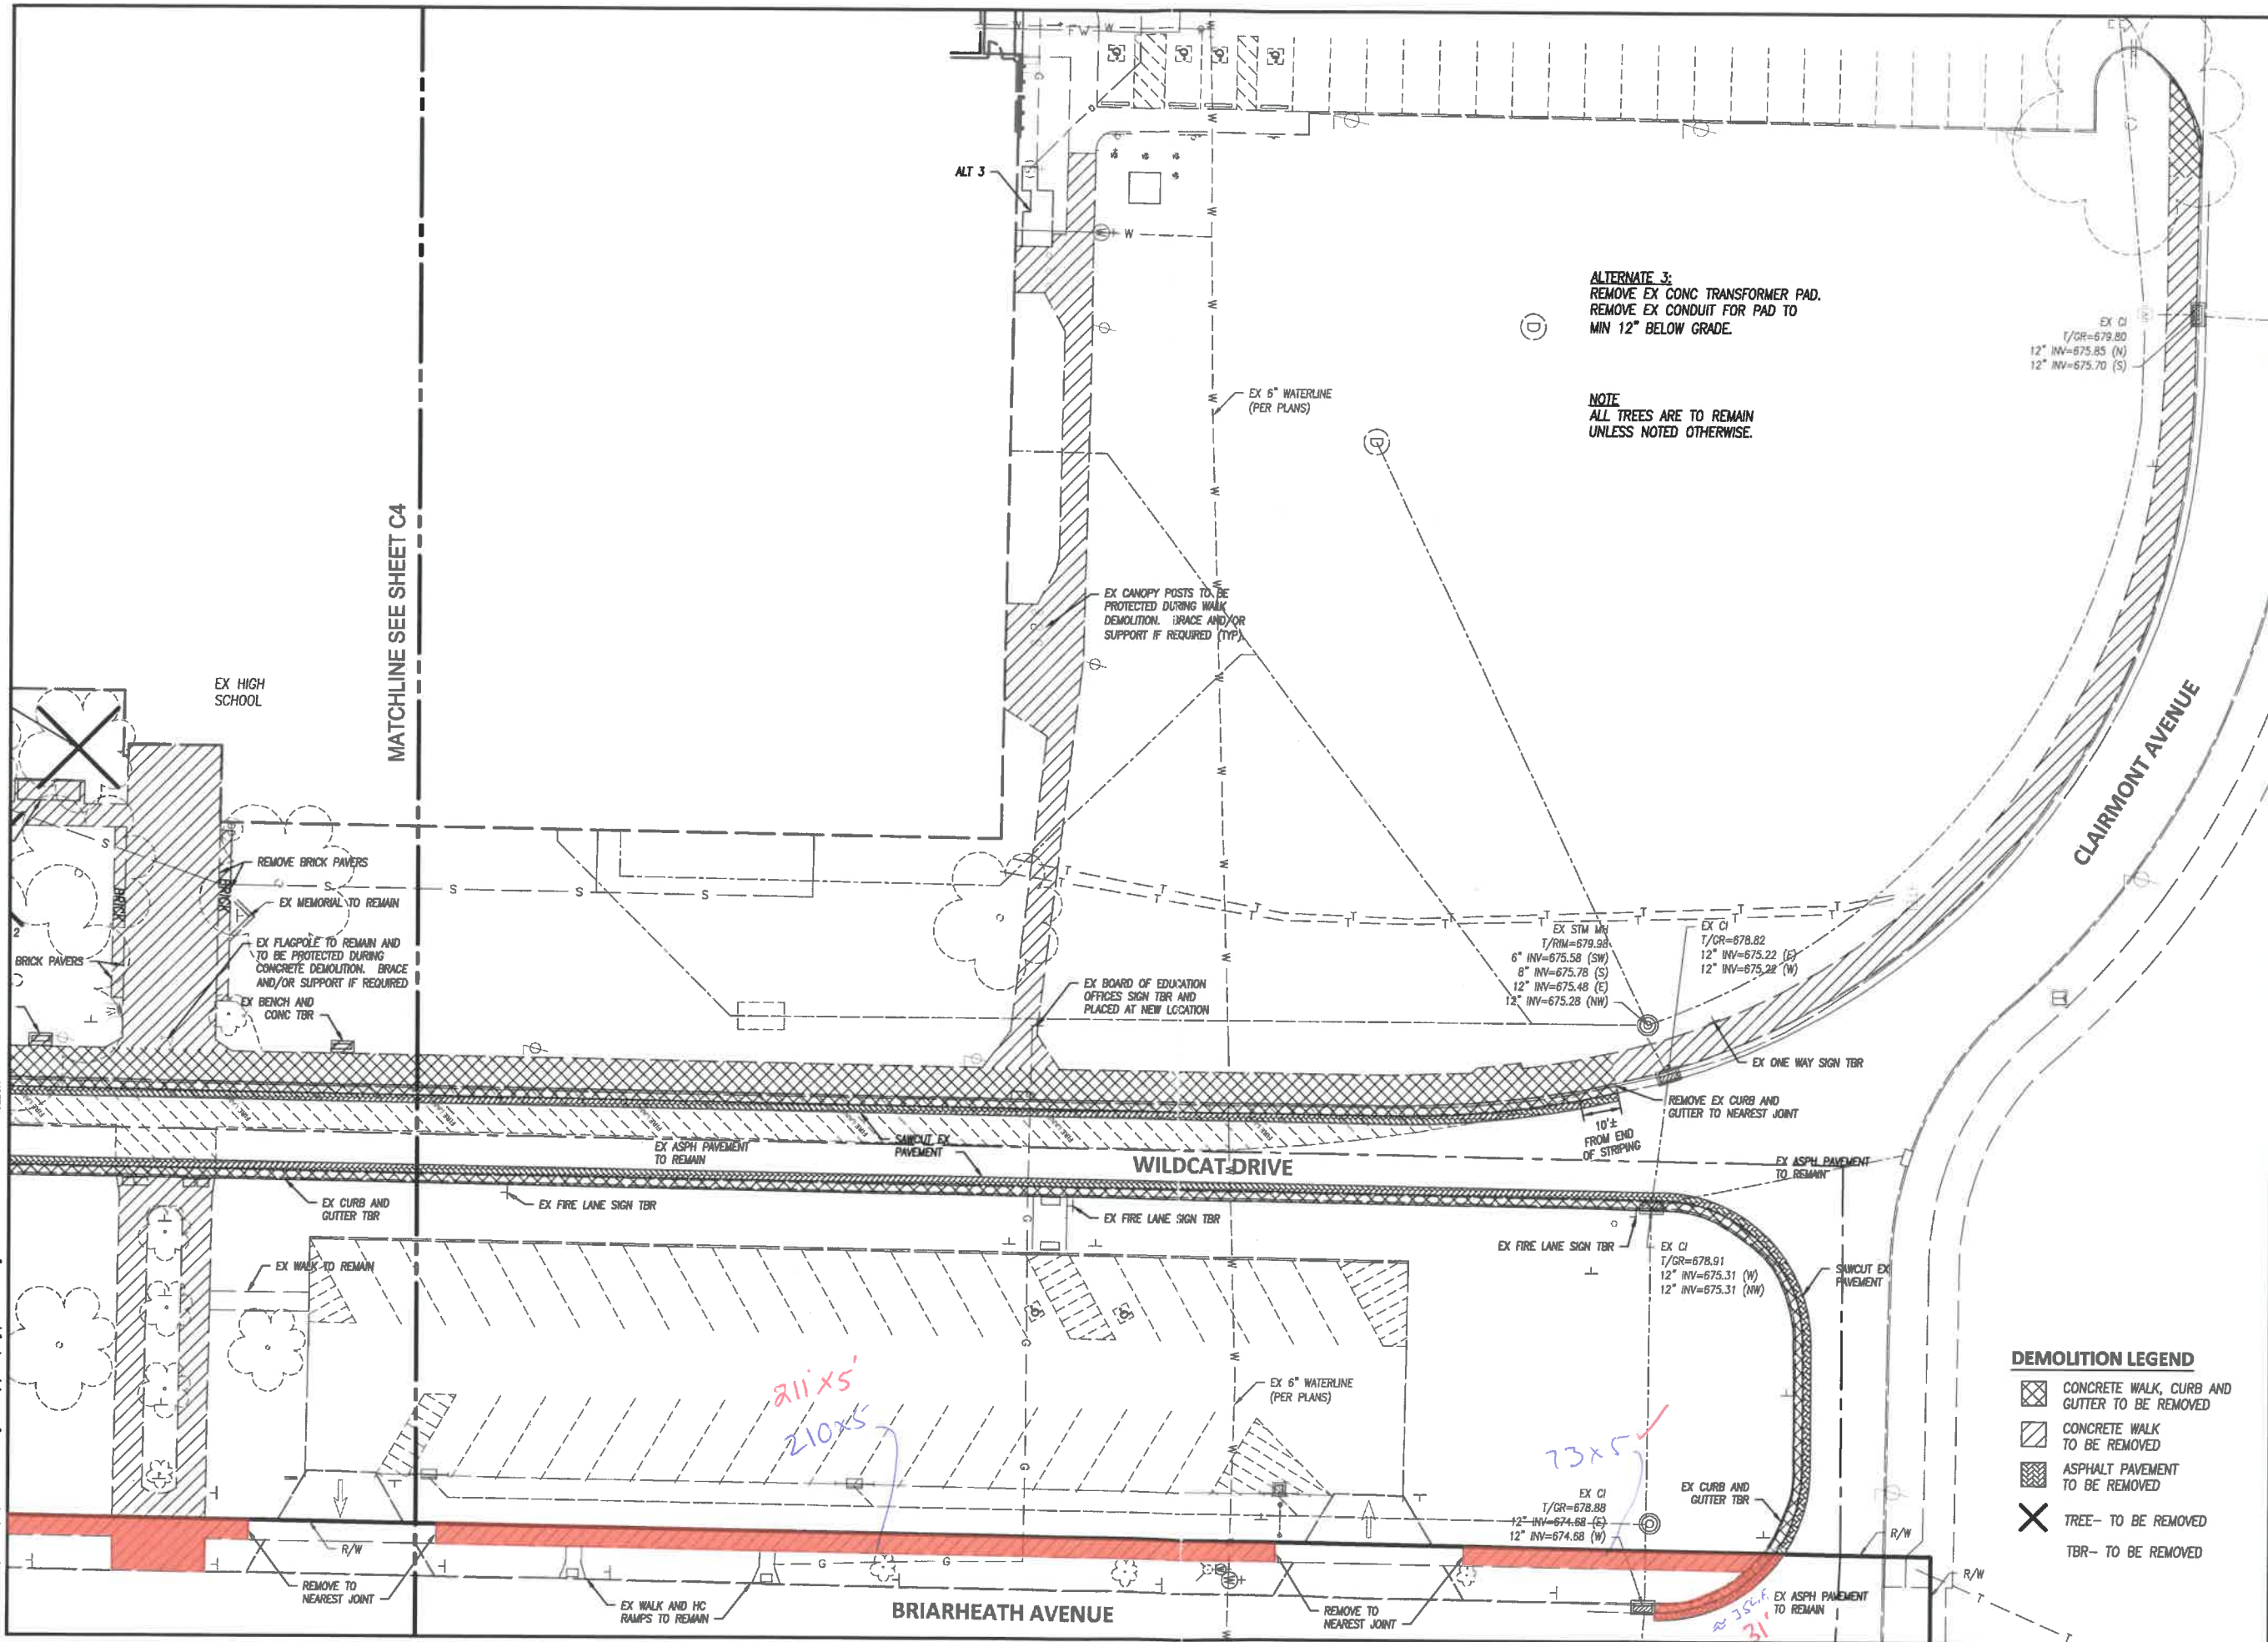

STATE OF OHIO
ROBERT W. BAILEY
E-82838
Professional Engineer
March 07, 2017

NO	REVISION	DATE
9		
8		
7		
6		
5		
4		
3		
2		
1		

DGL
DGL CONSULTING ENGINEERS, LLC
9455 BRIARFIELD BLVD, SUITE E
MAUMEE, OH 43537
PHONE: 419.333.1015
WWW.DGL-LLC.COM


**NAPOLEON AREA SCHOOLS
SIDEWALK RENOVATIONS**
701 BRIARHEATH AVE.
NAPOLEON, OHIO, 43545
HENRY COUNTY

MAIN ENTRANCE DEMO PLAN

FILE: 16119 CD.dwg
JOB NO.: 16119
DRAWN BY: EAH
ISSUED: FEB 10, 2017

C5

PLOTTED: Mar 07, 2017 - 4:23pm
 DRAWING: W:\16119 (Napoleon Jr-Sr High Walks)\Civil\Draw\16119 CD.dwg: C04 MAIN SOUTH DEMO NAPOLEON


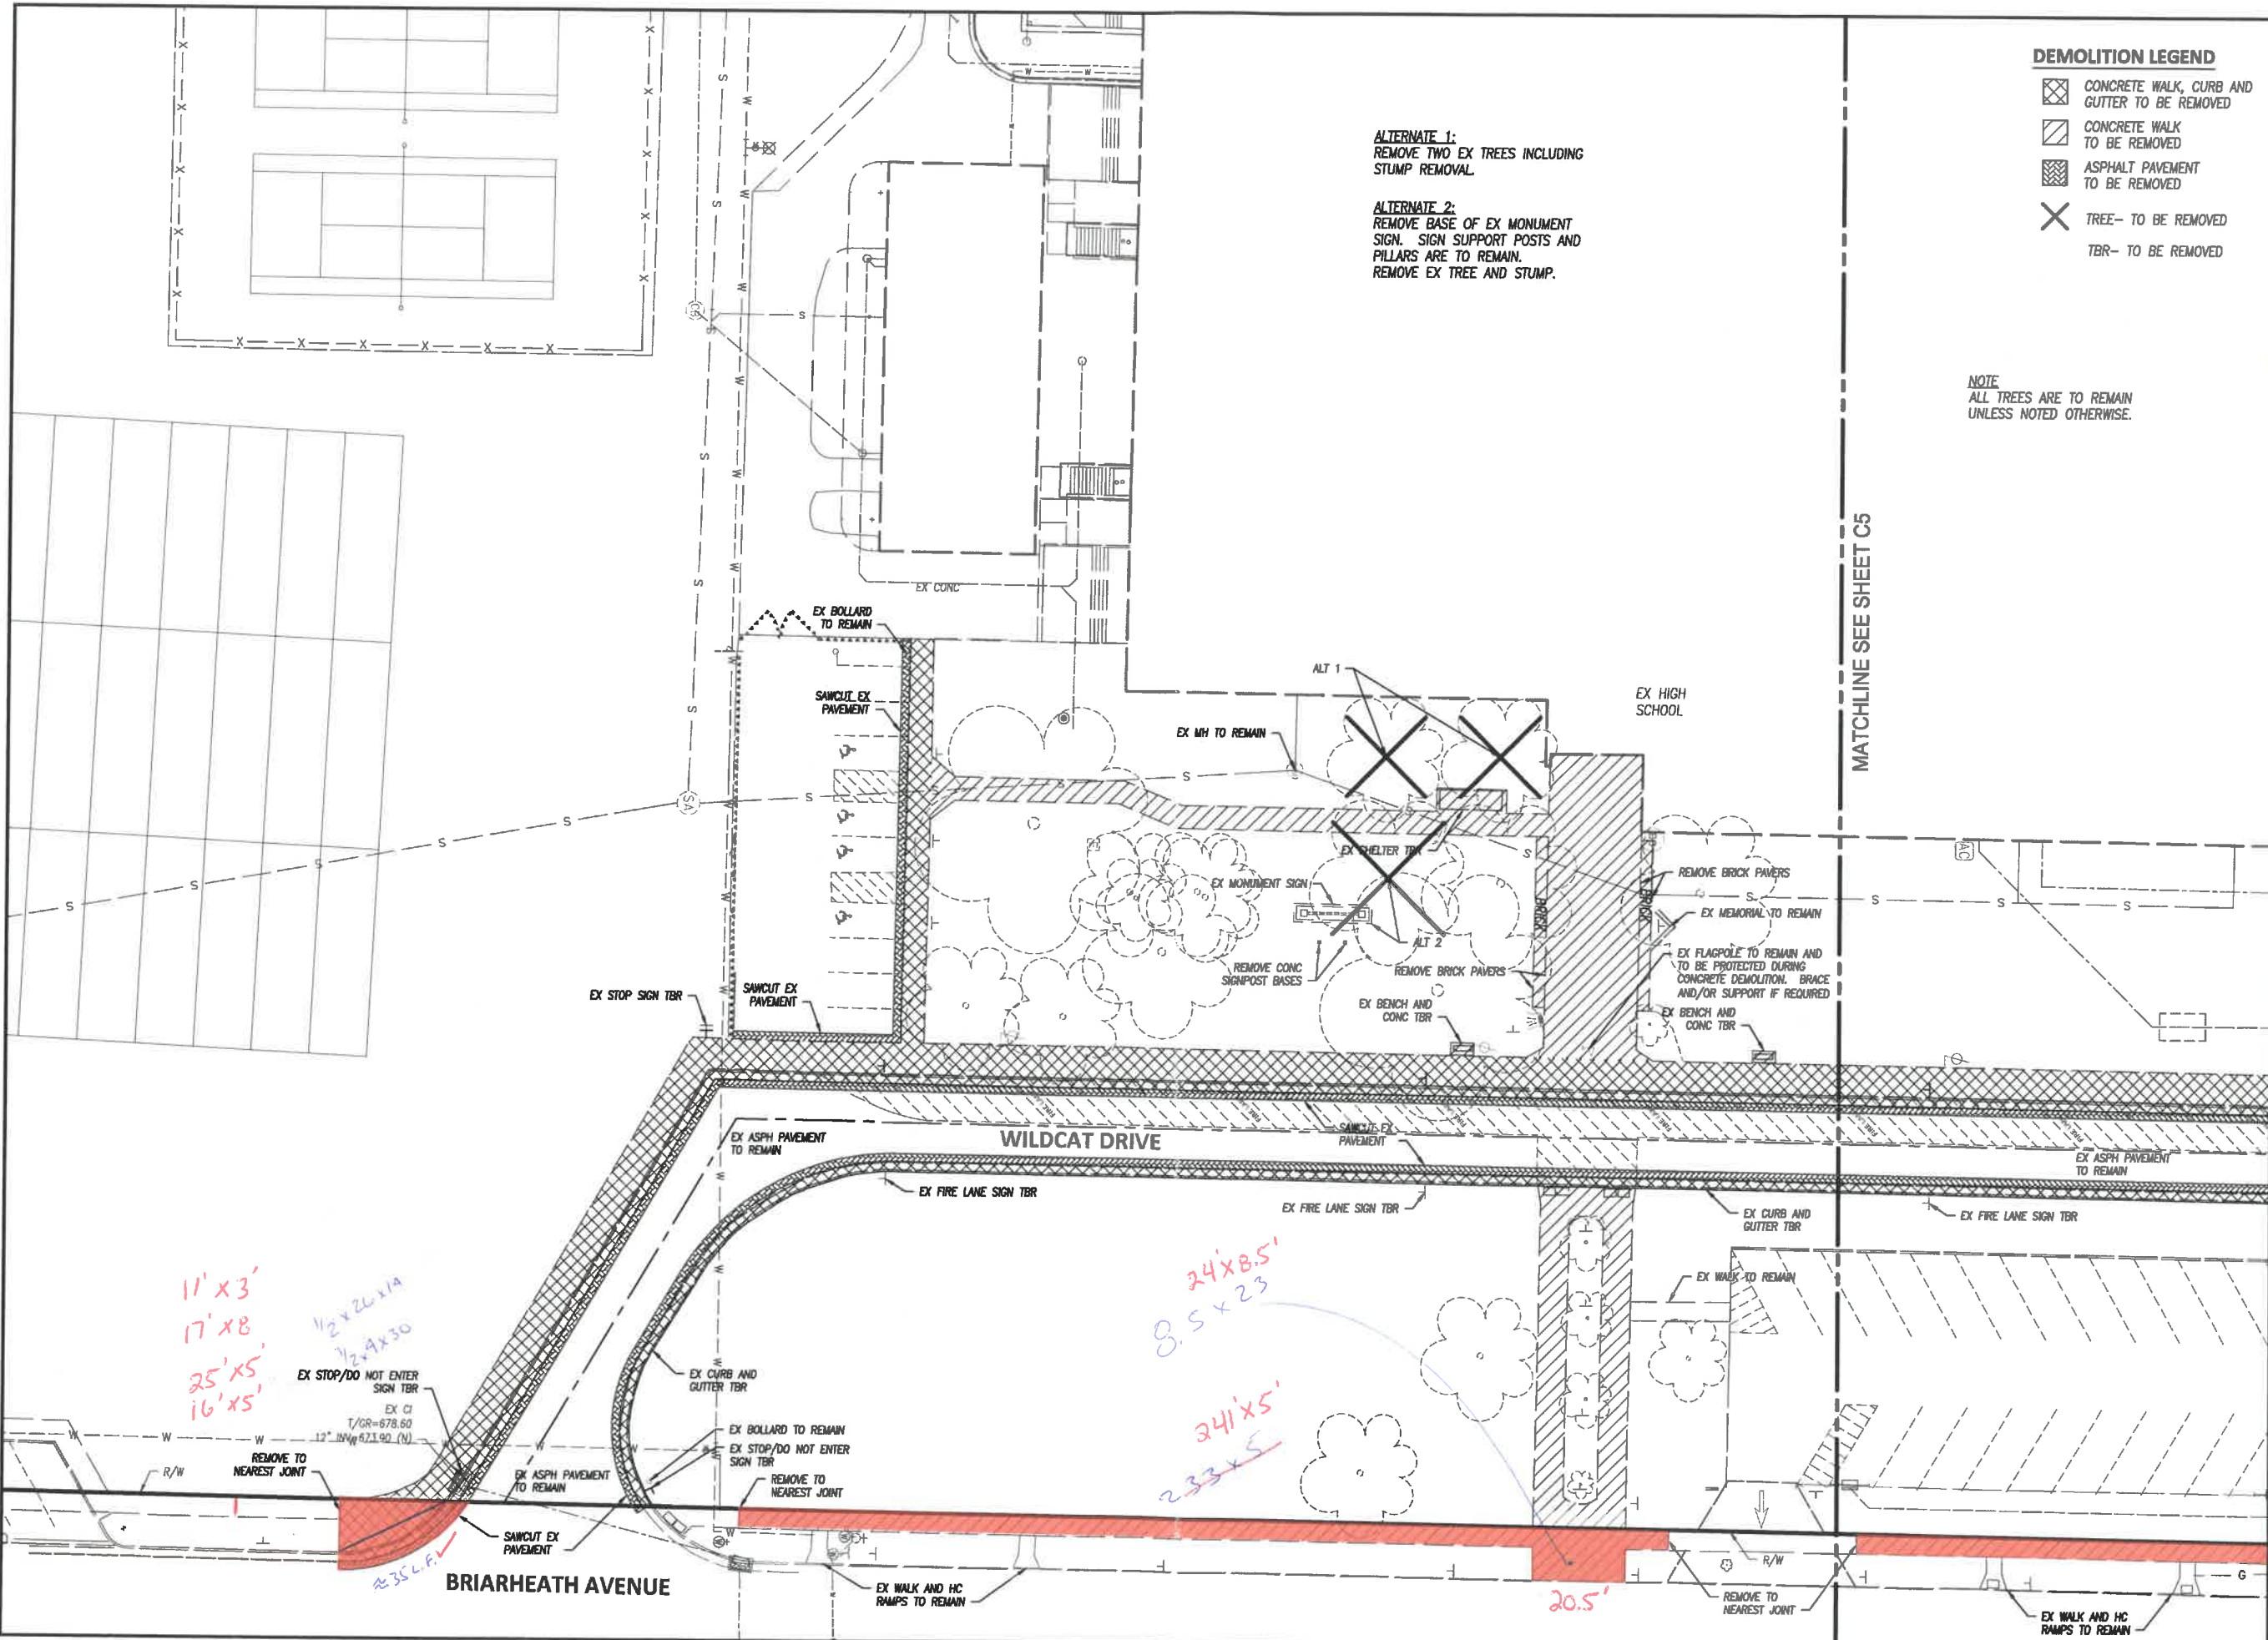


ALTERNATE 1:
 REMOVE TWO EX TREES INCLUDING STUMP REMOVAL.

ALTERNATE 2:
 REMOVE BASE OF EX MONUMENT SIGN. SIGN SUPPORT POSTS AND PILLARS ARE TO REMAIN. REMOVE EX TREE AND STUMP.

- DEMOLITION LEGEND**
- CONCRETE WALK, CURB AND GUTTER TO BE REMOVED
 - CONCRETE WALK TO BE REMOVED
 - ASPHALT PAVEMENT TO BE REMOVED
 - TREE- TO BE REMOVED
 - TBR- TO BE REMOVED

NOTE:
 ALL TREES ARE TO REMAIN UNLESS NOTED OTHERWISE.

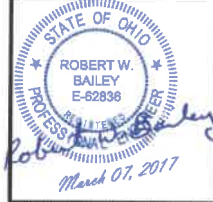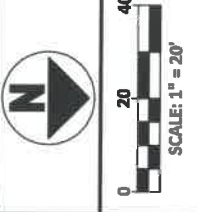

NO	REVISION	DATE
9		
8		
7		
6		
5		
4		
3		
2		
1		



**NAPOLEON AREA SCHOOLS
 SIDEWALK RENOVATIONS**
 701 BRIARHEATH AVE.
 NAPOLEON, OHIO, 43545
 HENRY COUNTY

FILE: 16119 CD.dwg
 JOB NO.: 16119
 DRAWN BY: EAH
 ISSUED: FEB 10, 2017

C4