

Print Date: 07/19/2017



City of Napoleon Building Department

255 W. Riverview
P.O. Box 151
Napoleon, OH 43545
Phone: (419) 592-4010
Fax: (419) 599-8393
Email:

Outside Sewer

Permit Number: P-17-0277
Expiration Date: 07/19/2018

Ms. Sandra Shumaker
655 Buckeye

Napoleon, OH 43545

Description:

\$0.00	Sewer Outside	0.00 Sewer Outside x \$0.0000
--------	---------------	-------------------------------

Building Permit Info

Project Description:	Replace Sanitary Sewer
Construction Value:	\$1,000.00

Mark B. Spess

Authorizing Signature

7-19-17

Date

CITY OF NAPOLEON ZONING PERMIT APPLICATION

THIS APPLICATION IS FOR RESIDENTIAL DEMOLITIONS, FENCES, POOLS, SHEDS,

DRIVEWAYS, SIDEWALKS & SEWERS

DATE 7-18-17 JOB LOCATION ⁶⁵⁵ ~~1055~~ Buckeye Lane

OWNER _____ TELEPHONE # _____

OWNER ADDRESS _____

CONTRACTOR Tressler Plumbing LLC CELL PHONE # 419-576-0302

DESCRIPTION OF WORK TO BE PERFORMED Sanitary sewer replacement

ESTIMATED COMPLETION DATE _____ ESTIMATED COST 1,000.00

DESCRIPTION	FEE	TOTAL COST
Demo Permit (100.3100.46690)	\$100.00	\$
Fence	\$25.00	\$
Pool	\$25.00	\$
Garage and Shed Under 200 SF (Detached)	\$25.00	\$
Driveway	0	\$
Sidewalk/Curbing	0	\$
Sewer Outside	0	\$ 0
Subtotal:		\$ 0
		\$
TOTAL FEE:		\$ 0

D-17-0277

I FULLY UNDERSTAND THAT NO EXCAVATION, CONSTRUCTION OR STRUCTURAL ALTERATION, ELECTRICAL OR MECHANICAL INSTALLATION OR ALTERATION OF ANY BUILDING STRUCTURE, SIGN, OR PART THEREOF AND NO USE OF THE ABOVE SHALL BE UNDERTAKEN OR PERFORMED UNTIL THE PERMIT APPLIED FOR HEREIN HAS BEEN APPROVED AND ISSUED BY THE CITY OF NAPOLEON BUILDING/ZONING DEPARTMENT.

I hereby certify that I am the Owner of the named property, or that the proposed work is authorized by the Owner of record and that I have been authorized by the Owner to make this application as his/her authorized agent and I agree to conform to all applicable laws of the jurisdiction. In addition, if a permit for Work described in this application is issued, I certify that the code official or the code official's authorized representative shall have the authority to enter areas covered by such permit at any reasonable hour to enforce the provisions of the code(s) applicable to such permit.

I HEREBY ACKNOWLEDGE THAT I HAVE READ AND FULLY UNDERSTAND THE ABOVE LISTED INSTRUCTIONS.

SIGNATURE OF APPLICANT: [Signature] DATE: _____

PRINT NAME: _____


BATCH #	CHECK #	DATE
---------	---------	------

655 BUCKEYE LANE
SANITARY SEWER LATERAL

DATE: 7-19-17

INSTALLED BY: TRESSLER PLUMBING

INSPECTED BY: MARTY CROSSLAND

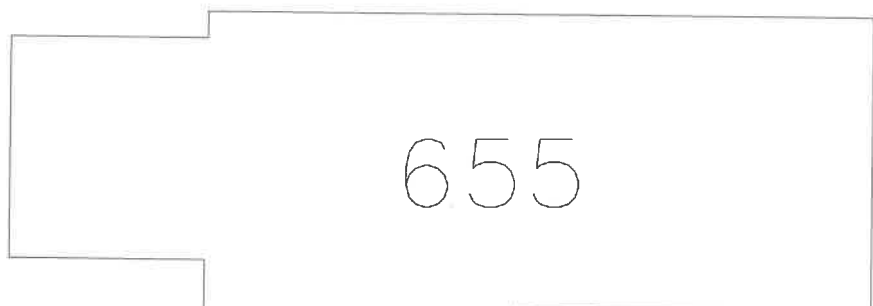

655

57'

42.5'

6" c/o
PVC

