

SEWER TAPPING PERMIT

Issued by

The City of Napoleon Engineering Dept.

255 West Riverview Ave. Napoleon, Ohio 43545 Pn. 592-4010

Entry No. _____

Permit No. 00415 Issued 9-17-92 Build. Permit No. _____

Job Location 950 Clairmont

Lot _____

Issued By BND sub div. or legal disc.

Owner Keith Sonnenberg

Address 950 Clairmont

Agent Jerry Glanz Pn. _____

Address Lakeview

Permit Fee \$ 25.00

Street Bond \$ _____

Date Paid 9-25-92

for office use only

WORK INFORMATION

Sanitary Sewer Tap _____ Size of Tap _____ Size and Type of Sewer _____ Street to be Opened _____
yes no

Storm Sewer Tap _____ Size of Tap _____ Size and Type of Sewer _____ Street to be Opened _____
yes no

Street opening Agreement Approval Date _____ Opening Bond Fee (Set by Engineer) _____

READ AND SIGN BELOW; The undersigned hereby agrees complete the work described above and to make use of said sewers only as allowed by and in strict accordance with all applicable provisions of The Napoleon Engineering Dept. Rules and Regulations, The Napoleon Standard Specification for Water Main, Sanitary Sewer and Storm Sewer Construction and other Pertinent Sections of the Napoleon Code of Ordinances.

Date _____ Signature of Applicant _____
Permit not valid without signature

INSPECTION RECORD _____ to be completed by the Field Inspector

Date Inspection is made _____ Size and Type of Sewer _____


Location _____ Depth _____ Type of Test _____ Additional Information _____

6" C/O installation.


Date 9-17-92 Inspected By Dwight R. Dorman
signature of inspector

Sketch Of Installation on Back or Attached

PAID
SEP 25 1992
CITY OF NAPOLEON

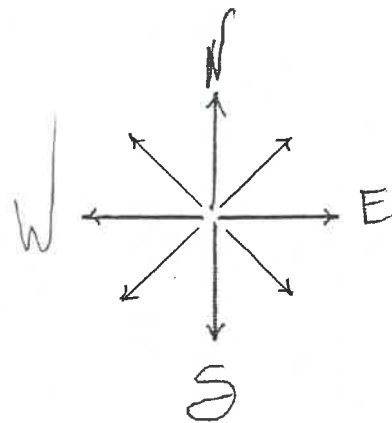

Date — 9-17-92
 Location — 950 Clairmont
 Owner — Keith Sonnberg
 Address — 950 Clairmont
 Contractor — Jerry Glanz
 Address — _____
 Work Discrip: sewer c/o
footertile

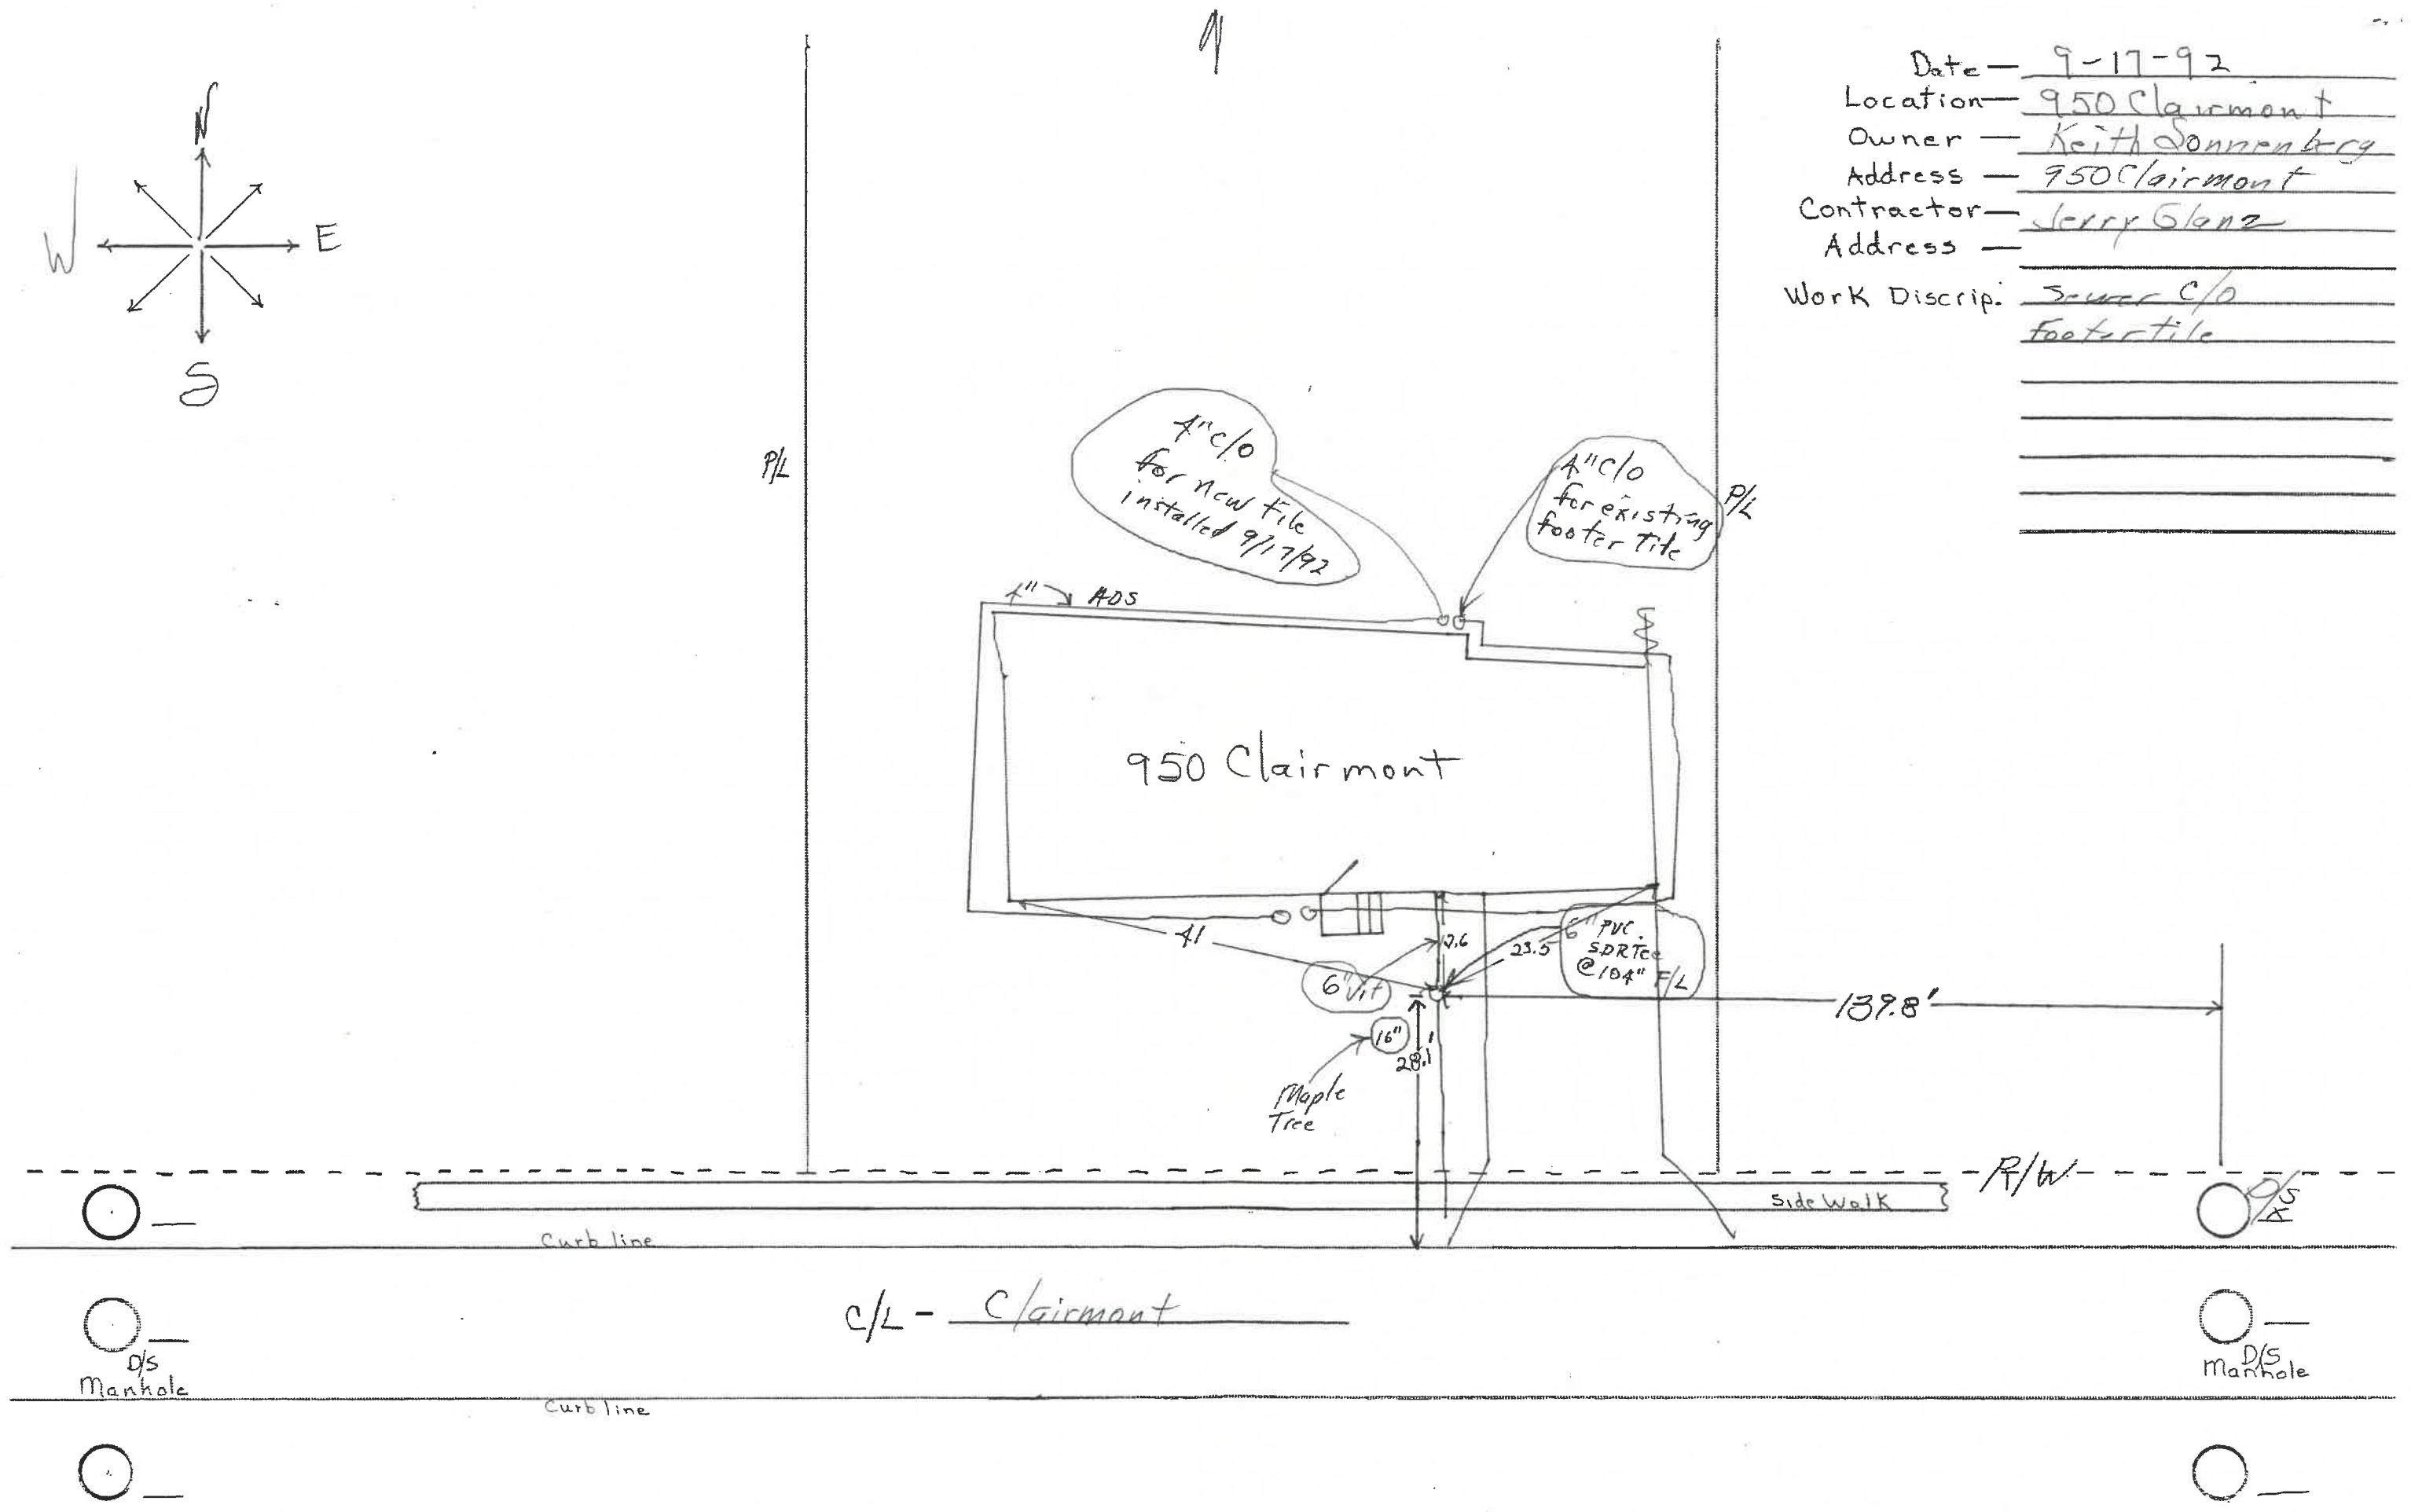

Place an X for the manhole applicable.