SCANNED

Print Date: 10/06/2017



City of Napoleon Building Department

255 W. Riverview P.O. Box 151 Napoleon, OH 43545 Phone: (419) 592-4010

Fax: (419) 599-8393

Email:



Outside Sewer

Permit Number:

P-17-0363

Expiration Date:

10/06/2018

Joshua Gerschutz

1080 Dodd

Napoleon, OH 43545

Description:

Building Permit Info

Project Description:

Sanitary Sewer Repair

Authorizing Signature


Date


CITY OF NAPOLEON ZONING PERMIT APPLICATION

THIS APPLICATION IS FOR RESIDENTIAL DEMOLITIONS, FENCES, POOLS, SHEDS, DRIVEWAYS, SIDEWALKS & SEWERS

DATE 9-30-16	JOB LOCATION	DODD STREET				
OWNER JOSHUA GERSCHUTZ TELEPHONE #						
	1080 DODD STREET					de de la companya de
	LESSIER PLUMBING					15
	VORK TO BE PERFORMED_					
ESTIMATED COMPLETION DATE 9-30-16 ESTIMATED COST						
DESCRIPTION			FEE	1	TOTAL COST	
Demo Permit		(100.3100.466	590) \$100.00	\$		
Fence			\$25.00	\$		
Pool			\$25.00	\$		- -
	Under 200 SF (Detached)		\$25.00	\$		
Driveway			0	\$		
Sidewalk/Curbing	2		0	\$		١
Sewer Outside			0	\$	0	
		Su	btotal:	\$	0	-
-				\$		
			TOTAL FEE:	\$	0	
	T NO EXCAVATION, CONSTRUCTION OF DING STRUCTURE, SIGN, OR PART THE EIN HAS BEEN APPROVED AND ISSUED					R TIL THE
I hereby certify that I am the Own application as his/her authorized	ner of the named property, or that the proposed w ogent and I agree to conform to all applicable la ial's authorized representative shall have the aut	ork is authorized by the Owner of record a	nd that I have been author	rized by	the Owner to make this	s tify that code(s)
I HEREBY ACKNOWLED	GE THAT I HAVE READ AND FULLY	Y UNDERSTAND THE ABOVE LI	STED INSTRUCTION	DNS.		
SIGNATURE OF APPLICAT		DA				
PRINT NAME:						
ВАТСН#	CHECK #	DA	TE			

1080 DODD STREET SANITARY SEWER INSTALLED BY: TRESSIER PLUMBING INSPECTED BY: MARTY CROSSLAND DATE: 9-30-16

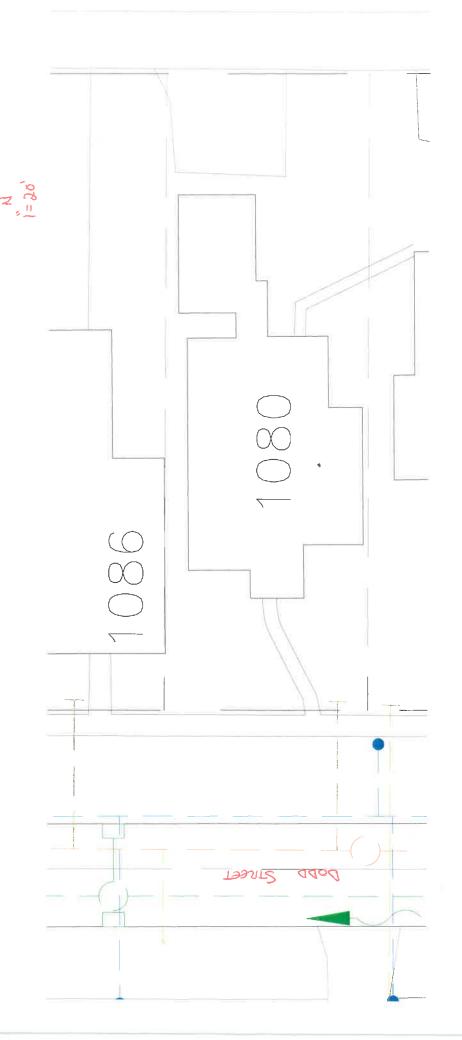

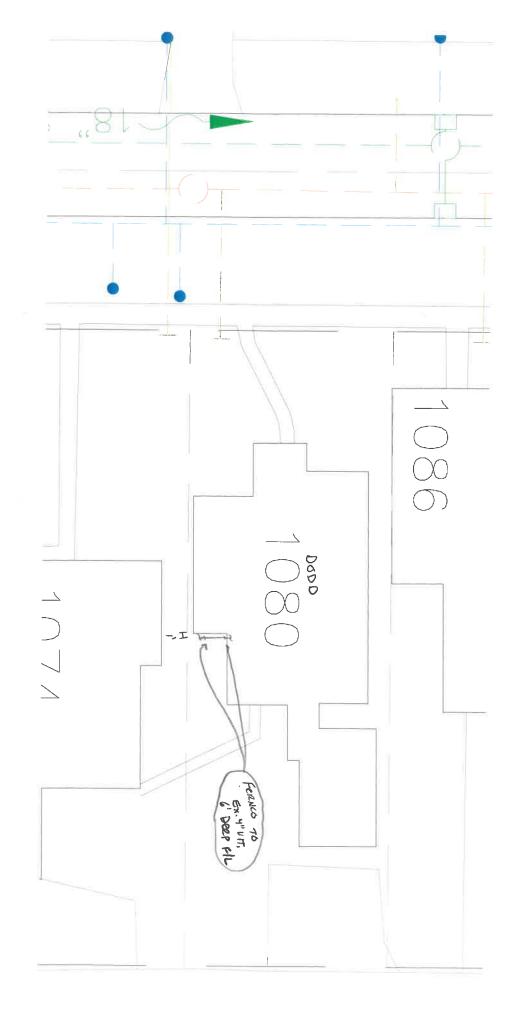

9-30-16 TRESSIER