

SEWER TAPPING PERMIT

Issued by

The City of Napoleon Engineering Dept.

255 West Riverview Ave. Napoleon, Ohio 43345 Pn. 592-4010

Entry No. _____

Permit No. SA0161

Issued _____

Build. Permit No. _____

Permit Fee \$ _____

Job Location 1002 Fairview

Street Bond \$ _____

Lot _____

Date Paid _____

Issued By B-D. sub div. or legal desc.Owner Marlow Witt Jr. Pn. 592-0606

Address _____

Agent Gerkens Inc. Pn. _____

Address _____

for office use only

WORK INFORMATION

Sanitary Sewer Tap Size of Tap 4" Size and Type of Sewer _____ Street to be Opened _____ yes no

Storm Sewer Tap _____ Size of Tap _____ Size and Type of Sewer _____ Street to be Opened _____ yes no

Street opening Agreement Approval Date _____ Opening Bond Fee (Set by Engineer) _____ yes no

READ AND SIGN BELOW; The undersigned hereby agrees complete the work described above and to make use of said sewers only as allowed by and in strict accordance with all applicable provisions of The Napoleon Engineering Dept. Rules and Regulations, The Napoleon Standard Specification for Water Main, Sanitary Sewer and Storm Sewer Construction and other Pertinent Sections of the Napoleon Code of Ordinances.

Date 12/17/90Signature of Applicant Marlow Witt

Permit not valid without signature

INSPECTION RECORD


to be completed by the Field Inspector

Date Inspection is made _____ Size and Type of Sewer _____

Location _____ Depth _____ Type of Test _____ Additional Information _____

Date _____ Inspected By _____
signature of inspector

Sketch Of Installation on Back or Attached

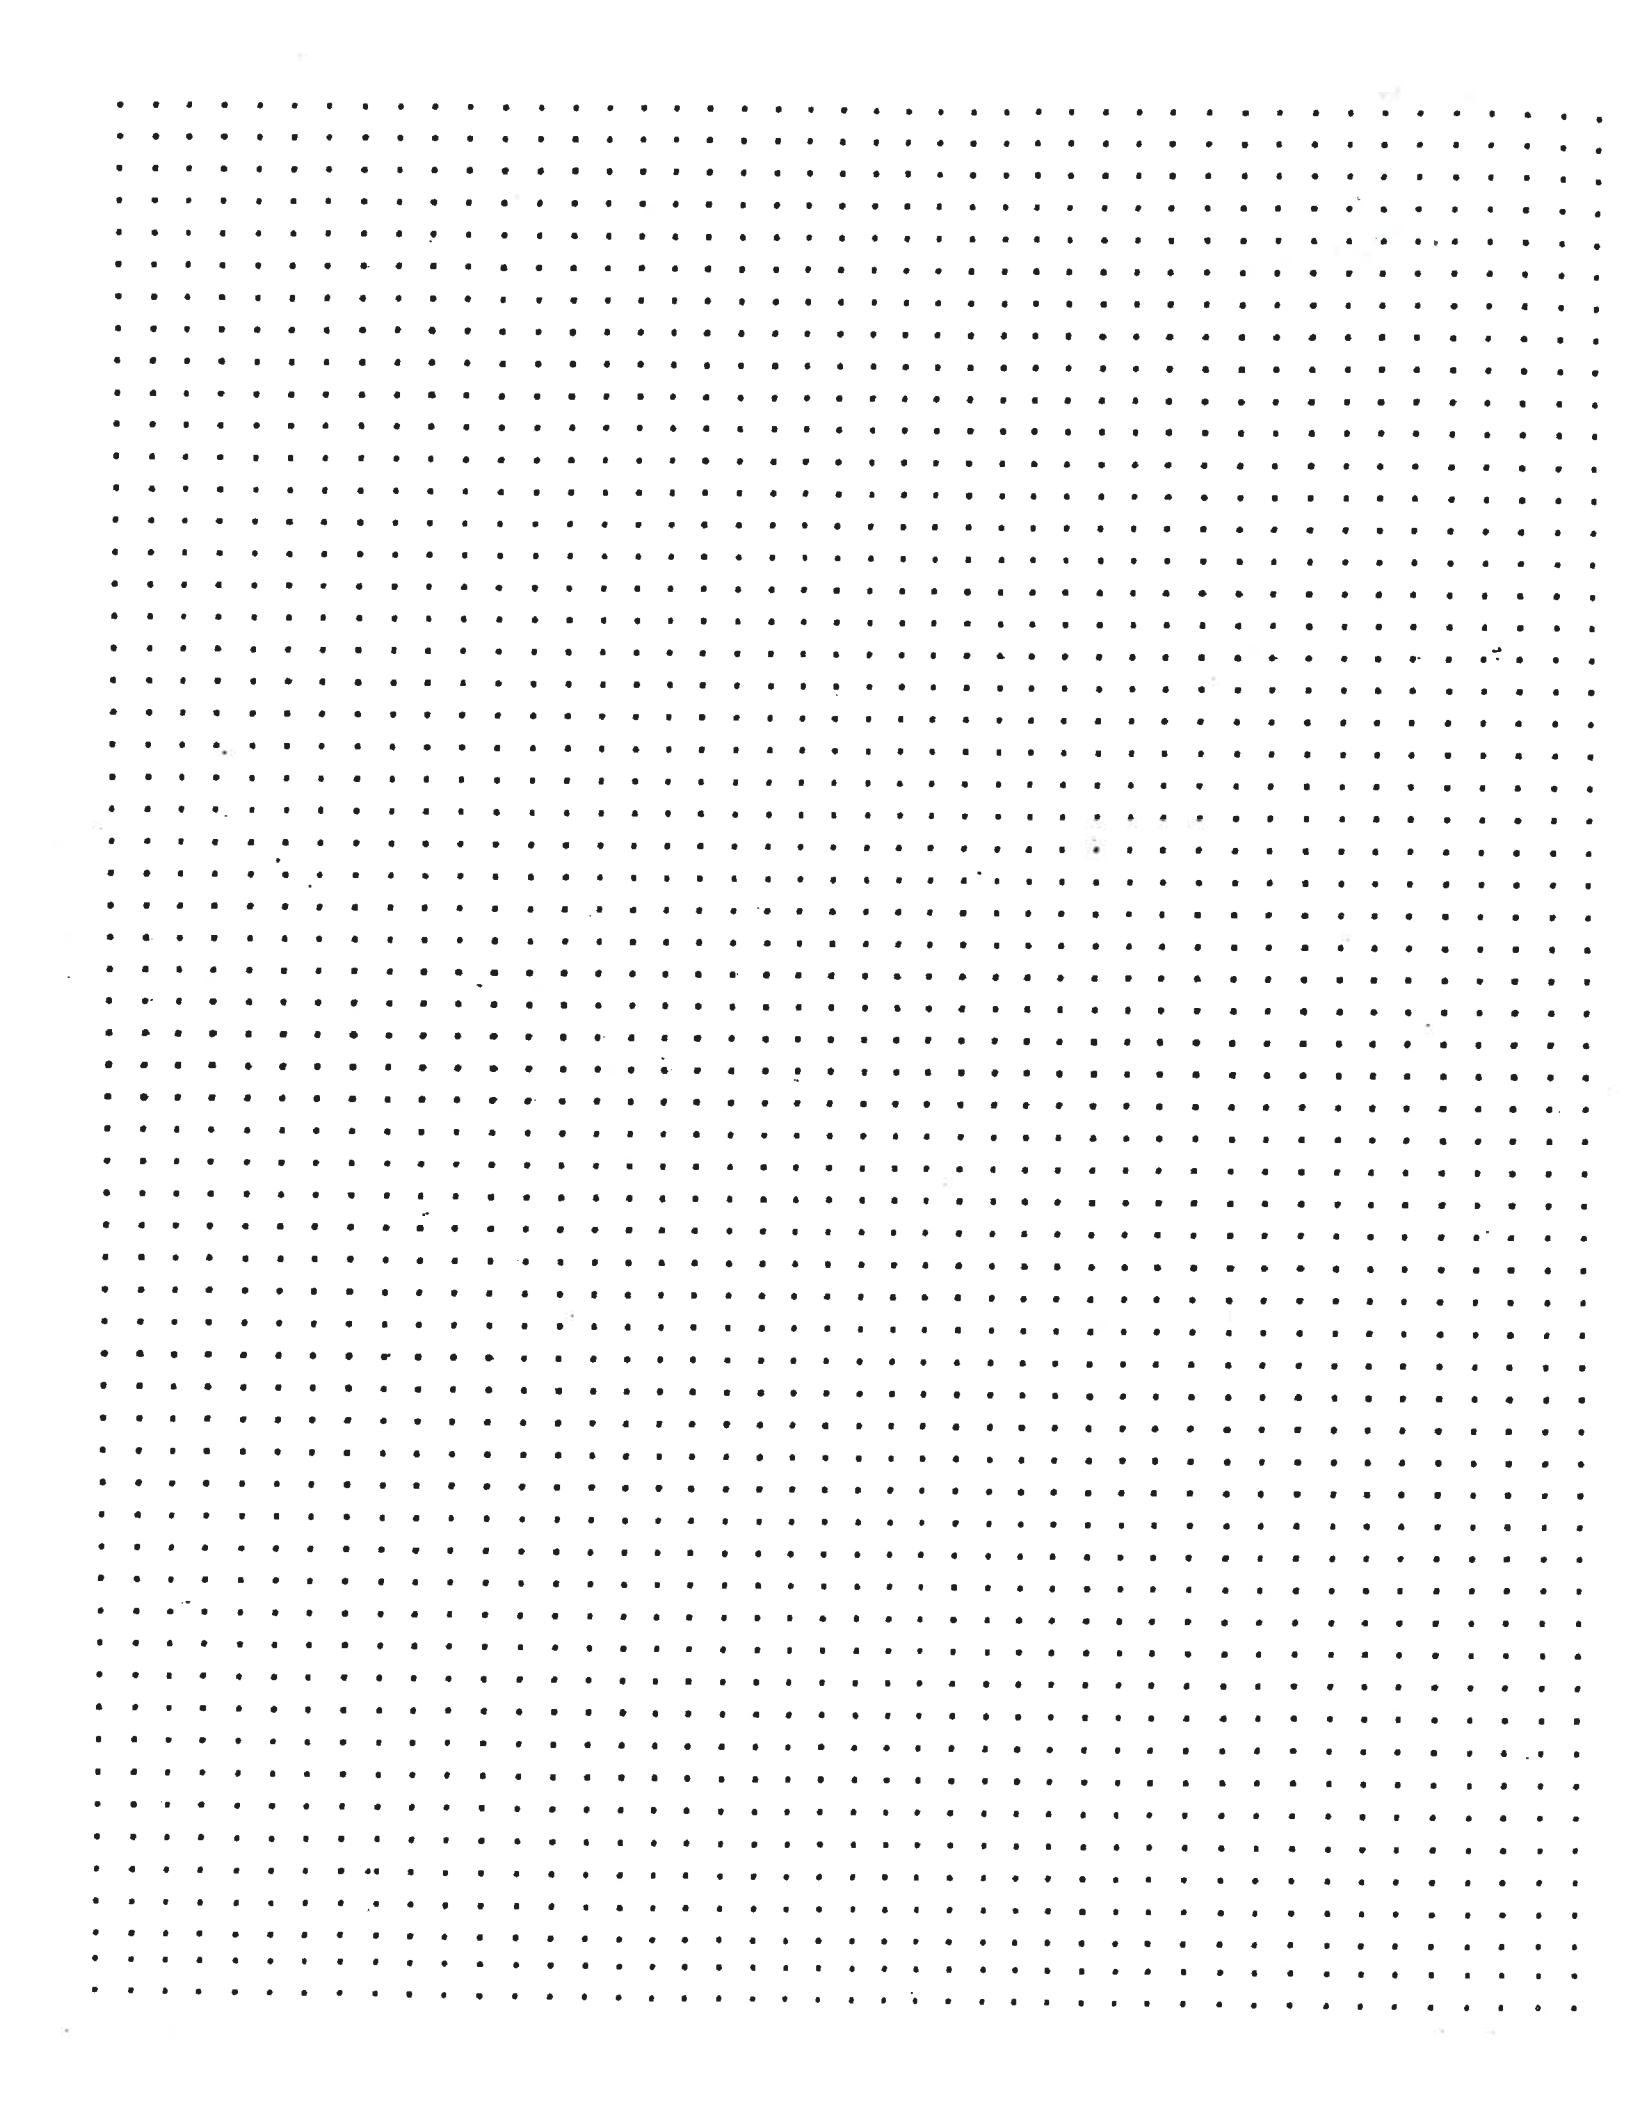


SAO 161

Marlow W.H.

C.O. 5° out

N

Contractor
Geschenk Paving
3-5-91

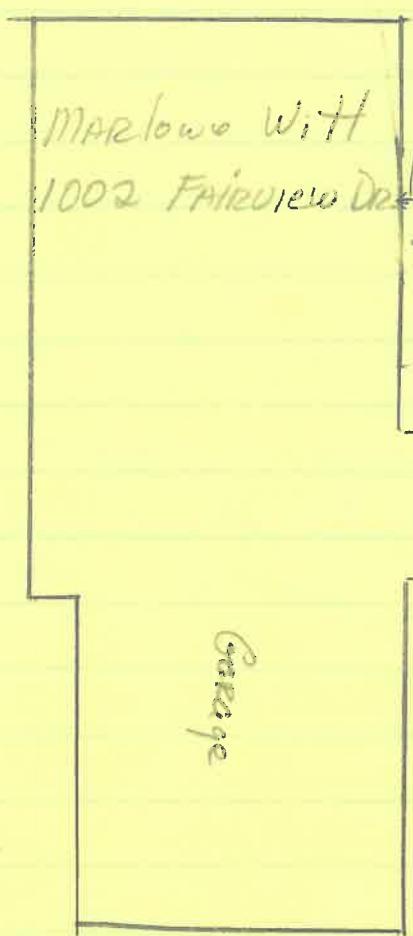

15' 22"

6.5' DEEP @ House

6" SPR. 35 P.U.C.

conv. made
11.0' Deep

Downstream
Manhole

19.5'

18" City Interceptor

By Malcolm Helberg

1002 Fairview

