

SEWER TAPPING PERMIT

Issued by

The City of Napoleon Engineering Dept.

255 West Riverview Ave. Napoleon, Ohio 43545 Pn. 592-4010

Entry No. _____

Permit No. _____ Issued _____ Build. Permit No. _____

Permit Fee \$ None

Job Location 1025 Fairview Dr

Street Bond \$ _____

Lot 17

Date Paid _____

Issued By Malcolm Helberg sub div. or legal disc.

Owner John Mohler Pn. _____

Address 1025 Fairview Dr.

Agent Jerry Glanz Pn. _____

Address Lakeview Dr

for office use only

WORK INFORMATION

Sanitary Sewer Tap yes no Size of Tap 4 Size and Type of Sewer 4 Street to be Opened yes no

Storm Sewer Tap yes no Size of Tap _____ Size and Type of Sewer _____ Street to be Opened yes no

Street opening Agreement Approval Date _____ Opening Bond Fee (Set by Engineer) _____

READ AND SIGN BELOW; The undersigned hereby agrees complete the work described above and to make use of said sewers only as allowed by and in strict accordance with all applicable provisions of The Napoleon Engineering Dept. Rules and Regulations, The Napoleon Standard Specification for Water Main, Sanitary Sewer and Storm Sewer Construction and other Pertinent Sections of the Napoleon Code of Ordinances.

Date 3-12-91 Signature of Applicant Jerry Glanz
Permit not valid without signature


INSPECTION RECORD _____ to be completed by the Field Inspector

Date Inspection is made 3-18-91 Size and Type of Sewer 4" P.V.C.

Location _____ Depth _____ Type of Test _____ Additional Information _____

Date 3-18-91 Inspected By Malcolm Helberg
signature of inspector

Sketch Of Installation on Back or Attached

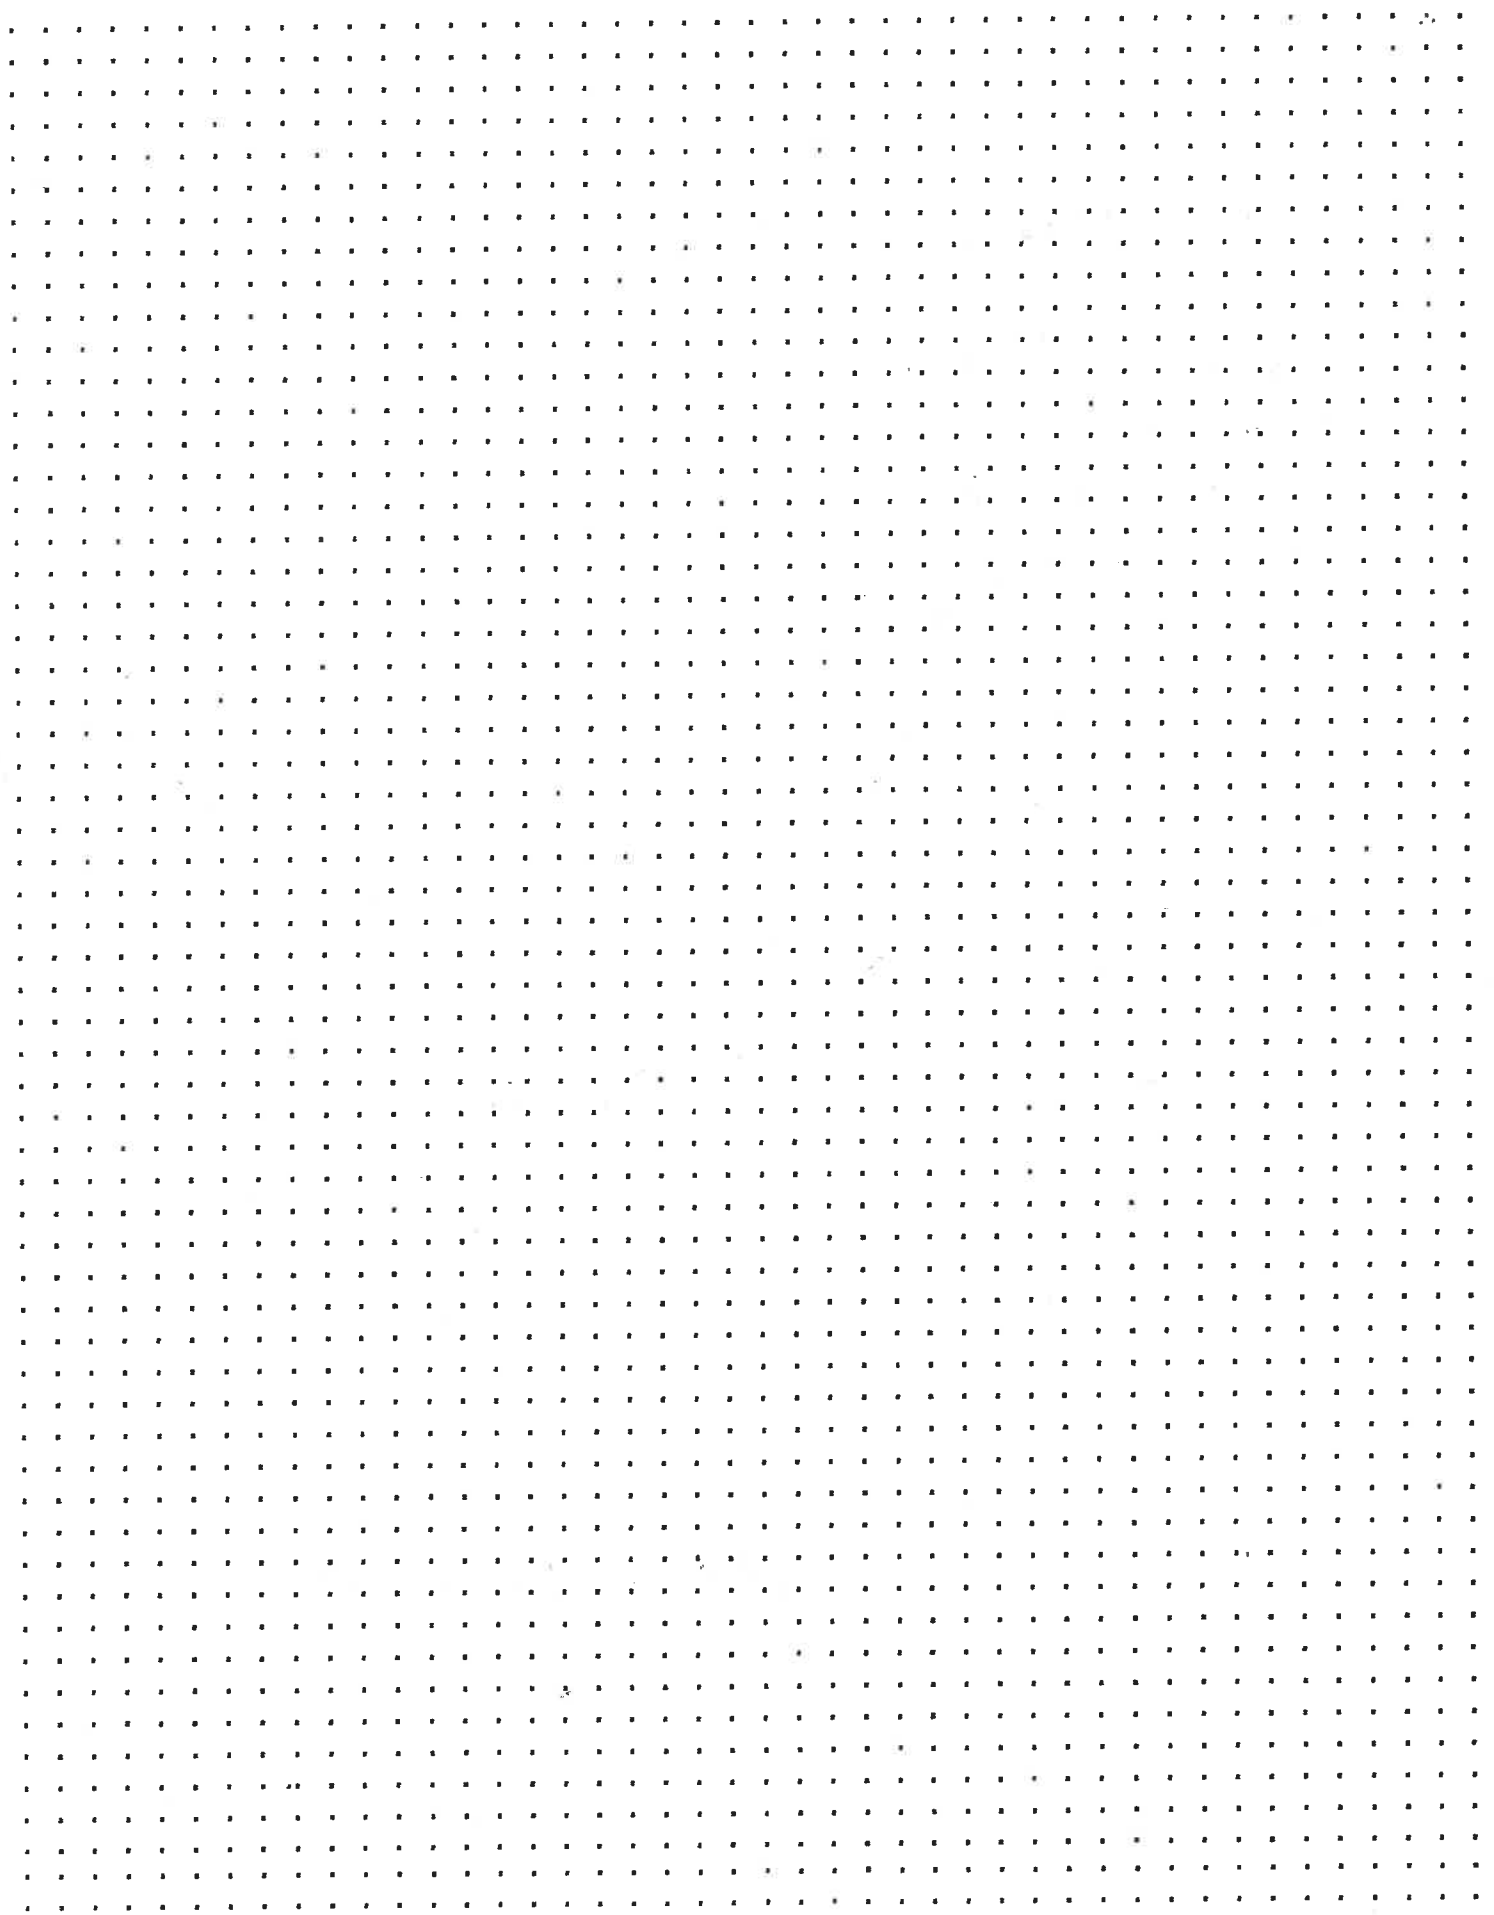


3-14-91

Contractor JERRY GLANTZ

Owner John Mohler

1025 Fairview Dr

C.O. 2' deep

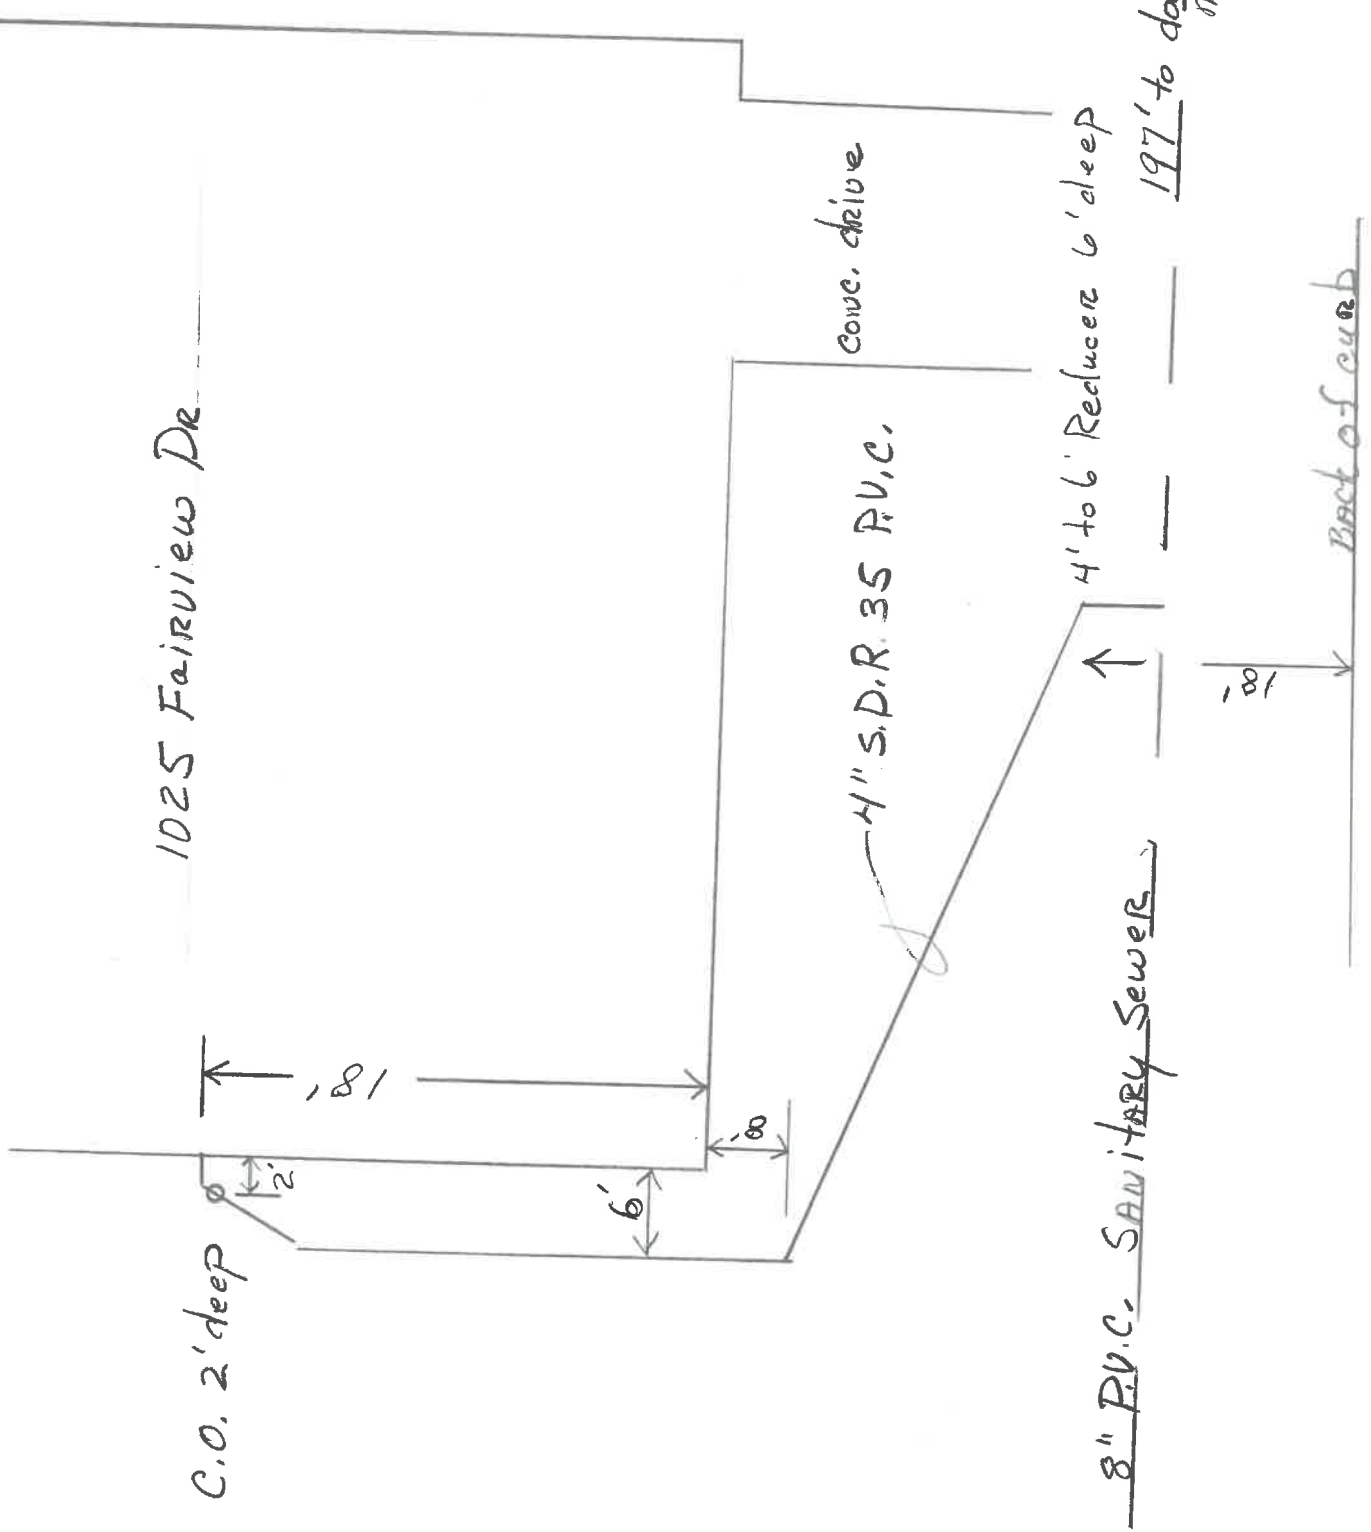

concrete drive

4" S.D.R. 35 R.V.C.

4' to 6' Reducer 6' deep

8" P.V.C. SANITARY SEWER

197' to downstream Manhole

Back of curb

