

SEWER TAPPING PERMIT
 Issued by
 The City of Napoleon Engineering Dept.
 233 West Riverview Ave. Napoleon, Ohio 43345 Pn. 392-4010

DR 35
P. C.

Reducer 7.7' deep
P. C. SANITARY
MAIN

Entry No. _____
 Permit No. SA0169 Issued 4-3-91 Build. Permit No. _____

Job Location 1037 Fairview Dr.


Lot _____ sub div. or legal disc. _____
 Issued By _____

Owner Walter Hoy Pn. _____

Address 1037 Fairview Dr.

Agent Mort Cordes Pkg Pn. _____

Address _____

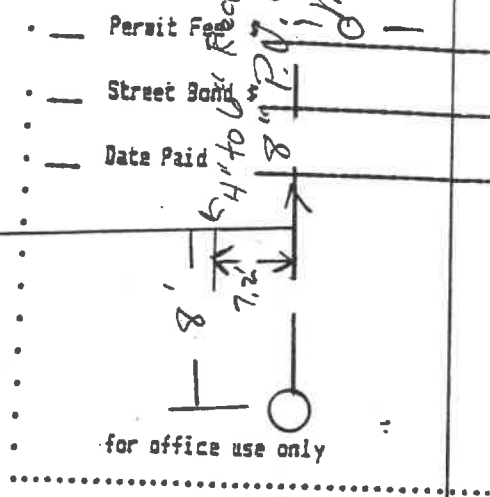

WORK INFORMATION

Sanitary Sewer Tap yes no Size of Tap 6" Size and Type of Sewer 4" S.D.R.35 Street to be Opened yes no
 Storm Sewer Tap yes no Size of Tap _____ Size and Type of Sewer _____ Street to be Opened yes no
 Street opening Agreement Approval Date _____ Opening Bond Fee (Set by Engineer) yes no

READ AND SIGN BELOW; The undersigned hereby agrees complete the work described above and to make use of said sewers only as allowed by and in strict accordance with all applicable provisions of The Napoleon Engineering Dept. Rules and Regulations, The Napoleon Standard Specification for Water Main, Sanitary Sewer and Storm Sewer Construction and other Pertinent Sections of the Napoleon Code of Ordinances.

Date 4-3-91 Signature of Applicant Walter Hoy

Permit not valid without signature

Contractor: Mort Cordes Pkg
4-3-91

INSPECTION RECORD

Date Inspection is made 4-3-91 Size and Type of Sewer See back
 Location See back Type of Test _____ Additional Information _____

Date 4-3-91 Inspected By Malcom Helberg
 signature of inspector

Sketch Of Installation on Back or Attached

Septic Tank pumped
filled pipe
holed through
8'

1037 FAIRVIEW DRIVE