

PERMIT

City of Napoleon
255 W. Riverview
Napoleon, OH 43545

Division of Building and Zoning
PH (419) 592-4010
FAX (419) 599-8393

Permit No: 002042

Date Issued: 03-02-04

Issued by: BND

Job Location: 529 FREEDOM DRIVE

Est. Cost:

Lot #:

Subdivision Name:

Owner: GILSON MACHINE & TOOL INC
Address: 529 FREEDOM DRIVE
CSZ: NAPOLEON, OH 43545
Phone: 419-592-2911

Agent: DC PLUMBING, LLC
Address: 8229 CO RD U-3
CSZ: LIBERTY CENTER, OH 435
Phone: 419-533-8881

Use Type - Residential:

Other:

ZONING INFORMATION

Dist: Lot Dim: Area: Fyrd: Syrd: Ryrd:
Max HT: # Pkg Spaces: # Loading SP: Max Lot Cov:

BOARD OF ZONING APPEALS:

Work Type - New: Replmnt: Addn'n: Alter: Remodel:

WORK INFORMATION

Size - Lgth: Width: Stories: Living Area SF:
Garage Area SF: Height: Bldg Vol Demo Permit:

WORK DESCRIPTION
SEWER INSPECTION


FEE DESCRIPTION PAID DATE FEE AMOUNT DUE
SEWER INSPECTION PER 110.00

Total Fees Due 110.00



3-2-04
Date

J. Franz
Applicant Signature

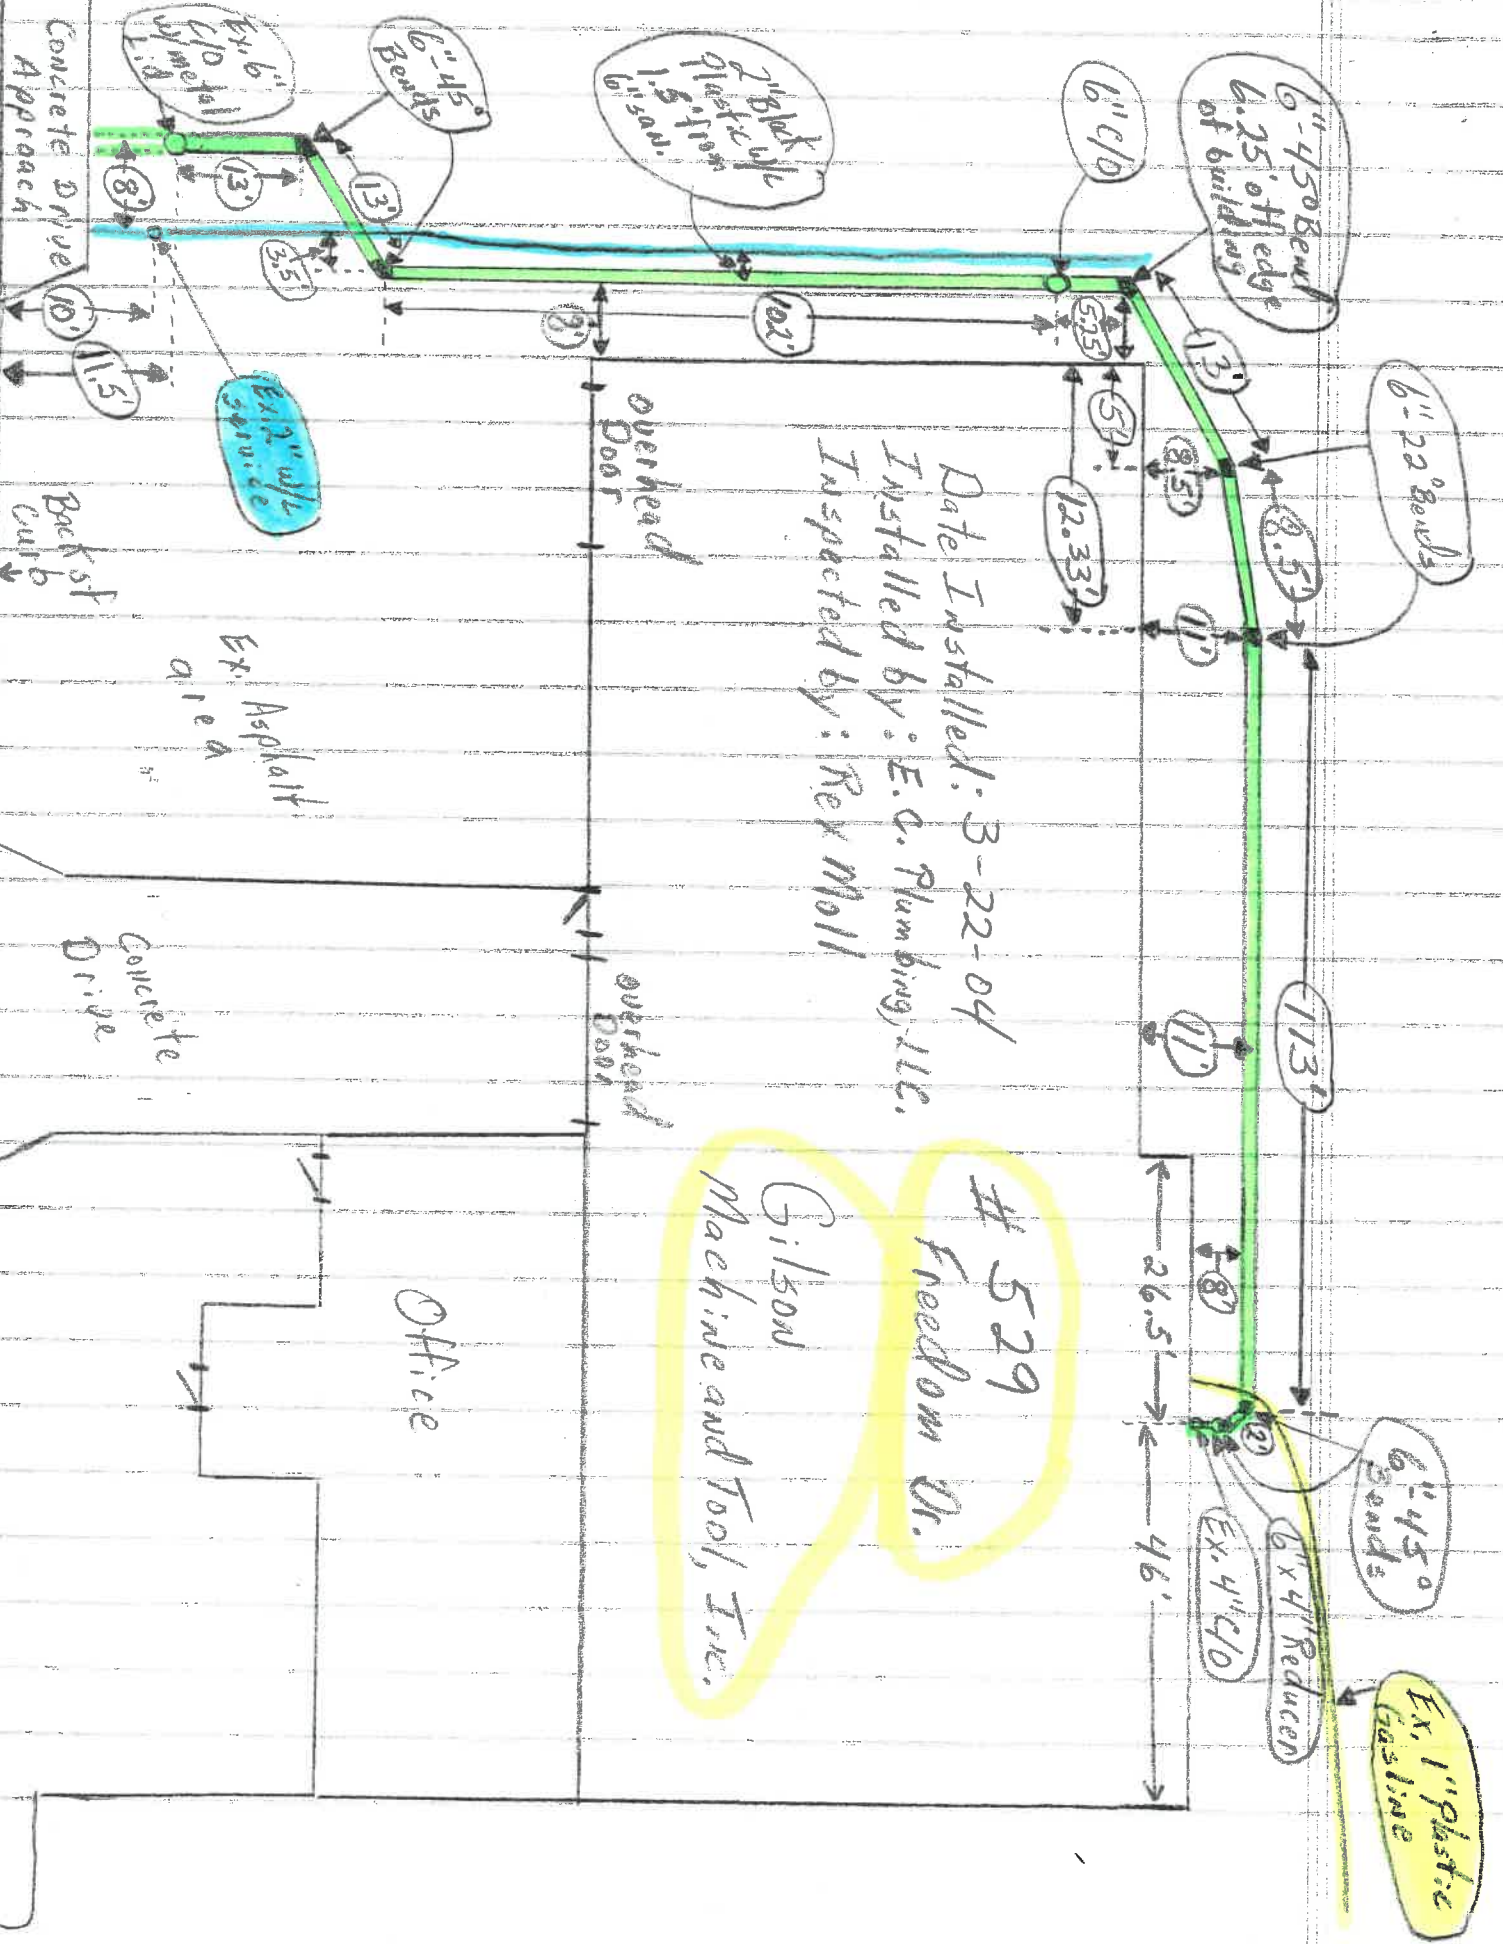

Date Installed: 3-22-04
 Installed by: E.C. Plumbing, LLC.
 Inspected by: Rex Moll

529
 Freedom Dr.
 Gilson
 Machine and Tool, Inc.

Ex. Asphalt
 area

Office

Ex. 1" Plastic
 Fittings

Concrete Drive Approach

Back St
 Concrete Drive

Overhead
 Door

Overhead
 Door

6" 450 Bends
 6.25" H edge
 of building

6" 22 Bends

6" 450
 Bends


6" x 4" Reducer
 Ex. 4" C/O


6" C/O

2" Black w/c
 Plastic w/c
 1.5" diam.

6" 45
 Bends

Ex. 6"
 C/O w/c
 1.5" diam.

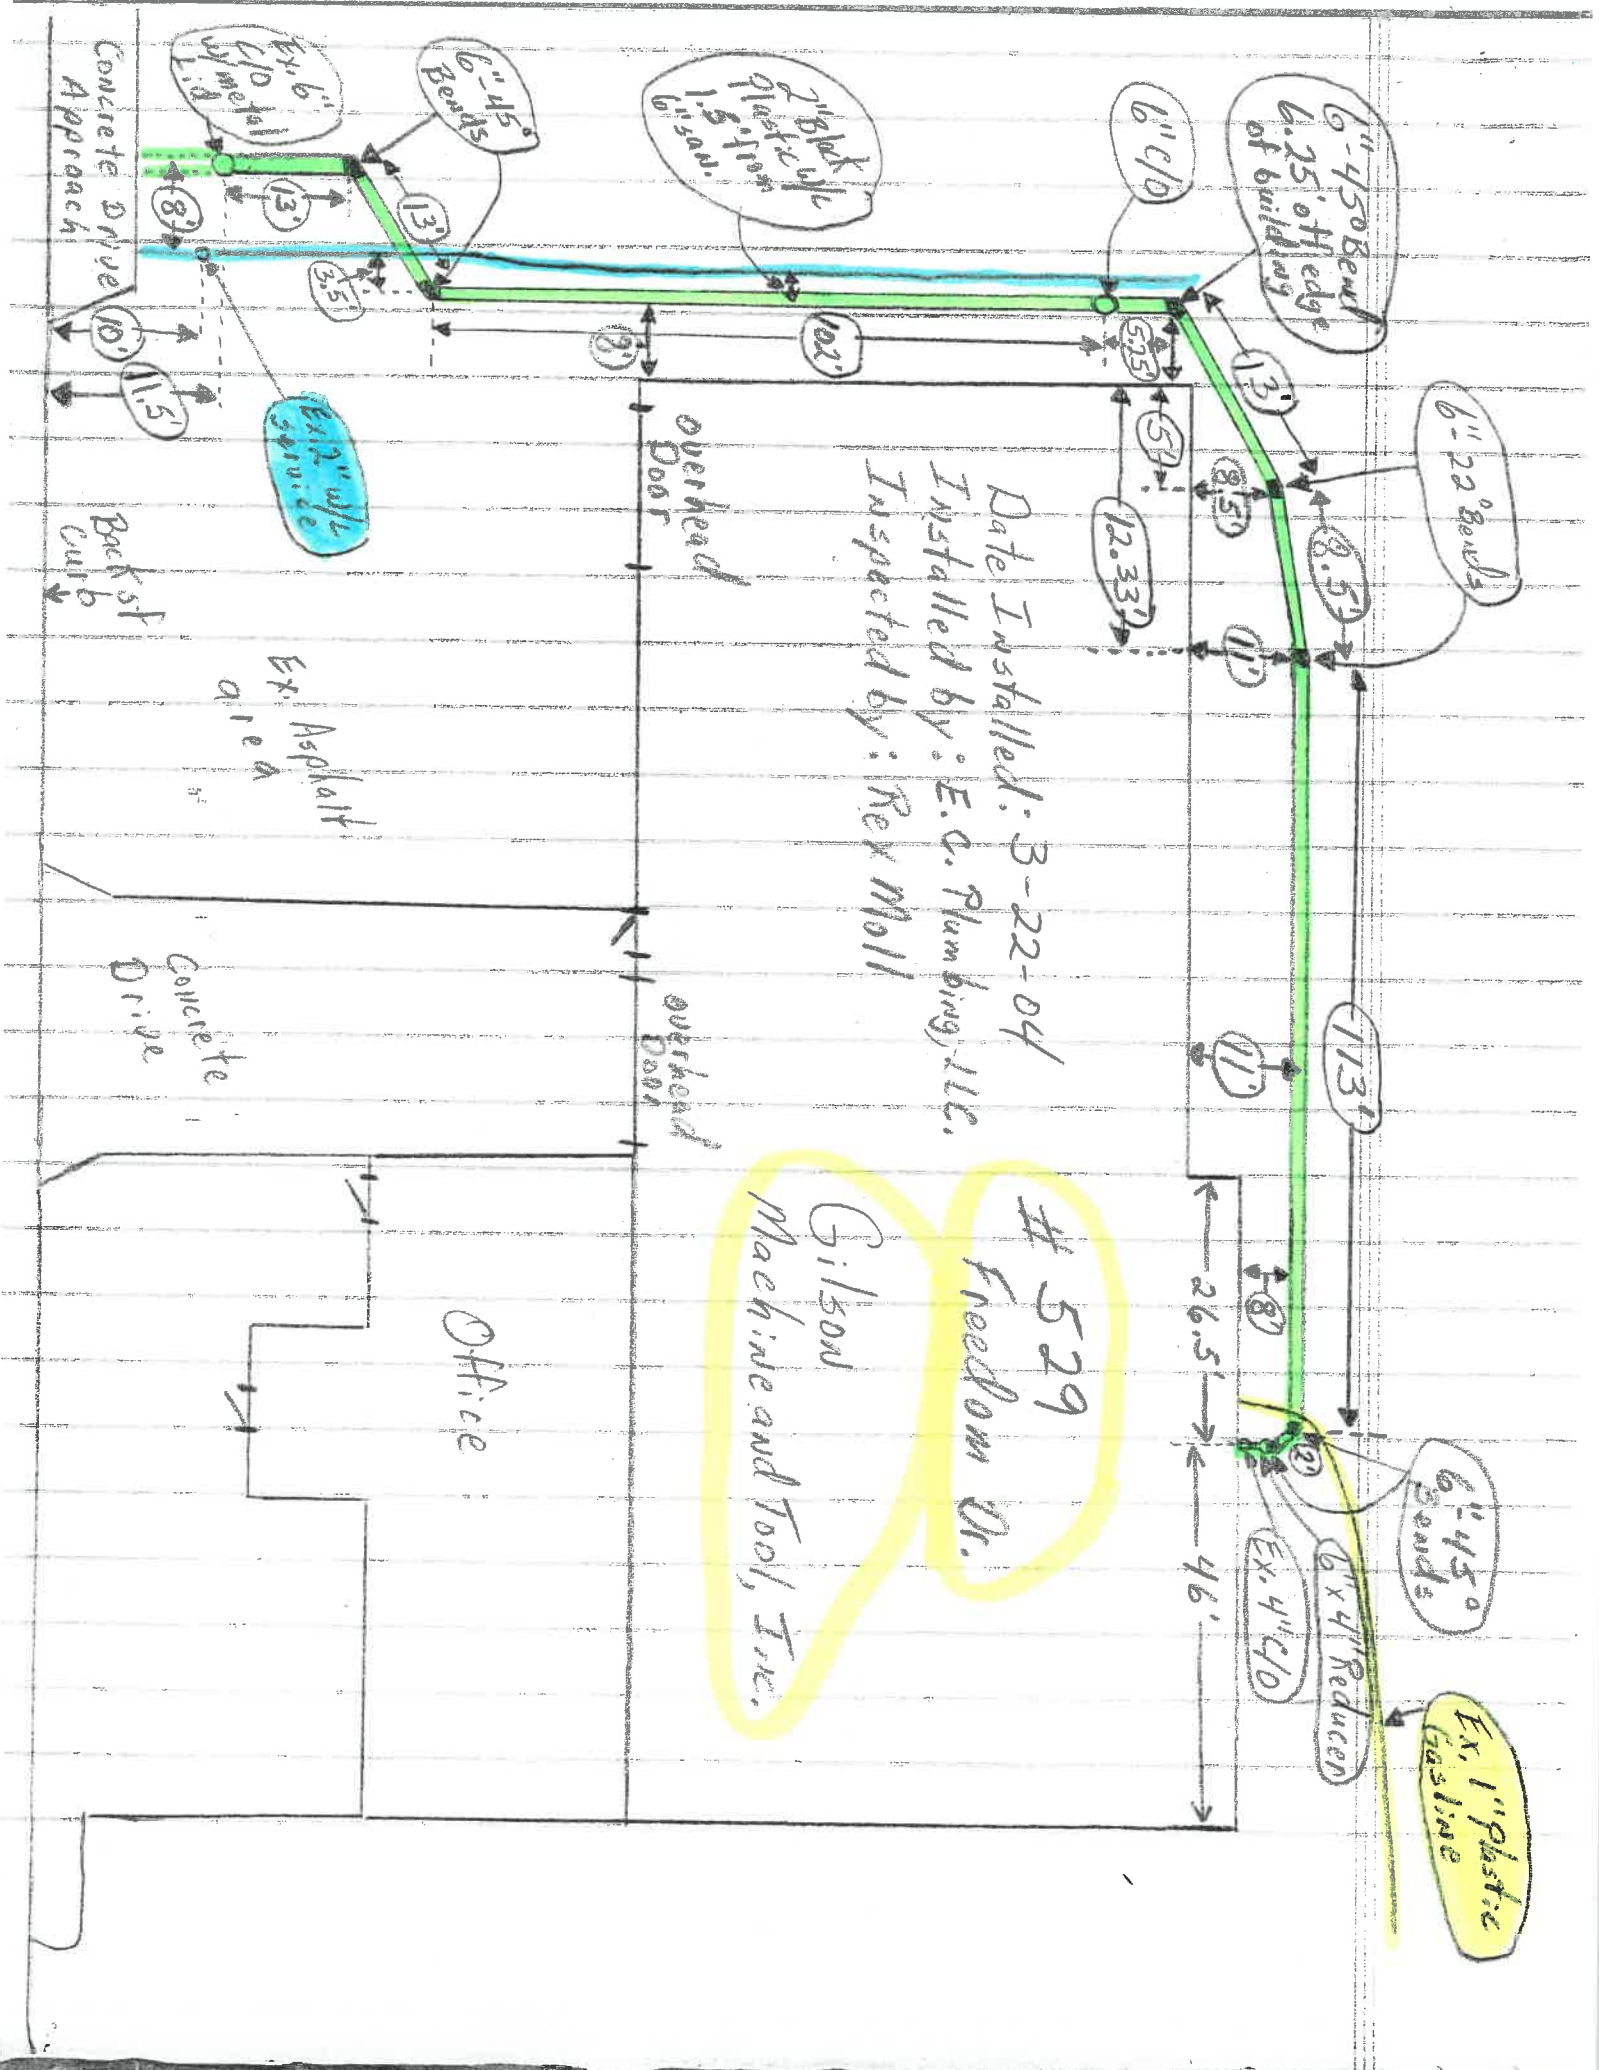

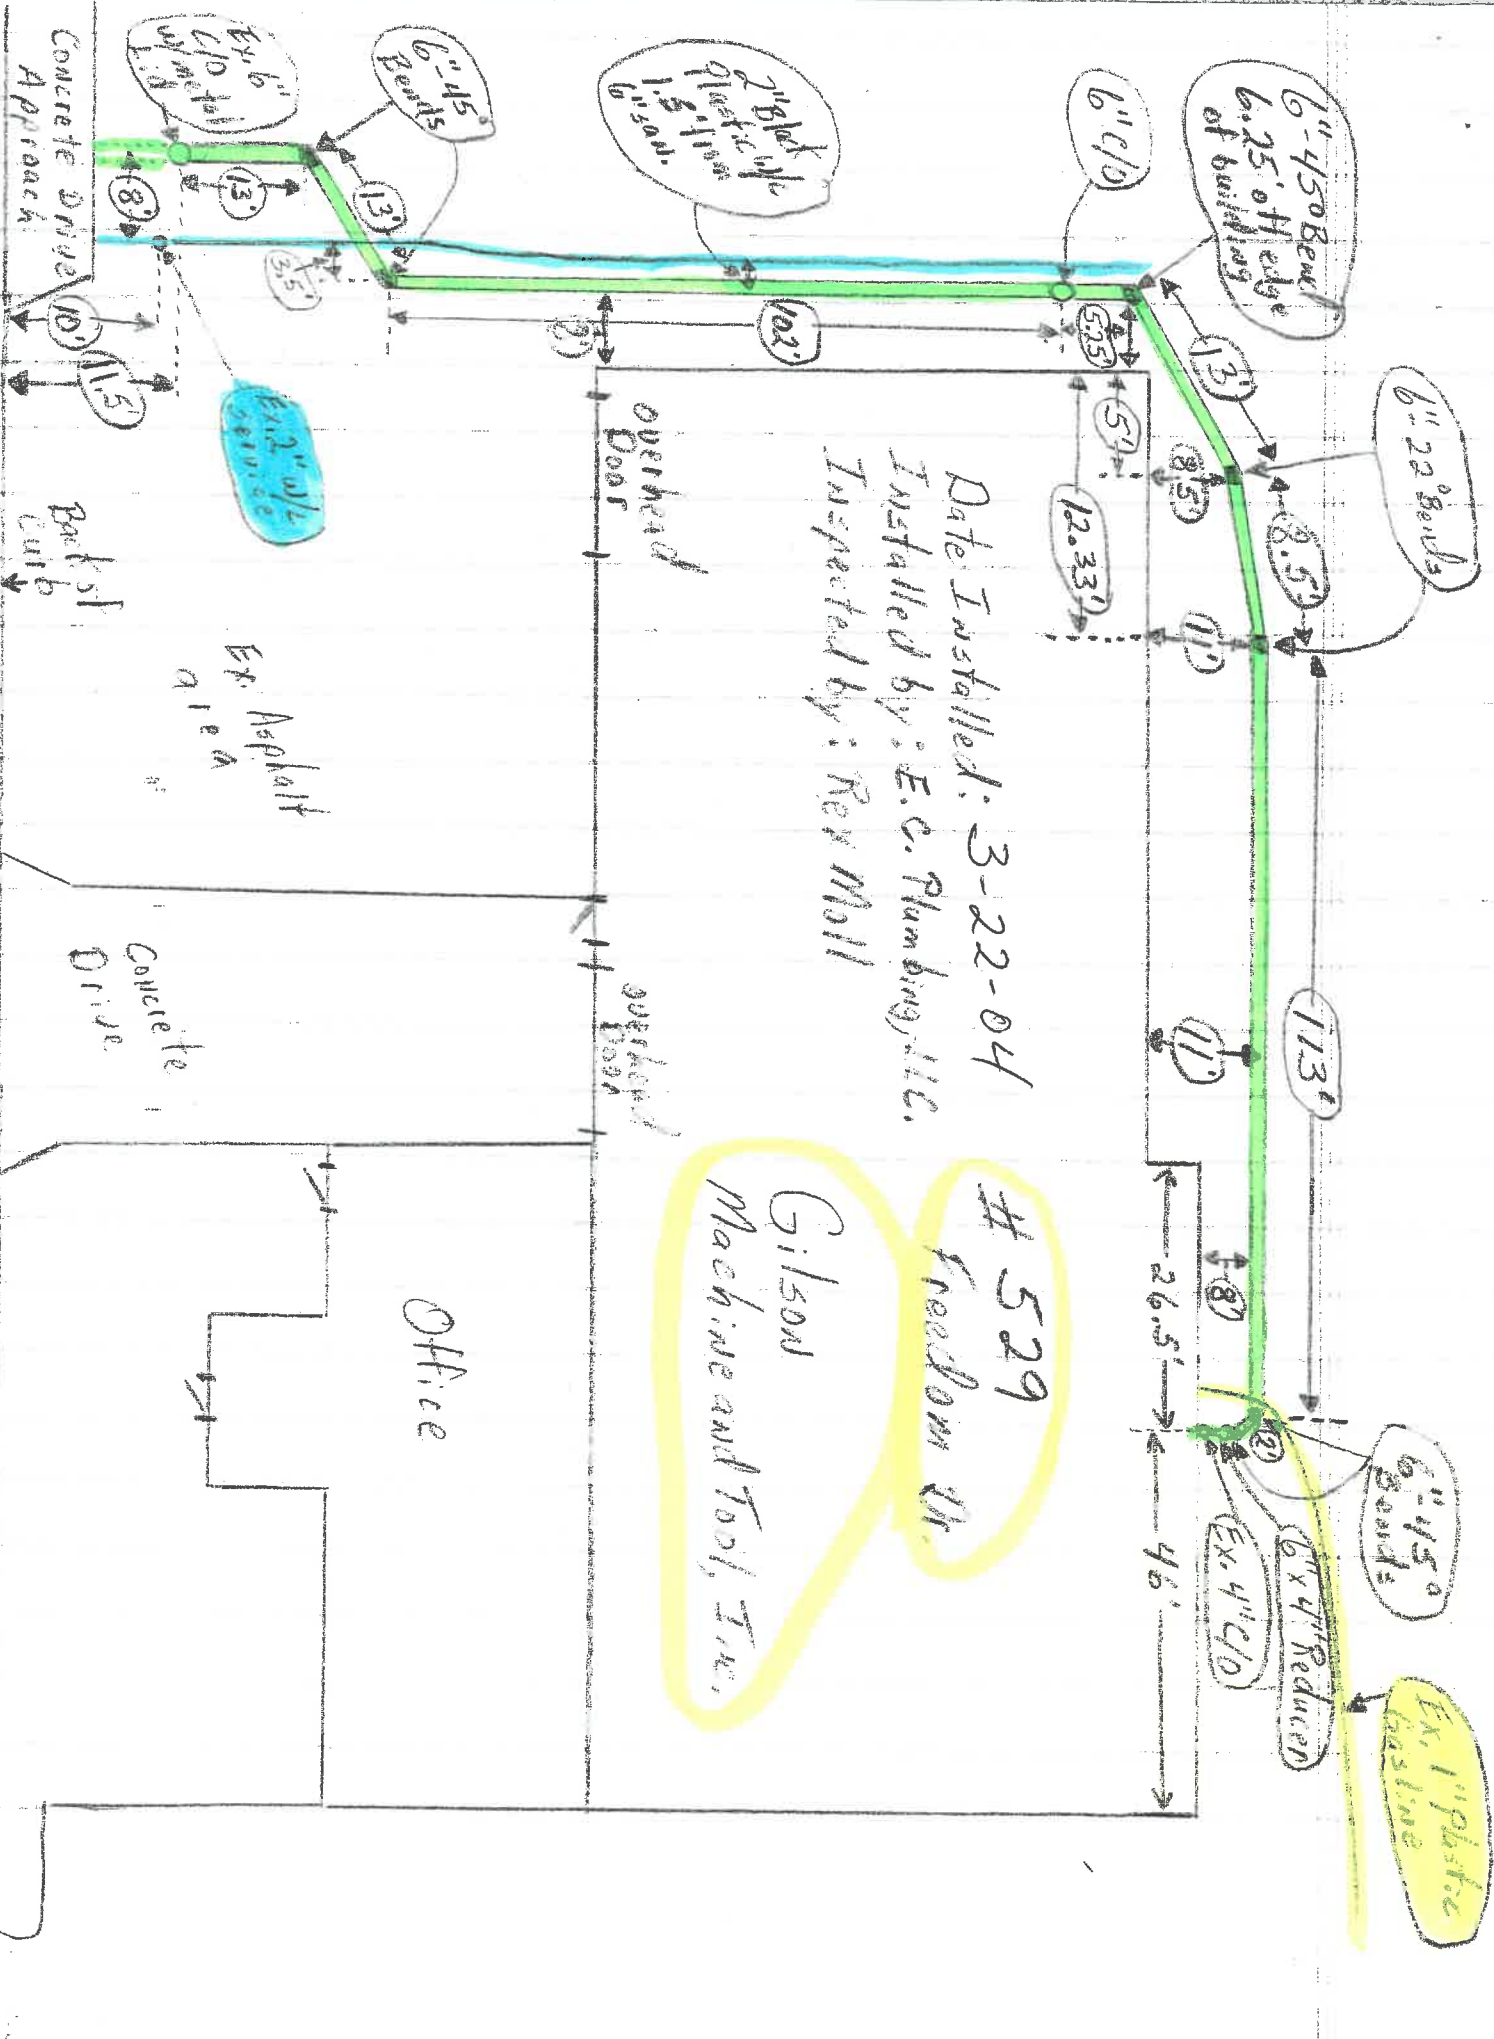



Date Installed: 3-22-04
 Installed by: E.C. Plumbing, LLC.
 Inspected by: Rex Mall

529
 Freedom Dr.
 Gilson
 Machine and Tool, Inc.

Ex. Asphalt
 area

Office

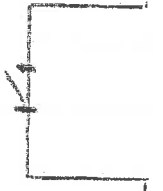

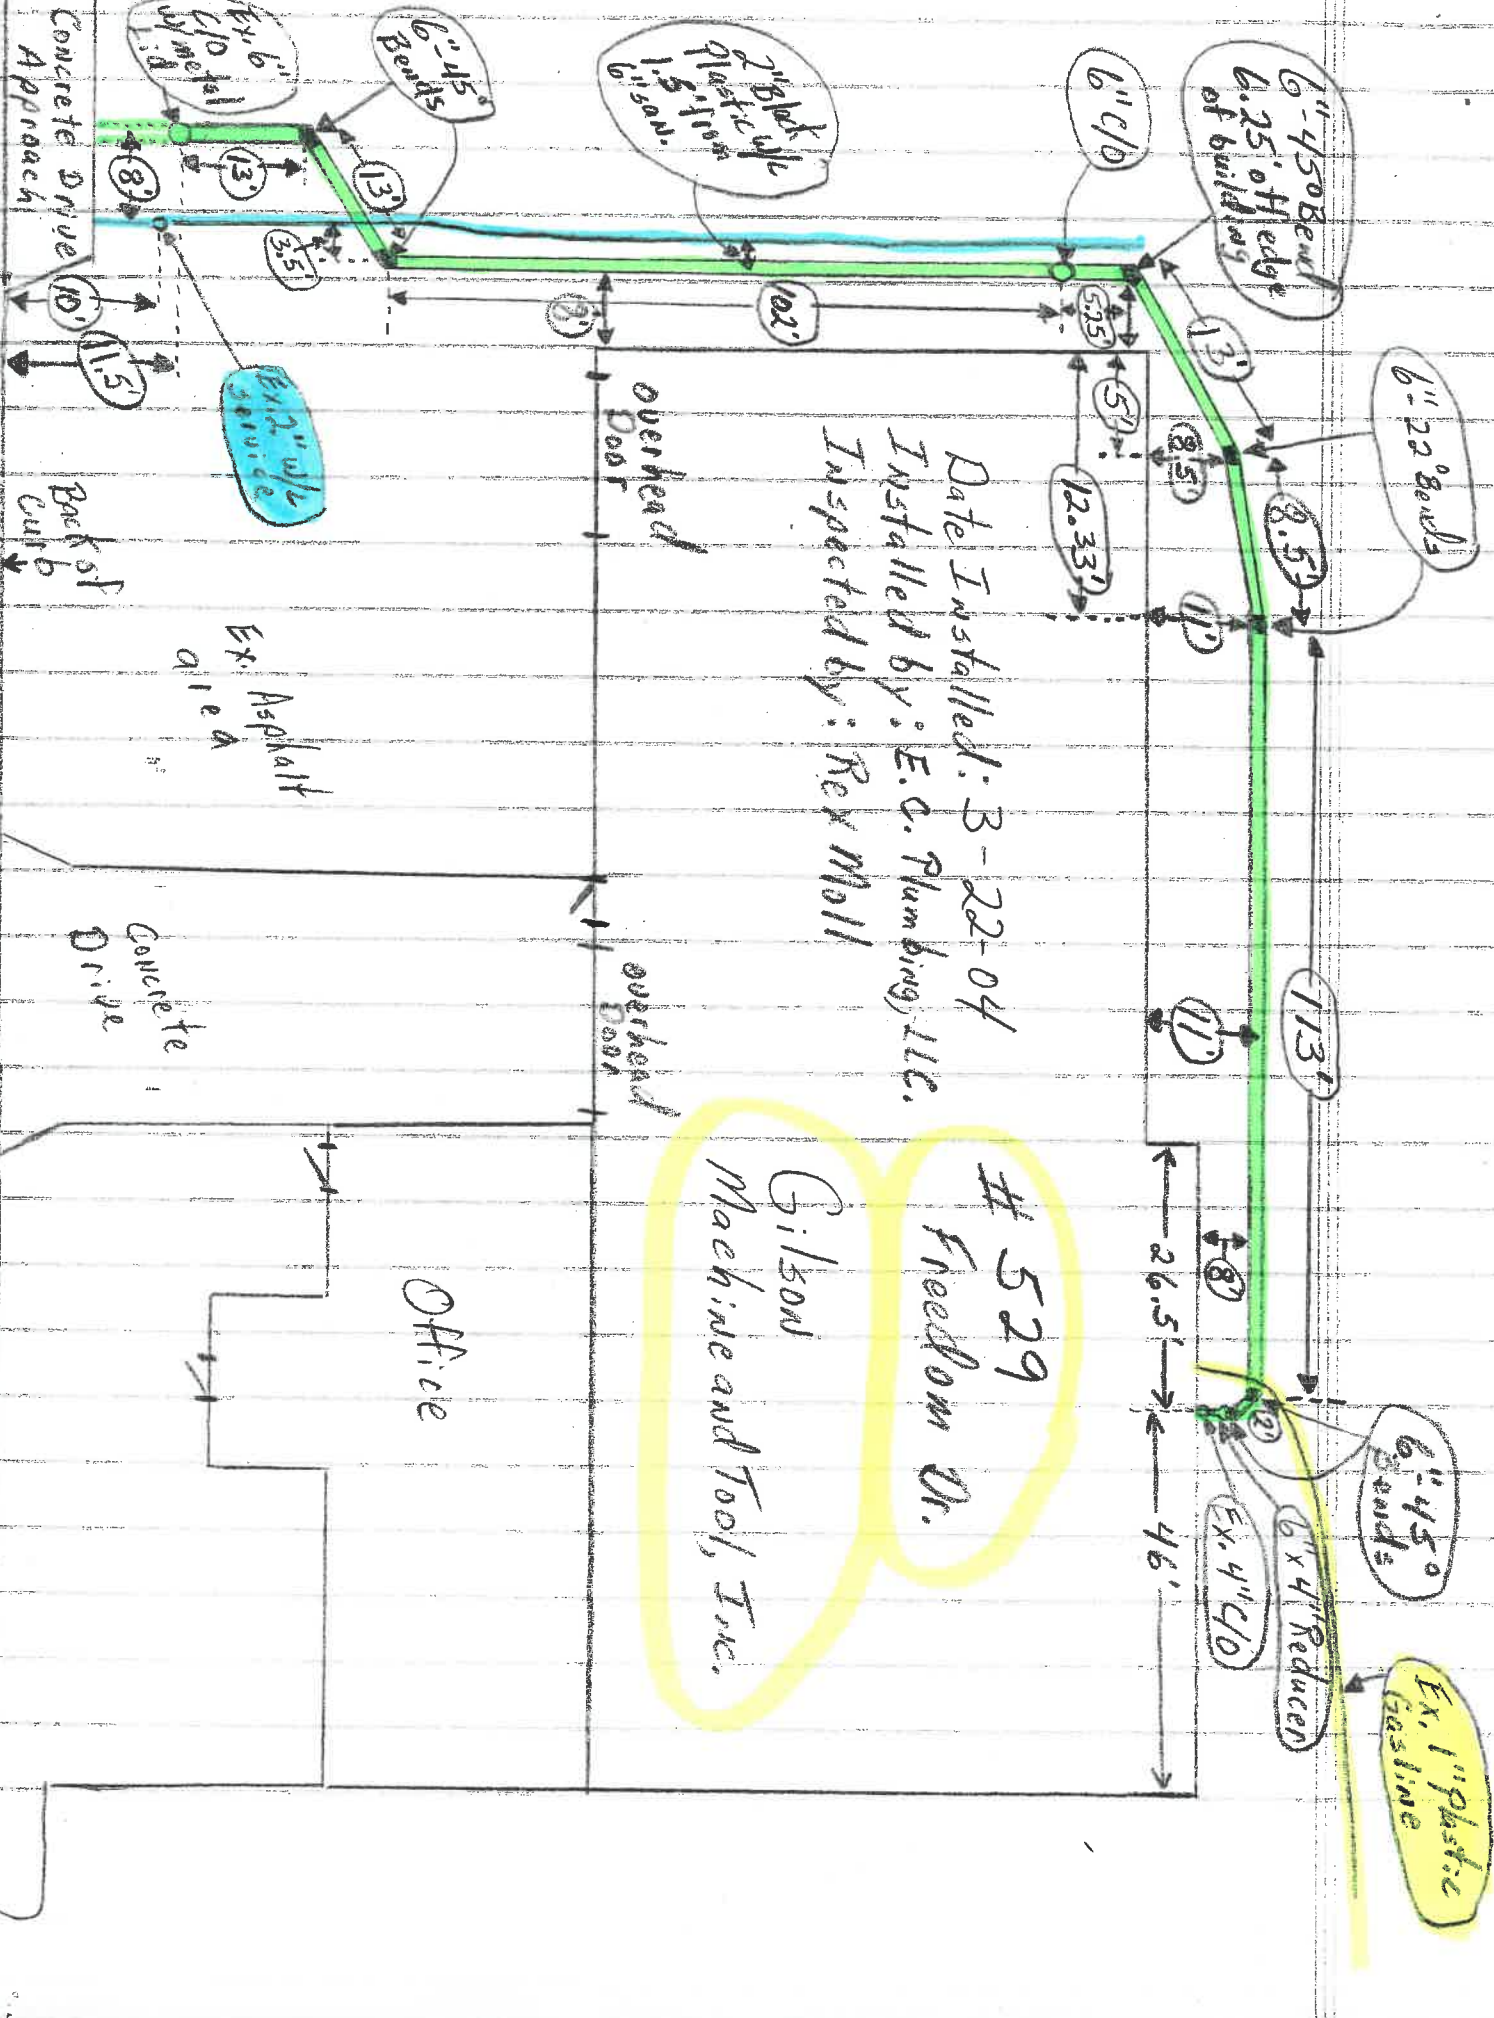

Date Installed: 3-22-04
 Installed by: E.C. Plumbing, LLC.
 Inspected by: Rex Moll

529
 Freedom Dr.
 Gilson
 Machine and Tool, Inc.

Ex. 2" w/c service

Ex. 1" plastic riseline

Concrete Drive Approach

Back of Curb

Ex. Asphalt area

Concrete Drive

Office

overhead Door

overhead Door

Ex. 6" C/D fall
 Ex. 1.5" man. riser
 2" black up plastic up
 1.5" man. riser

6" 22° Bends


6" 450 Bends
 6.25" offset of building


6" C/D

6" 450 Bends

6" x 4 1/2" Reducers

Ex. 4" C/D

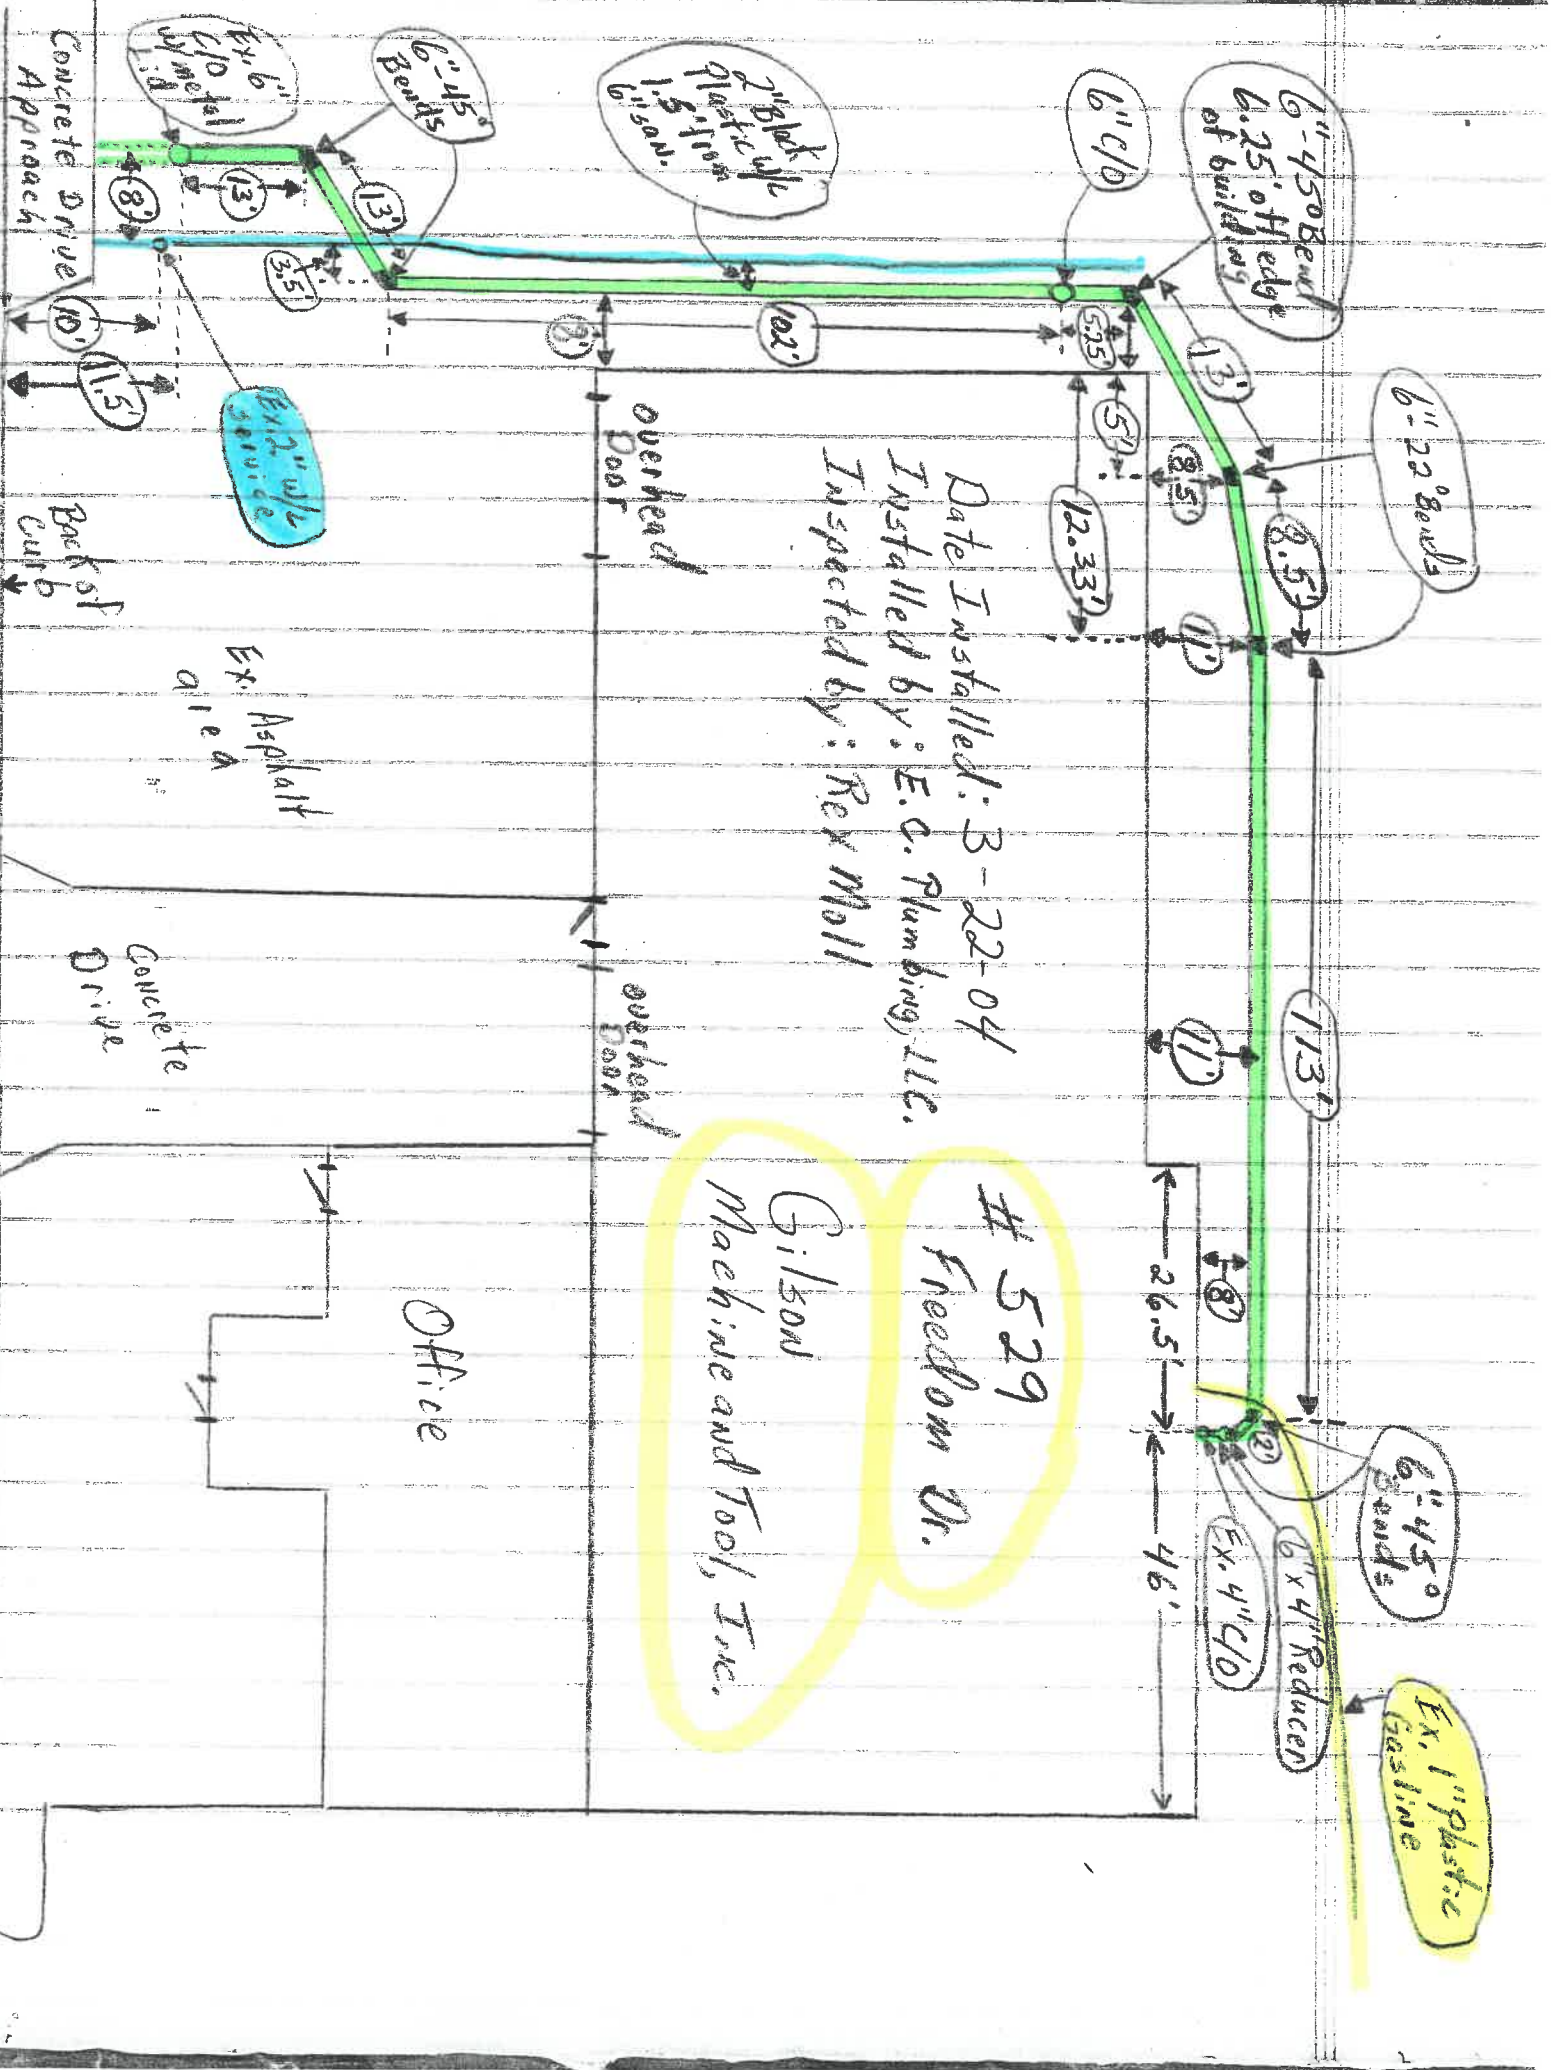

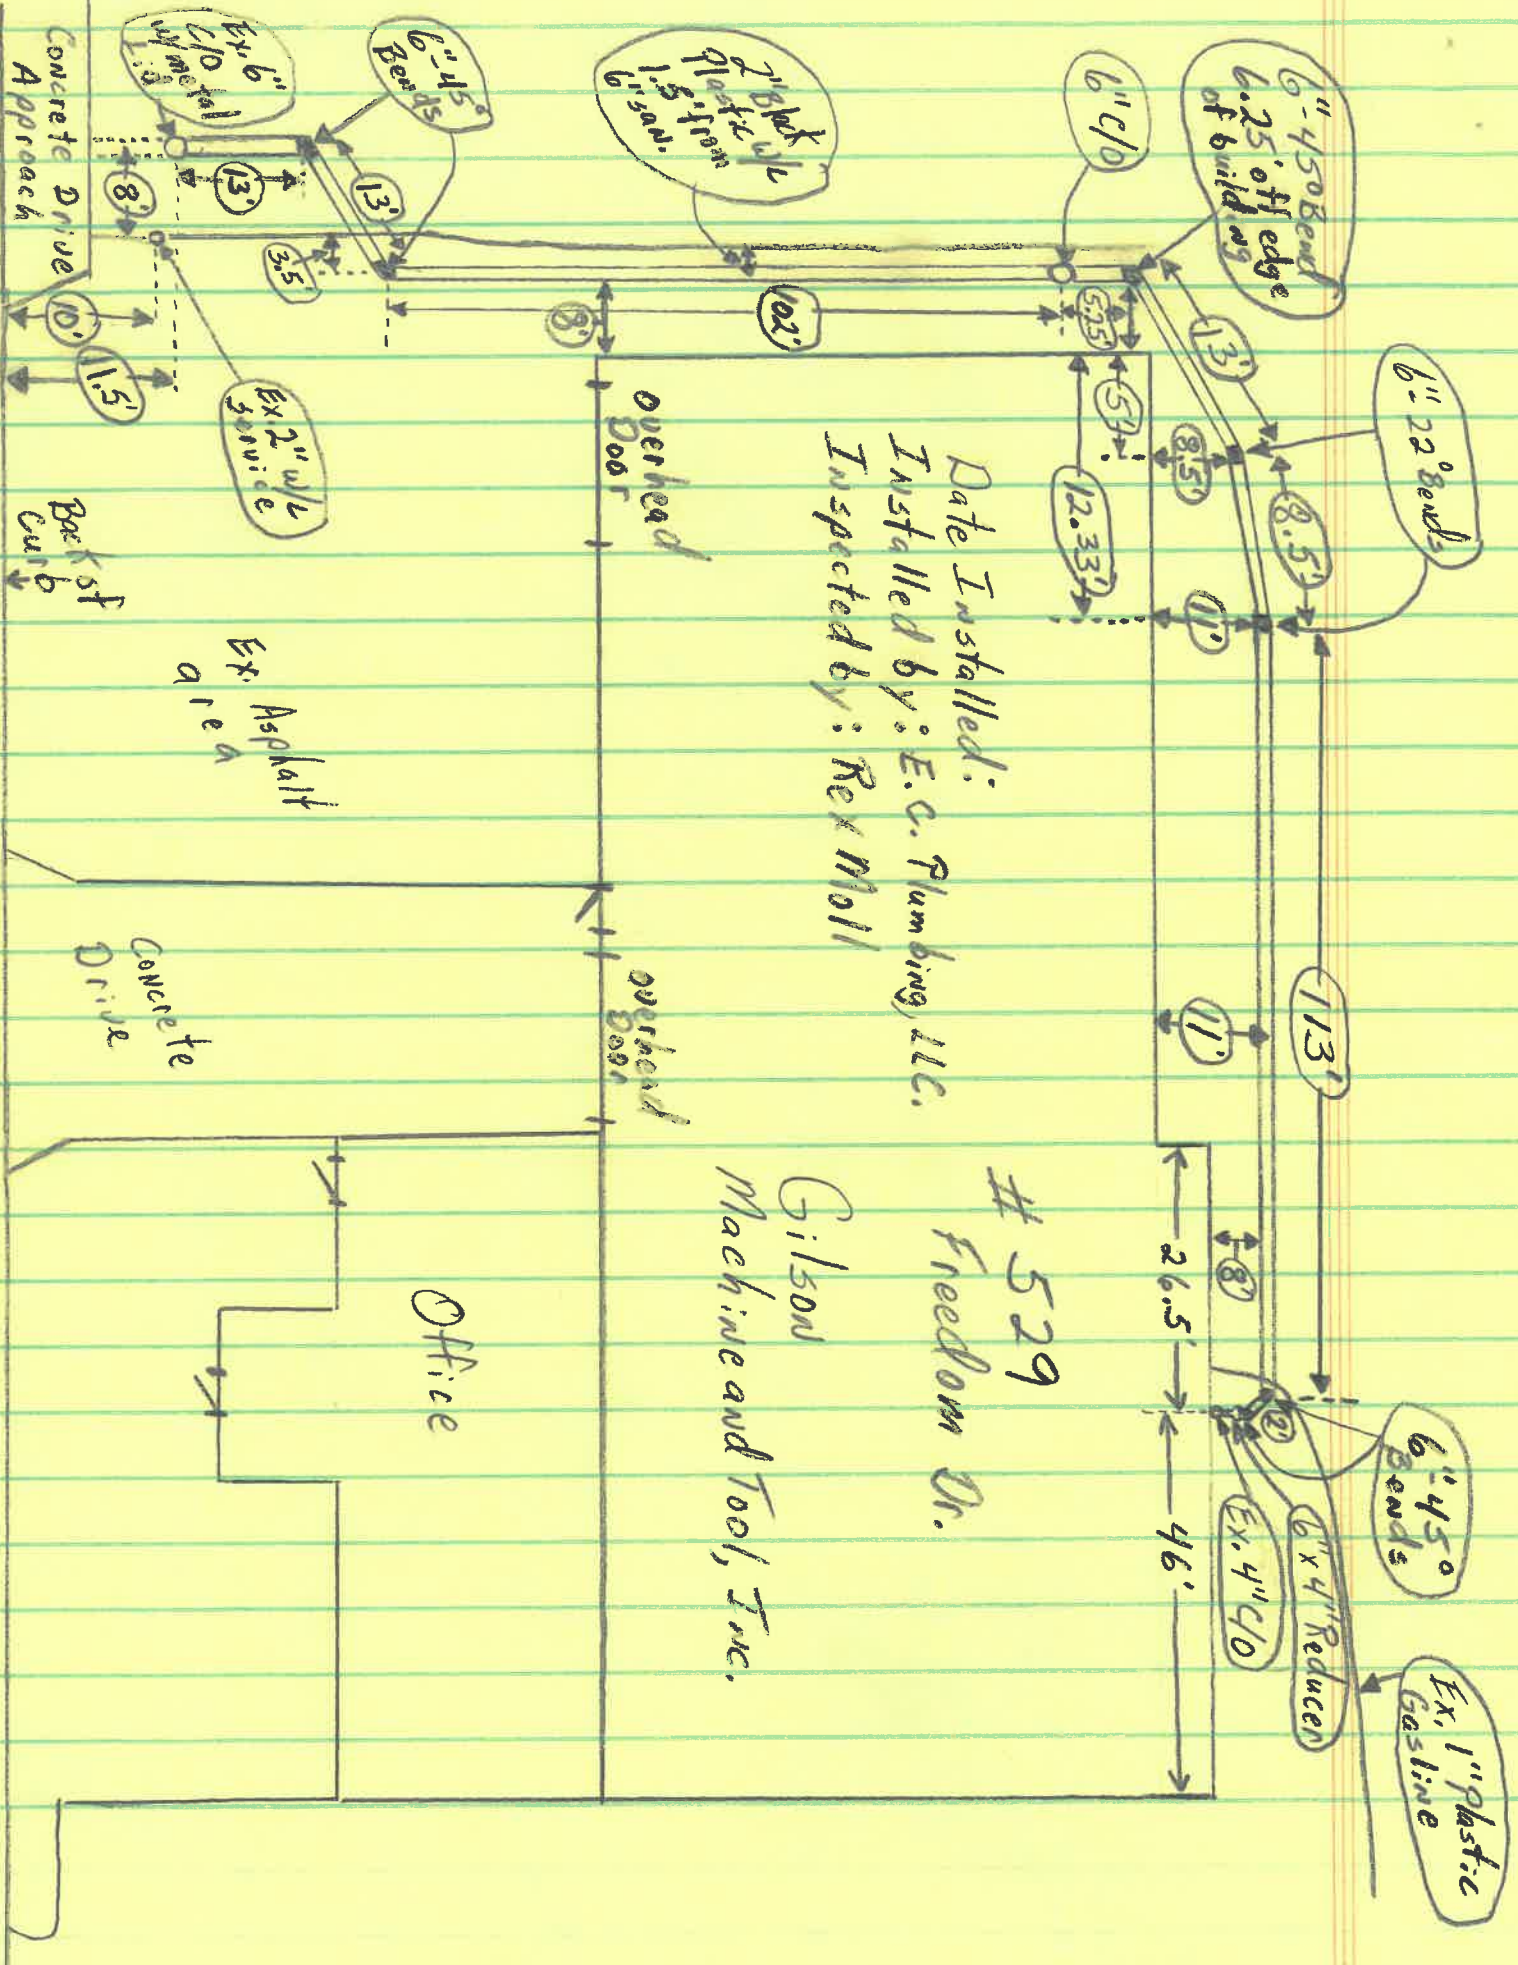


Date Installed:
 Installed by: E.C. Plumbing, LLC.
 Inspected by: Rex Moll

529
 Freedom Dr.

Gilson
 Machine and Tool, Inc.

Office

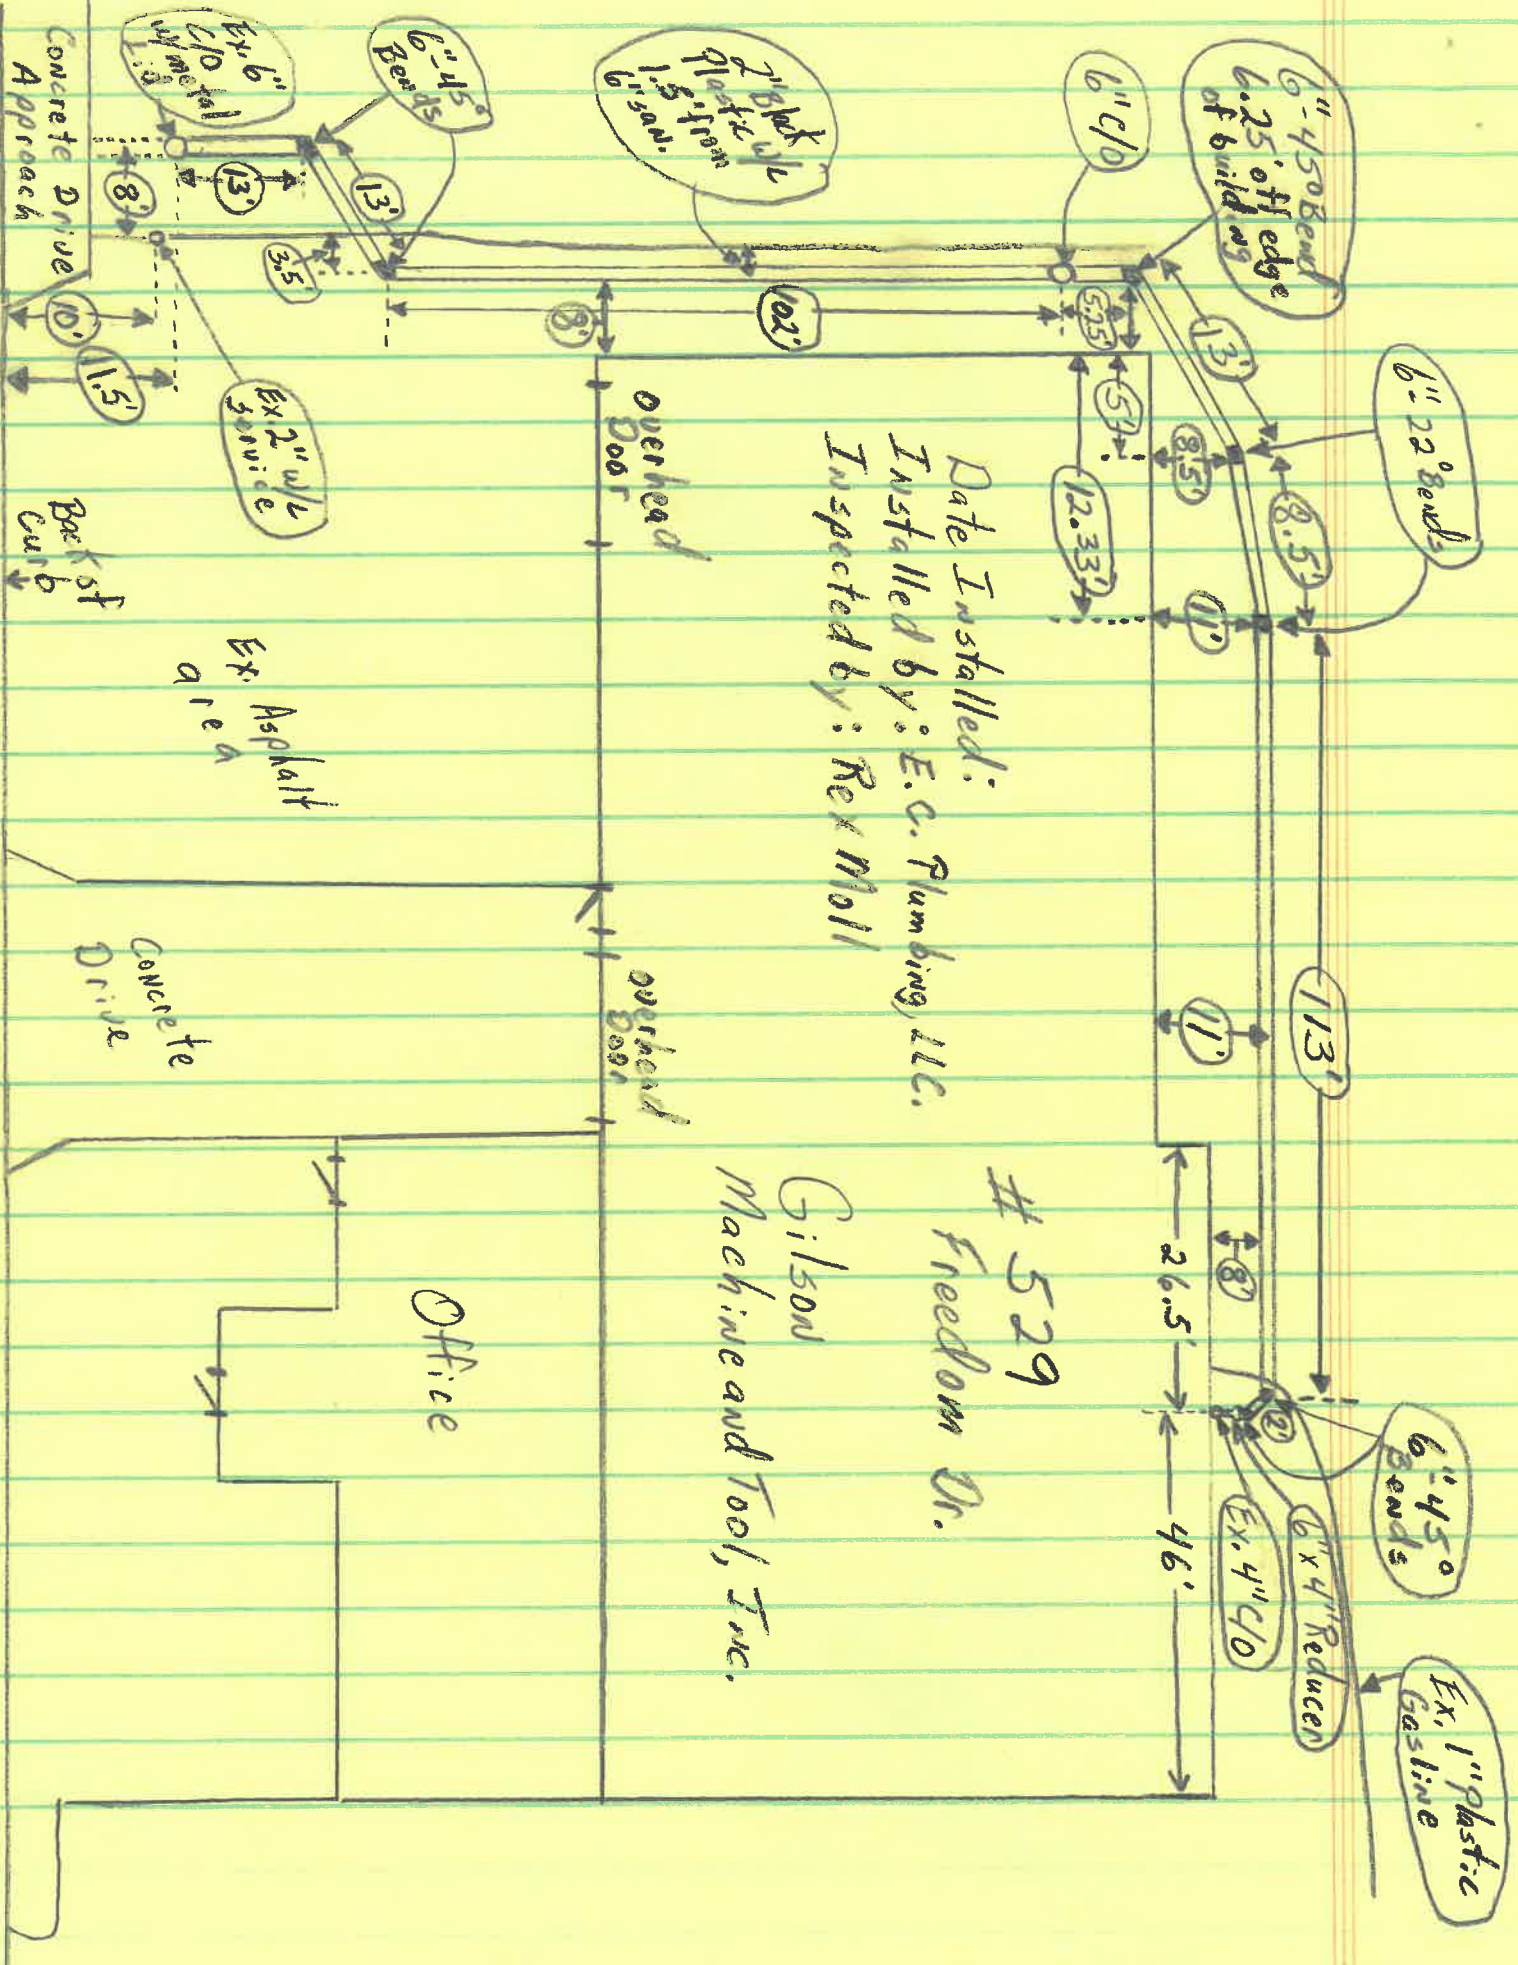



City of NAPOLEON, OHIO

255 WEST RIVERVIEW AVENUE, P.O. BOX 151
NAPOLEON, OHIO 43545-0151
(419) 592-4010
FAX (419) 599-8393

August 6, 2001

Mayor
J. Andrew Small

Gilson Machine & Tool
529 Freedom Drive
Napoleon, OH 43545

Members of Council
Michael J. DeWit, President
Terri A. Williams
James Hershberger
Travis B. Sheaffer
John A. Helberg
Jean A. Steele
Glenn A. Miller

Dear Mr. Gilson,

In the past month, the City of Napoleon has installed, tested and approved the new water main along Freedom Drive. Service taps have been provided for each business along the new water main route.

The City of Napoleon's Ordinance requires each Residential, Commercial or Industrial owner to connect to the city water main within 90 days of written notice. This letter is your written notice to connect to the City's water main.

City Manager
Dr. Jon A. Bisher

Remember to obtain the necessary permits that are required to connect to the City's water supply. Your contractor, after installing the new service, must also disconnect any wells or other water supply sources.

Finance Director
Gregory J. Heath

Should you have any questions concerning this matter, please call the Engineering Department at (419) 592-4010, Monday through Friday, 8:00 a.m. to 5:00 pm.

Law Director
David M. Grahn

Respectfully,

City Engineer
Joseph R. Kleiner, P.E.

Joseph R. Kleiner, P.E.
City Engineer

JRK/ske

cc: Jon Bisher, City Manager
Jeff Marihugh, Operations Supt.