

TAPPING PERMIT

Office of  
Water Works  
Napoleon, Ohio

PAID \$ 450.00  
OCT 15 1981  
CITY OF NAPOLEON

No. \_\_\_\_\_ Date 1  
Received of Lea Snyder  
Four hundred & fifty Dollars 00  
Charge for tapping permit to supply water services to Lot No 135-136  
Addition original plat  
Street No. 123 W Front  
Tape Size 1 1/2 " \_\_\_\_\_ inch \_\_\_\_\_ foot  
Number Bill Elmy 34619

Rupert W. Schweinhagen  
Clerk Treasurer

Date completed \_\_\_\_\_

Water Distribution Department

1 1/4 Water

# APPLICATION FOR PERMIT TO TAP SEWER PAID

(Print or Type)

OCT 15 1981

Owner LEO SNYDER  
 Address 60 RD M NAPOLKON  
 Contractor GERMAN BUILDERS  
 Address 128 E MAUMER Tel. \_\_\_\_\_

364  
 CITY OF NAPOLKON  
 BLDG. PERMIT  
 PERMIT FEE \$ 170.00  
 DATE PAID 10-15-81  
 for office use only

### LOCATION OF CONNECTION

Street and No. 123 W FRONT Sanitary  Storm \_\_\_\_\_  
 Lot No. 135-136 Subdivision Original plat Size of Tap 8"  
 Size and Type of Sewer 8" PVC

ALL WORK MUST BE INSPECTED

I certify that the sewer will be used only as indicated and no other Drainage will be connected.  
 Date 10/15/81 Signature [Signature] owner-builder-agent  
 do not write below this line


### INSPECTION RECORD

Date Inspected 10-23-81 Size and Type of Sewer 8" PVC  
 Location FRONT OF BUILDING Depth 4' Type of Test VISUAL  
 Inspected and Approved By: [Signature] Inspector Date 10-23-81

Additional Information CONNECTION CEMENT GROUTED. SERVICE COVERED WITH #67 STONE  
ALL OTHER BACKFILL CONSISTED OF YELLOW SAND AND "G.M." SAND COMPACTED IN 8" LIFTS

Send copy to: \_\_\_\_\_

### SKETCH OF INSTALLATION

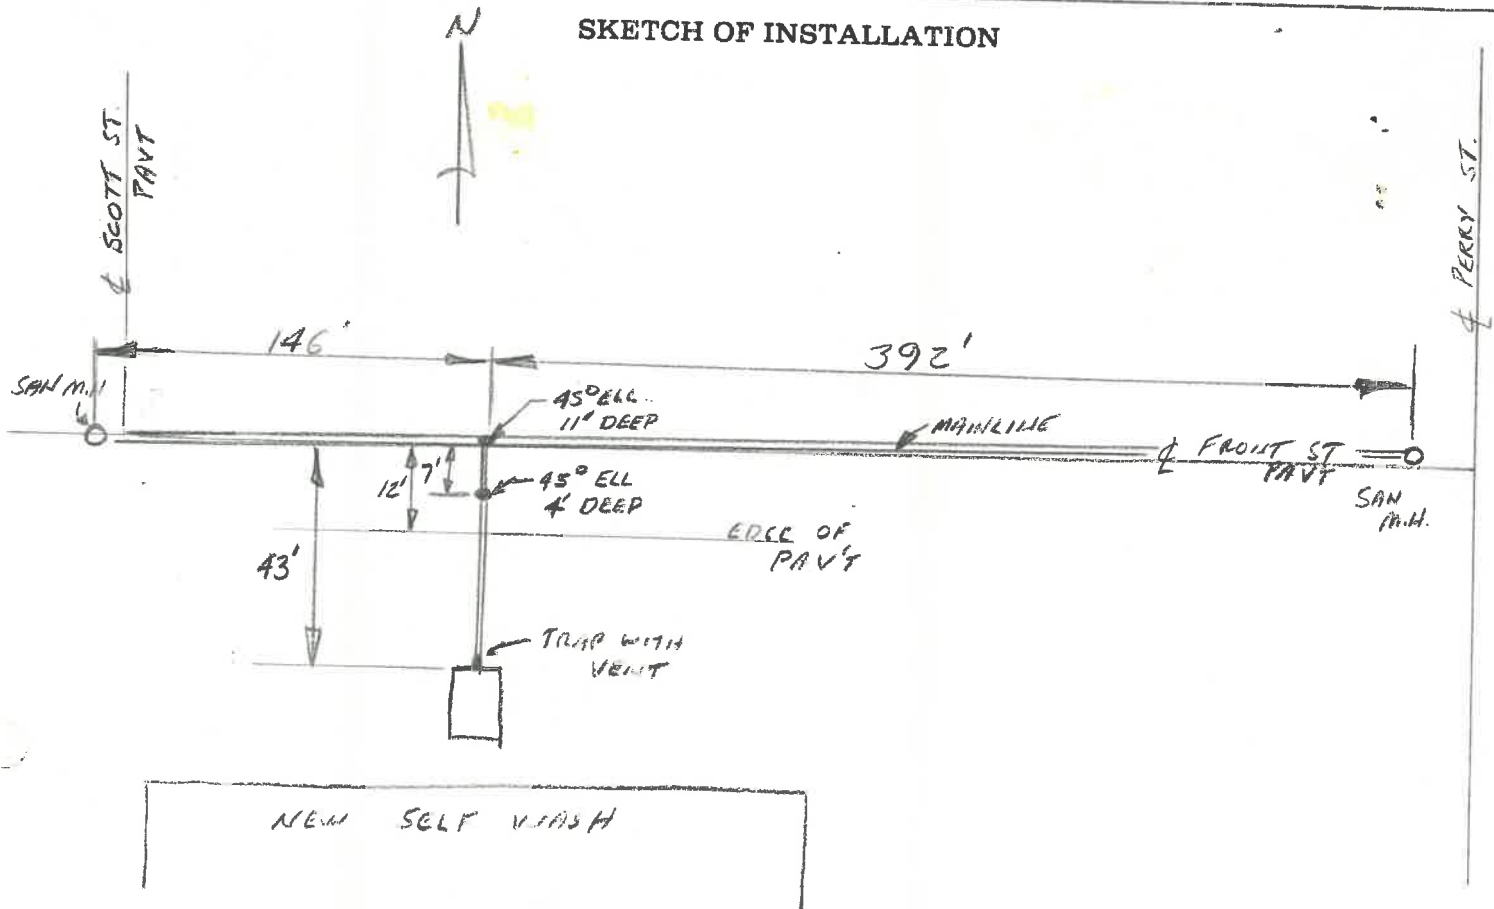

White-Applicant

Yellow-Building Dept.

Pink-Clerk-Treasurer