

SEWER TAPPING PERMIT

Issued by

The City of Napoleon Engineering Dept.

255 West Riverview Ave. Napoleon, Ohio 43545 Pn. 592-4010

Entry No. \_\_\_\_\_

Permit No. 00438 Issued 12-1-93 Build. Permit No. \_\_\_\_\_

Job Location 839 W. Graceway

Lot \_\_\_\_\_ sub div. or legal disc.

Issued By BND

Owner Maxim Richards Pn. 592 6676

Address 839 W. Graceway

Agent Jerry Glanz Pn. 599-4103

Address 6 Lakeview Napoleon

Permit Fee \$ 60.00

Street Bond \$ \_\_\_\_\_

Date Paid 12-1-93

for office use only

WORK INFORMATION

Sanitary Sewer Tap Replace existing Size of Tap \_\_\_\_\_ Size and Type of Sewer \_\_\_\_\_ Street to be Opened \_\_\_\_\_  
yes no

Storm Sewer Tap \_\_\_\_\_ Size of Tap \_\_\_\_\_ Size and Type of Sewer \_\_\_\_\_ Street to be Opened \_\_\_\_\_  
yes no

Street opening Agreement Approval Date \_\_\_\_\_ Opening Bond Fee (Set by Engineer) \_\_\_\_\_

READ AND SIGN BELOW; The undersigned hereby agrees complete the work described above and to make use of said sewers only as allowed by and in strict accordance with all applicable provisions of The Napoleon Engineering Dept. Rules and Regulations, The Napoleon Standard Specification for Water Main, Sanitary Sewer and Storm Sewer Construction and other Pertinent Sections of the Napoleon Code of Ordinances.

Date 12-1-93 Signature of Applicant [Signature]  
Permit not valid without signature

INSPECTION RECORD \_\_\_\_\_ to be completed by the Field Inspector

Date Inspection is made \_\_\_\_\_ Size and Type of Sewer \_\_\_\_\_


Location \_\_\_\_\_ Depth \_\_\_\_\_ Type of Test \_\_\_\_\_ Additional Information \_\_\_\_\_

Date \_\_\_\_\_ Inspected By \_\_\_\_\_  
signature of inspector

Sketch Of Installation on Back or Attached

PAID  
DEC 02 1993  
CITY OF NAPOLEON


839 W. Graceway

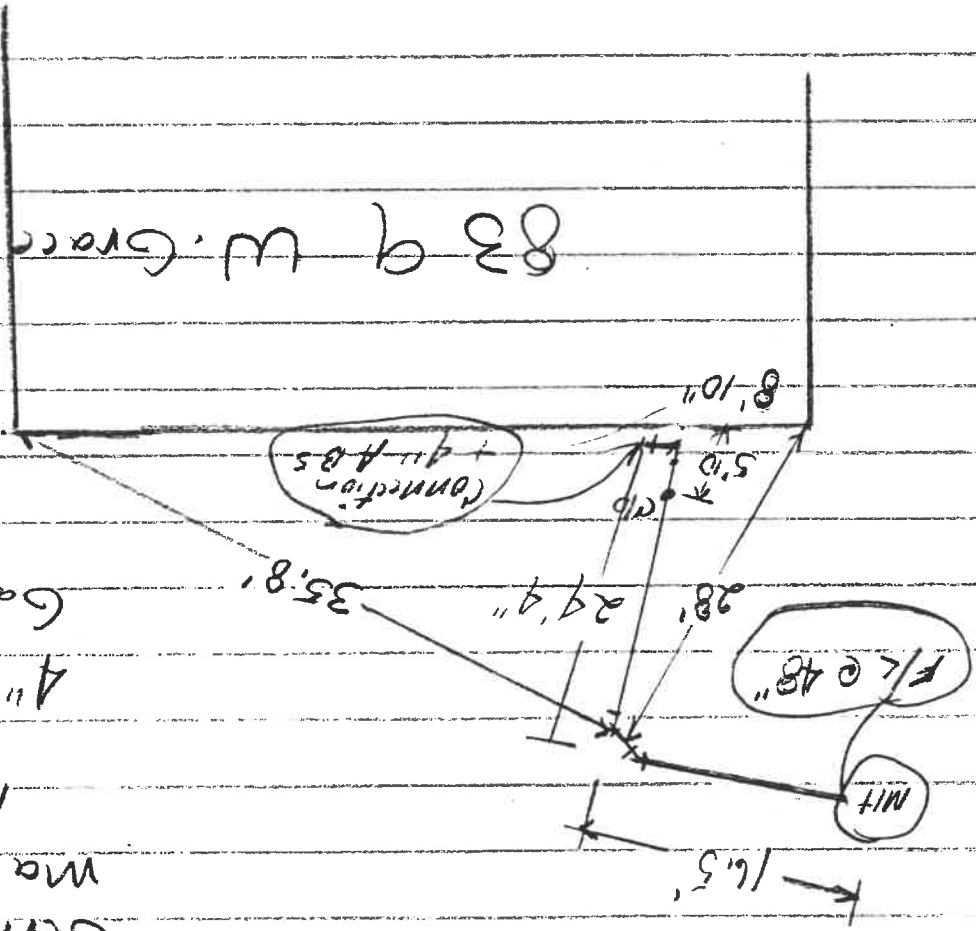

4" PVC SDR  
Gas Ket Joint

Jerry Glanz  
Maxien Richards  
12-1-93

Jerry Glanz  
Maxim Richards  
12-1-93

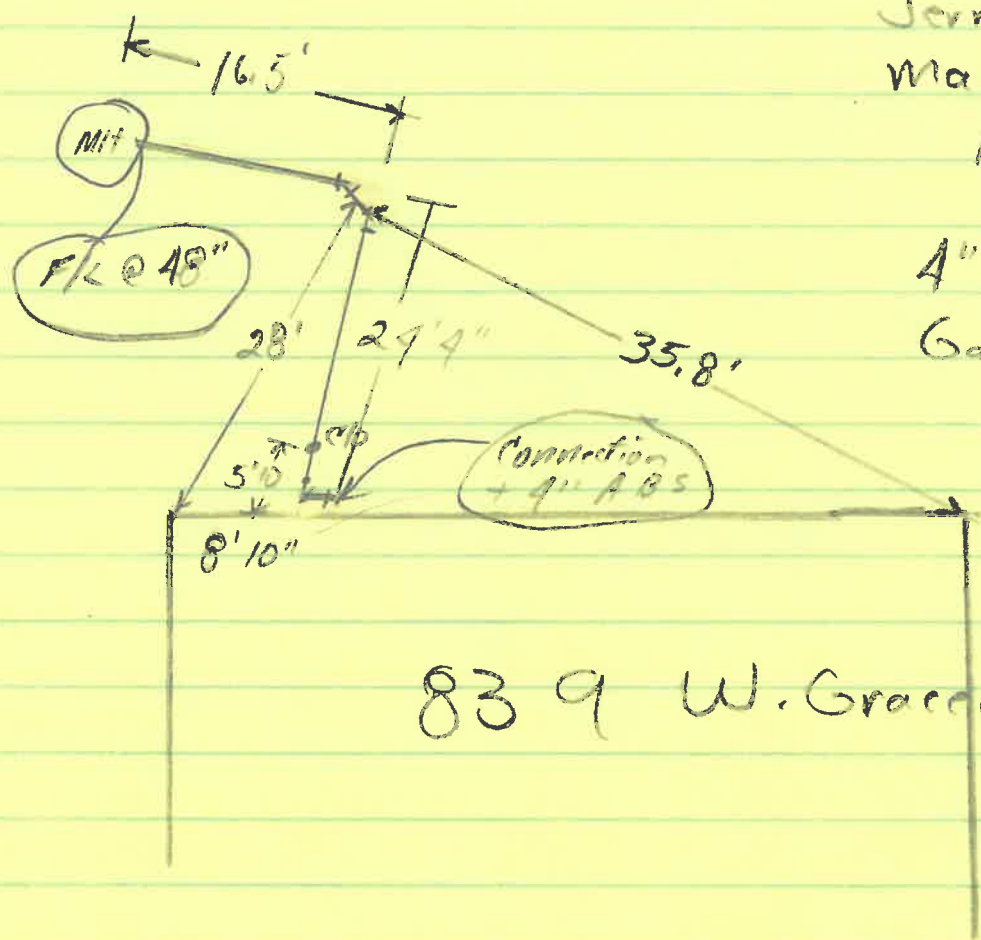

4" PVC SDR  
Gasket Joint  
BND

839 W. Graceway

