

SEWER TAPPING PERMIT

Issued by

The City of Napoleon Engineering Dept.

253 West Riverview Ave. Napoleon, Ohio 43545 Pn. 592-4010

Entry No. \_\_\_\_\_

Permit No. SA0167 Issued 2-13-91 Build. Permit No. \_\_\_\_\_

Permit Fee \$ 35.00

Job Location 864 W. Graceway

Street Bond \$ \_\_\_\_\_

Lot 14 Richters 3rd add.

Date Paid 2/13/91 35.00

Issued By Brent N. Damman sub div. or legal disc.

Owner J.M. Jones Pn. 599-5981

Address 864 W. Graceway

Agent Sipple Plbg. Pn. 748-8180

Address P.O. Box 147 Grand Rapids 43522

for office use only

WORK INFORMATION

Sanitary Sewer Tap Repair/Cleanout  yes  no Size of Tap 4" Size and Type of Sewer V.T. Street to be Opened \_\_\_\_\_

Storm Sewer Tap \_\_\_\_\_  yes  no Size of Tap \_\_\_\_\_ Size and Type of Sewer \_\_\_\_\_ Street to be Opened \_\_\_\_\_

Street opening Agreement Approval Date \_\_\_\_\_ Opening Bond Fee (Set by Engineer) \_\_\_\_\_

READ AND SIGN BELOW; The undersigned hereby agrees complete the work described above and to make use of said sewers only as allowed by and in strict accordance with all applicable provisions of The Napoleon Engineering Dept. Rules and Regulations, The Napoleon Standard Specification for Water Main, Sanitary Sewer and Storm Sewer Construction and other Pertinent Sections of the Napoleon Code of Ordinances.

Date 2-13-91 Signature of Applicant Judson Sipple Permit not valid without signature

INSPECTION RECORD

\_\_\_\_\_ to be completed by the Field Inspector

Date Inspection is made \_\_\_\_\_ Size and Type of Sewer \_\_\_\_\_

Location attached Depth \_\_\_\_\_ Type of Test \_\_\_\_\_ Additional Information \_\_\_\_\_

Date \_\_\_\_\_ Inspected By \_\_\_\_\_ signature of inspector

Sketch Of Installation on Back or Attached


**PAID**  
**FEB 13 1991**  
**CITY OF NAPOLEON**

RIS - 5'  
5' 7" to F.L.

5' 7" to P.C.  
5' 7" to P.C.

N

31' to F.L.

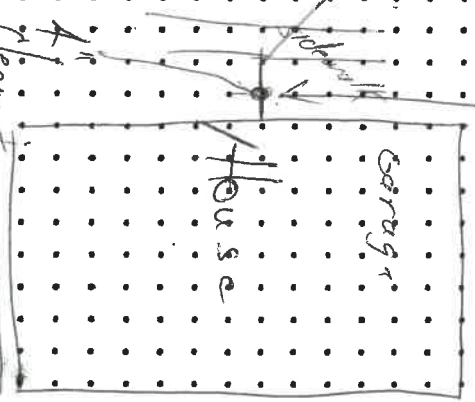

West A.V. to A.P.C. fence  
 Permitted in Air Survey zone

East (Direction A.V. to A.P.C. fence)

CITY OF HANOVER  
 FEB 12 2011  
 PAID