

SEWER TAPPING PERMIT

Issued by

The City of Napoleon Engineering Dept.

255 West Riverview Ave. Napoleon, Ohio 43545 Pn. 592-4010

Entry No. _____

Permit No. S.P. 010989 Issued 9-11-89 Build. Permit No. _____

Permit Fee \$ 60.00

Job Location 907 West Greenway

Street Bond \$ _____

Lot 25 RIGHTER'S 3RD ADD

Date Paid _____

Issued By FH sub div. or legal disc.

Owner H.E. Riesen Pn. _____

Address 629 W Washington

Agent Mr. Peter Doby Pn. 758-3855

Address RR# 4 Napoleon

for office use only

WORK INFORMATION

Sanitary Sewer Tap Size of Tap 4" Size and Type of Sewer 4" P.V.C. Street to be Opened

Storm Sewer Tap Size of Tap _____ Size and Type of Sewer _____ Street to be Opened

Street opening Agreement Approval Date _____ Opening Bond Fee (Set by Engineer) _____

READ AND SIGN BELOW; The undersigned hereby agrees complete the work described above and to make use of said sewers only as allowed by and in strict accordance with all applicable provisions of The Napoleon Engineering Dept. Rules and Regulations, The Napoleon Standard Specification for Water Main, Sanitary Sewer and Storm Sewer Construction and other Pertinent Sections of the Napoleon Code of Ordinances.

Date 9-11-1989 Signature of Applicant [Signature]

Permit not valid without signature

INSPECTION RECORD

to be completed by the Field Inspector

Date Inspection is made 9-18-89 Size and Type of Sewer 4" P.V.C.

Location SEE PLAN Depth SEE PLAN Type of Test NONE Additional Information _____

Date 9-19-89 Inspected By SONNY HELDERG


signature of inspector

Sketch Of Installation on Back or Attached

PAID

SEP 11 1989

CITY OF NAPOLEON

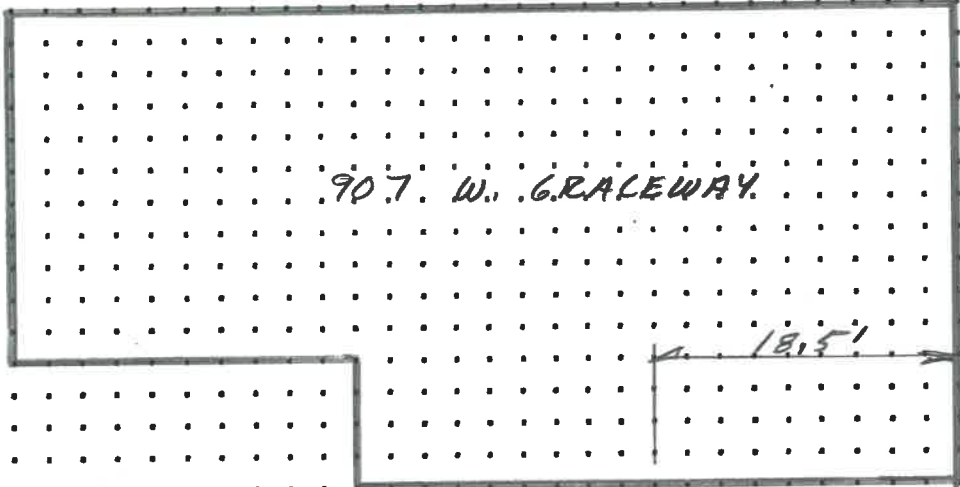

90.7 W. GRALEWAY

18.5'

FERNCO TO SOIL PIPE 30" DEEP
6.0'

4" P.V.C. REPLACES EXISTING

EXISTING SANITARY SEWER


7' DEEP

DOWNSTREAM MANHOLE

67.5'

PAID
CITY OF OAKLAND

9-19-89 Mont Carolas

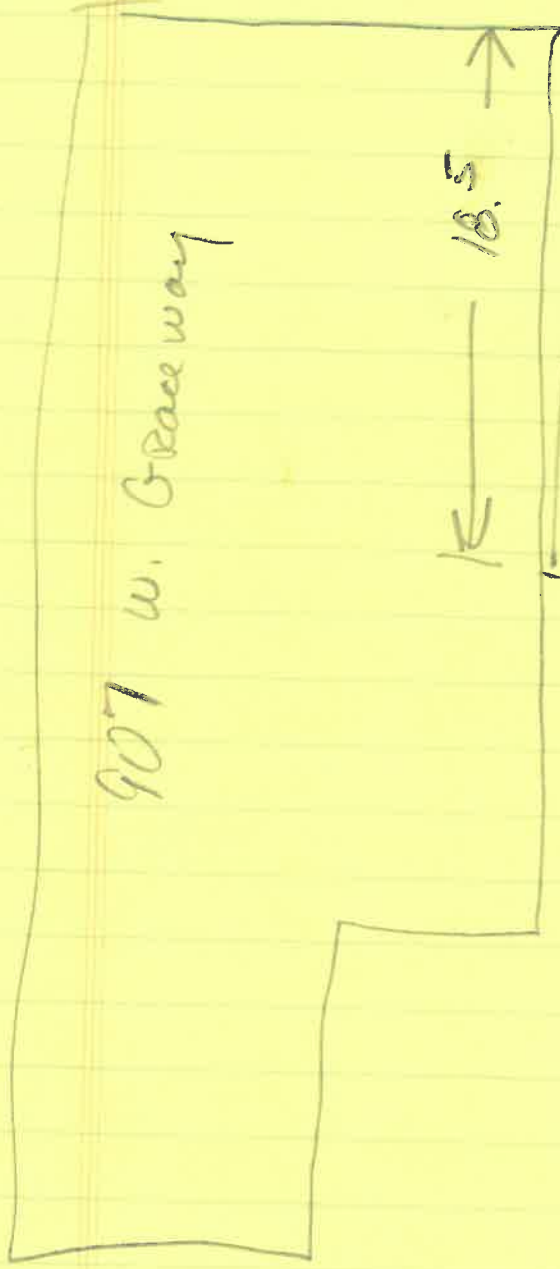

Ø C.O. 30" DEEP
FERRULO to soil pipe

4" P.V.C. replacement

7' DEEP

67.5

EXISTING SAND

DOWNSTREAM M.H.



