

SEWER TAPPING PERMIT

Issued by

The City of Napoleon Engineering Dept.

255 West Riverview Ave. Napoleon, Ohio 43545 Pn. 592-4010

Entry No. \_\_\_\_\_

Permit No. 00407 Issued 1-21-92 Build. Permit No. \_\_\_\_\_

Job Location 959 W. Grassway

Lot \_\_\_\_\_

Issued By BND sub div. or legal disc.

Owner Raymond Travis Pn. 592-7721

Address 959 W. Grassway

Agent Sipple P/bg+Htg Pn. 748-8180

Address P.O. Box 147 Grand Rapids, Oh

Permit Fee \$ 25.00

Street Bond \$ \_\_\_\_\_

Date Paid 1-21-92

\$25.00

for office use only

WORK INFORMATION

c/o installation #3522

Sanitary Sewer Tap \_\_\_\_\_ Size of Tap \_\_\_\_\_ Size and Type of Sewer \_\_\_\_\_ Street to be Opened \_\_\_\_\_  
 yes no \_\_\_\_\_ yes no

Storm Sewer Tap \_\_\_\_\_ Size of Tap \_\_\_\_\_ Size and Type of Sewer \_\_\_\_\_ Street to be Opened \_\_\_\_\_  
 yes no \_\_\_\_\_ yes no

Street opening Agreement Approval Date \_\_\_\_\_ Opening Bond Fee (Set by Engineer) \_\_\_\_\_

READ AND SIGN BELOW; The undersigned hereby agrees complete the work described above and to make use of said sewers only as allowed by and in strict accordance with all applicable provisions of The Napoleon Engineering Dept. Rules and Regulations, The Napoleon Standard Specification for Water Main, Sanitary Sewer and Storm Sewer Construction and other Pertinent Sections of the Napoleon Code of Ordinances.

Date 1-21-92 Signature of Applicant Judson Sipple  
Permit not valid without signature

INSPECTION RECORD \_\_\_\_\_ to be completed by the Field Inspector

Date Inspection is made \_\_\_\_\_ Size and Type of Sewer \_\_\_\_\_

Location \_\_\_\_\_ Depth \_\_\_\_\_ Type of Test \_\_\_\_\_ Additional Information \_\_\_\_\_


Date \_\_\_\_\_ Inspected By \_\_\_\_\_ signature of inspector

Sketch Of Installation on Back or Attached

**PAID**

JAN 21 1992

CITY OF NAPOLEON

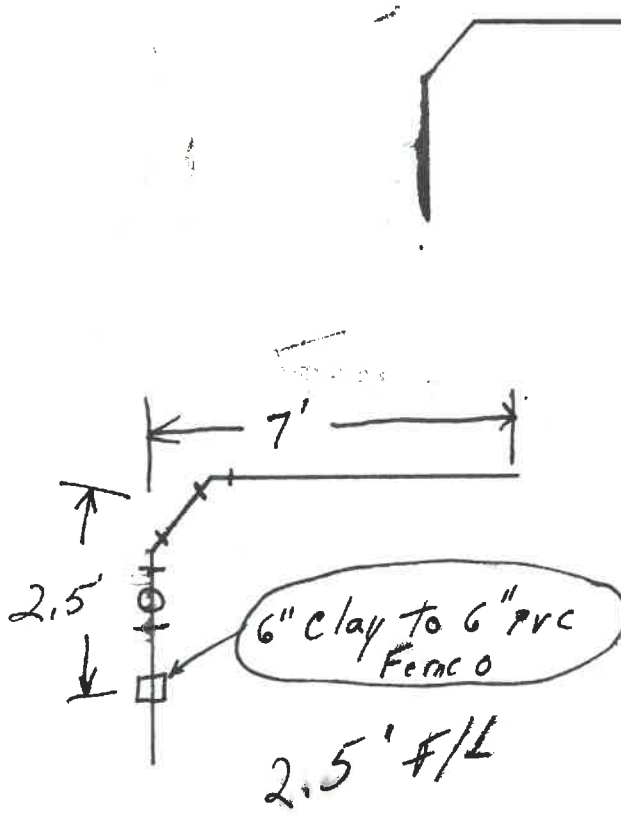

Sump Pit  
1-21-92

inspected  
1-21-92

PAID  
CITY OF BOSTON  
WATER DEPARTMENT