

WATER TAPPING PERMIT

issued by

The Napoleon Water Distribution Department

255 West Riverview Ave. Napoleon, Ohio 43845 Ph. 592-4010

Entry No. _____

Permit No. W-584-91 Issued 4-25-91 Received of Cheryl Beck (\$ 375.00) .00

(Charge for tapping permit to supply water service to) Lot No. 25 Sub Div. Brickyard Subdivision

Street No. ~~15000 Harmony~~ 925 Harmony Tap Size _____ * Cost \$ 375 .00 Plumber Meyers


Date completed _____ Approved by _____
water distribution dept. finance director

Name _____ Size of tap _____ Date _____ Street and No. _____


Old Tap No. _____ New Tap No. _____ Size and Kind of Main _____

Location of Main _____ Depth of Main _____


Distance from Hydrant/Valve _____ Distance to Curb Stop from Corp. _____

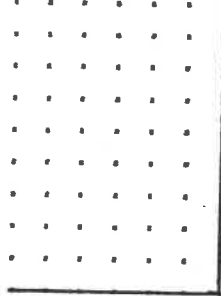


.st.

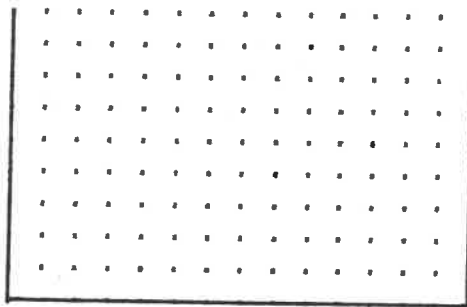


.st.

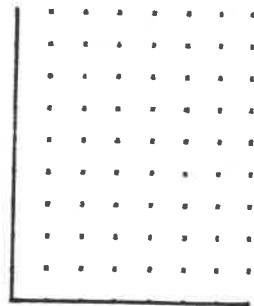


.st.

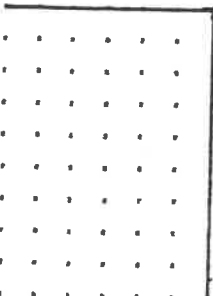

.st.

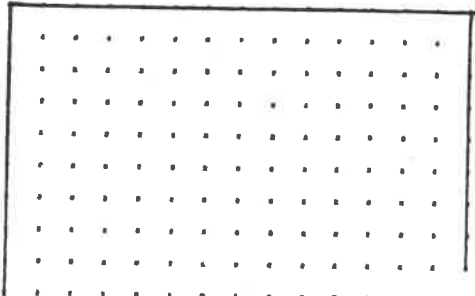

.st.

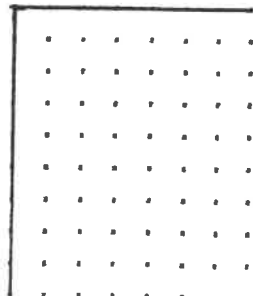

METER SOCKET RELEASE

issued by

The Napoleon Electric Distribution Department

639 Industrial Drive Napoleon, Ohio 43545 Pn. 592-9116 or 592-4010

Entry No. _____

Permit No. 0076-90 Issued 5-21-91 Building permit No. 02243 Job Address 925 Harmony

Lot Number 25 Sub Division Brickyard Yard

Owner Robert Heft Owners Address 125 West Washington Pn. No. _____

Contractor Becks Construction Contractors Address 11-622 Co. Rd. m Pn. No. _____


Size of Service 200 Overhead _____ Underground X Issued By Brent N Dammma

Date completed _____ Approved by _____

Size of Service _____ Overhead _____ Underground _____ Street and No. _____ electric distribution dept.

Old Meter No. _____ New Meter No. _____ Remarks _____

Sketch of Service

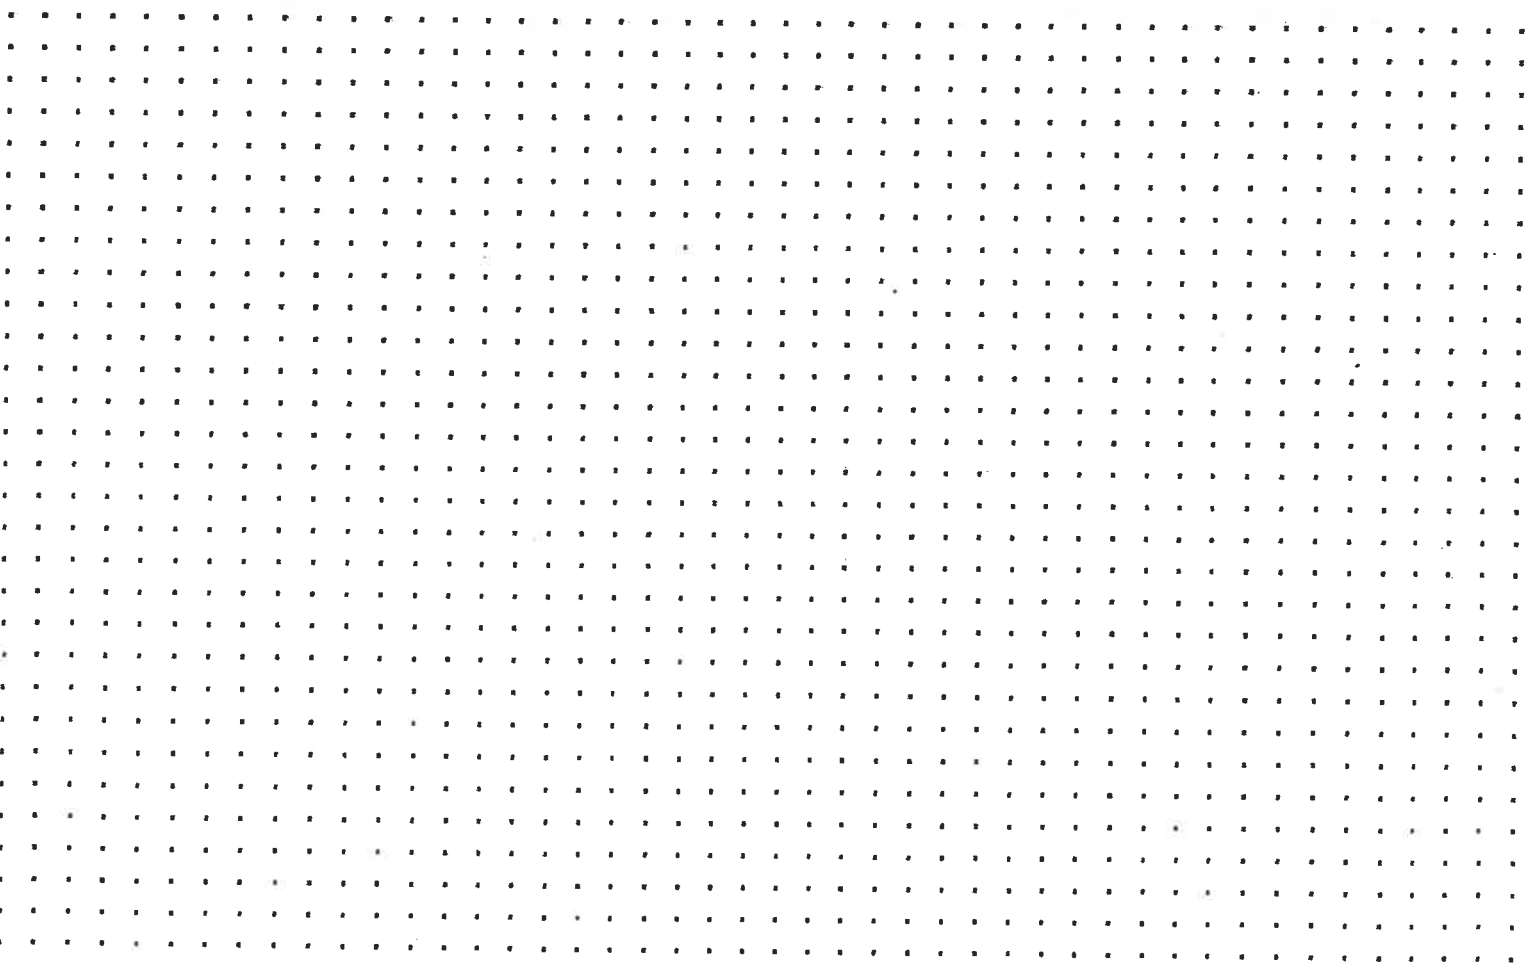

WATER TAPPING PERMIT

issued by

The Napoleon Water Distribution Department

255 West Riverview Ave. Napoleon, Ohio 43545 Pn. 592-4010

Entry No. _____

Permit No. W-588-91 Issued 5-28-91 Received of Robert Beck (\$ 375) .00

(Charge for tapping permit to supply water service to) Lot No. 25 Sub Div. Brickyard

Street No. 925 Harmony Tap Size 1" Cost \$ 375 .00 Plumber Meyers P+H


Date completed _____ Approved by _____
water distribution dept. finance director

Name _____ Size of tap _____ Date _____ Street and No. _____

Old Tap No. _____ New Tap No. _____ Size and Kind of Main _____

Location of Main _____ Depth of Main _____

Distance from Hydrant/Valve _____ Distance to Curb Stop from Corp. _____

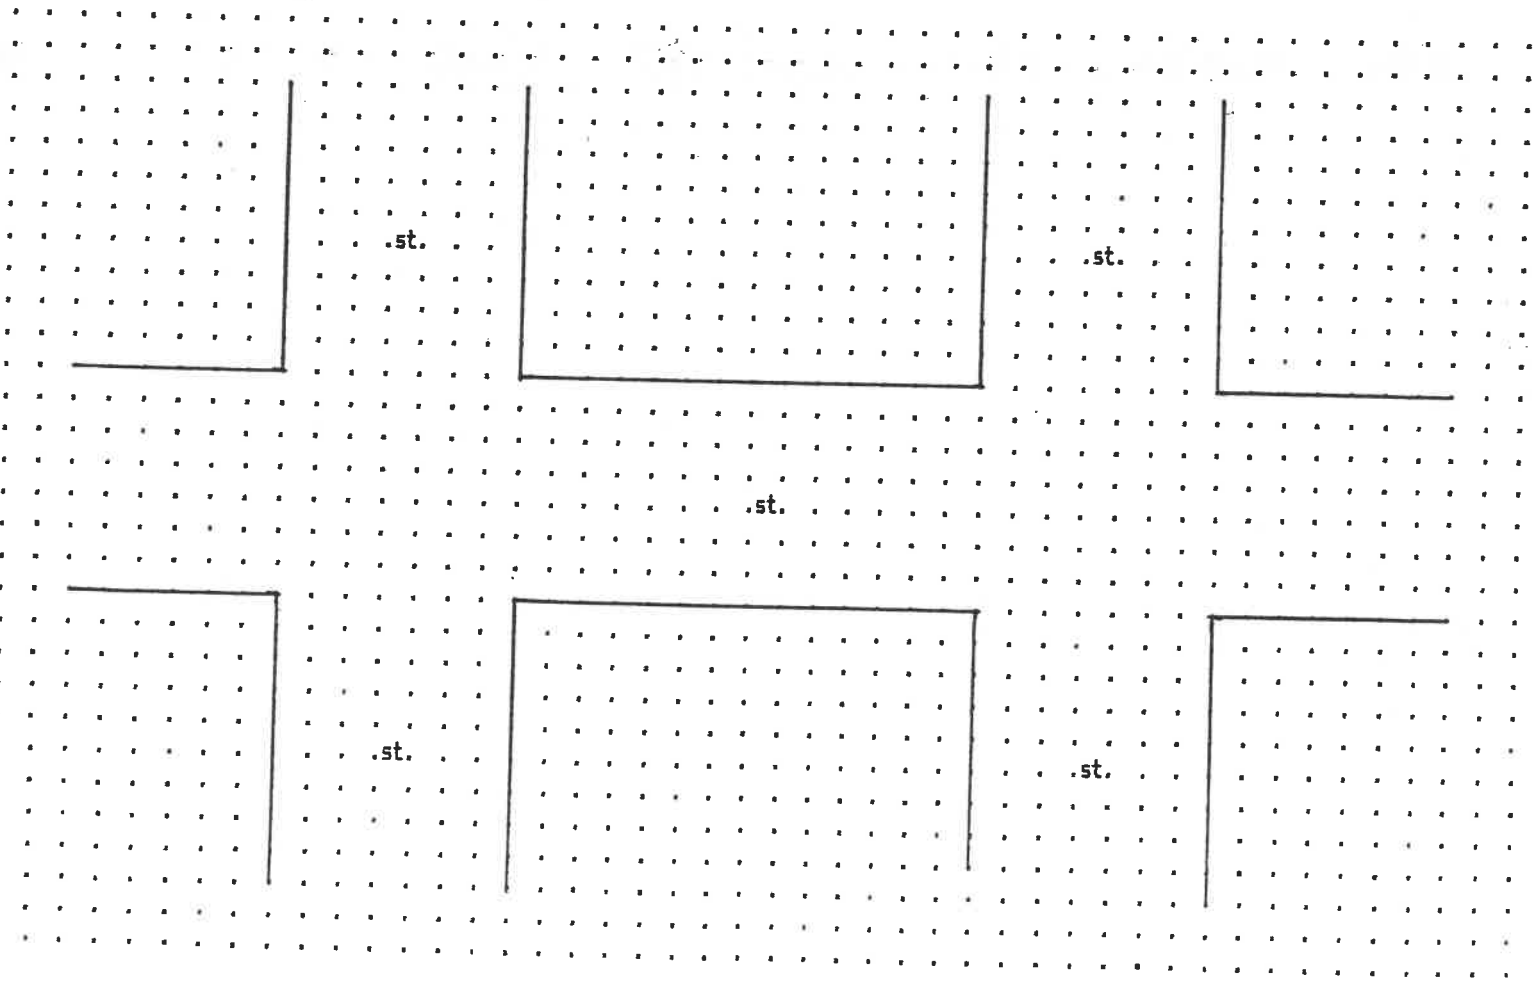

Long

WATER TAPPING PERMIT

issued by

The Napoleon Water Distribution Department

255 West Riverview Ave. Napoleon, Ohio 43545 Ph. 592-4010

Entry No. _____

Permit No. W-284-91 Issued 4-25-91 Received of Cheryl Beck (\$ 375.00) .00

(Charge for tapping permit to supply water service to) Lot No. 25 Sub Div. Brickyard Subdivision

Street No. ~~XXXXXXXXXXXX~~ Tap Size _____ Cost \$ 375 .00 Plumber Meyer's
925 Harmony


Date completed _____ Approved by _____
water distribution dept. finance director

Name _____ Size of tap 1" Date 6-4-91 Street and No. 925 Harmony

Old Tap No. _____ New Tap No. 9128 Size and Kind of Main 12" PVC

Location of Main 18 1/2' north of north curb Depth of Main 5'

Distance from Hydrant/Well 79' from Hyd #391 Distance to Curb Stop from Corp. 61'

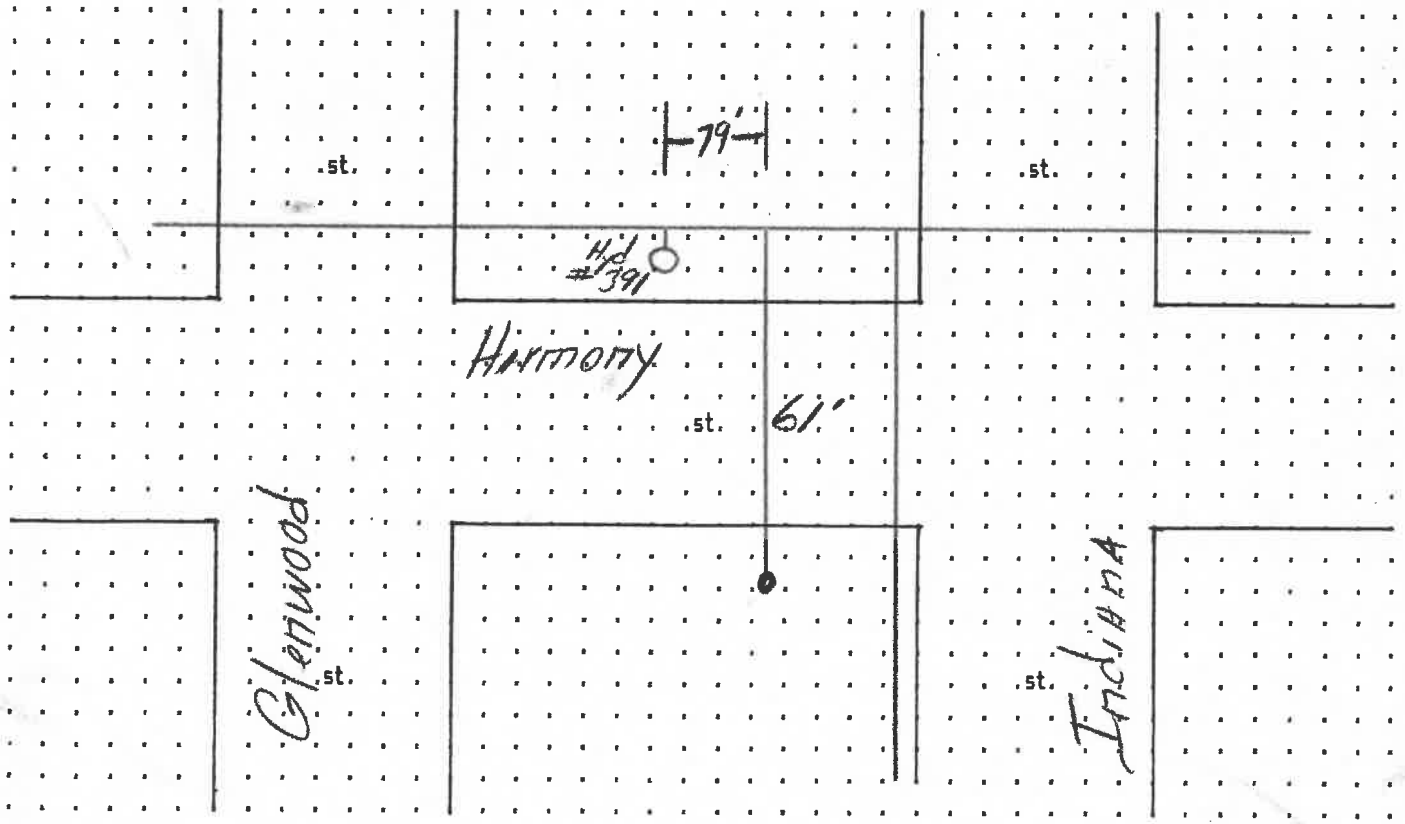

WATER TAPPING PERMIT

issued by

The Napoleon Water Distribution Department

255 West Riverview Ave. Napoleon, Ohio 43545 Ph. 592-4010

Entry No. _____

Permit No. W-384 91 issued 4-25-91 Received of Chris Beck (\$ 375.00)

(Charge for tapping permit to supply water service to) Lot No. 25 Sub Div. Backyard Subdivision

Street No. 725 Harmony Tap Size _____ Cost \$ 375 .00 Plumber Meyer's


Date completed _____ Approved by _____
water distribution dept. finance director

Name _____ Size of tap 1" Date 6-9-91 Street and No. 725 Harmony

Old Tap No. _____ New Tap No. 9128 Size and Kind of Main 12" PVC

Location of Main 18' 2" north of curb Depth of Main 5'

Distance from Hydrant/Valve 77' from Hyd # 391 Distance to Curb Stop from Corp. 41'

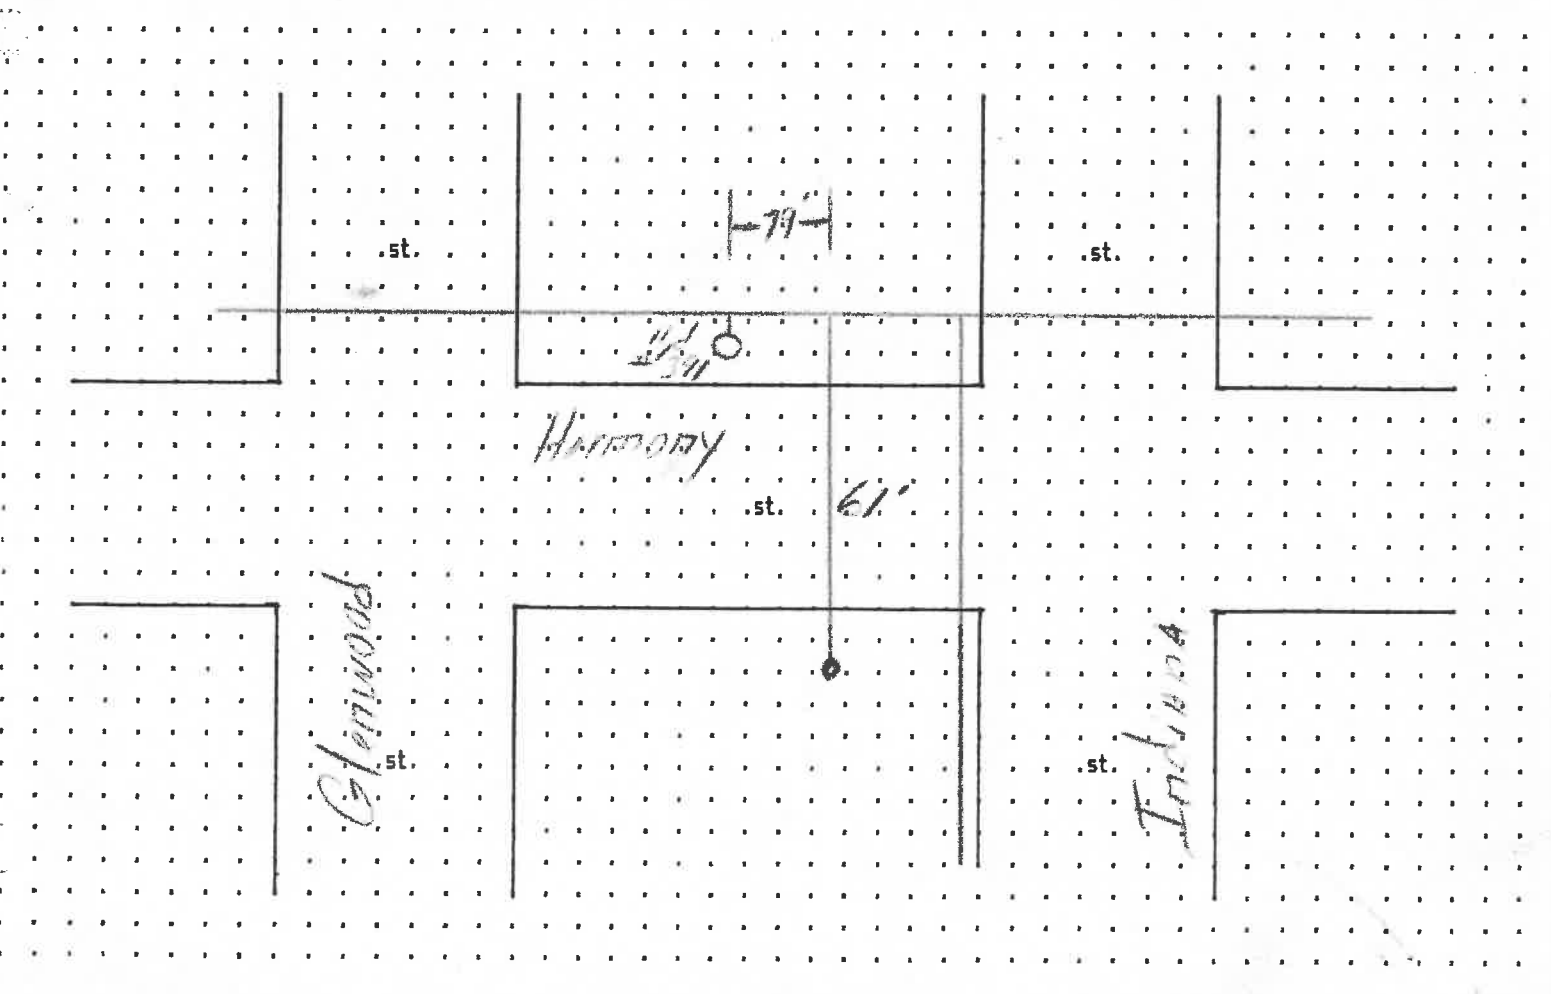

WATER TAPPING PERMIT

issued by

The Napoleon Water Distribution Department

255 West Riverview Ave. Napoleon, Ohio 43545 Pn. 592-4010

Entry No. _____

Permit No. 1-3411 Issued 1-20-71 Received of _____ (\$ _____).00

(Charge for tapping permit to supply water service to) Lot No. 5 Sub Div. Park

Street No. 12500 DORR Tap Size _____ * Cost \$ 575.00 Plumber Mayer

Date completed _____ Approved by _____

water distribution dept.

finance director

Name _____ Size of tap 1" Date 1-21-71 Street and No. 12500 DORR

Old Tap No. _____ New Tap No. 1129 Size and Kind of Main 12" PVC

Location of Main 4" 71" 71" 71" Depth of Main 5'

Distance from Hydrant/Valve 77' - 41" 71" Distance to Curb Stop from Corp. 11'

