

SEWER TAPPING PERMIT

Issued by

The City of Napoleon Engineering Dept.

255 West Riverview Ave. Napoleon, Ohio 43545 Pn. 592-4010

Entry No. _____

Permit No. **00413** Issued 7/28/92 Build. Permit No. _____

Job Location 412 Huddle Rd

Lot _____

Issued By BND sub div. or legal disc.

Owner Lynn Bud Shaw Pn. 592-5613

Address 412 Huddle Rd.

Agent Mort Cordes Pn. 758-3855

Address Co. Rd. P-1

Permit Fee \$ 35.00

Street Bond \$ _____

Date Paid 7-29-92

for office use only

WORK INFORMATION

Sanitary Sewer Tap _____ Size of Tap _____ Size and Type of Sewer _____ Street to be Opened _____
yes no

Storm Sewer Tap _____ Size of Tap _____ Size and Type of Sewer _____ Street to be Opened _____
yes no

Street opening Agreement Approval Date _____ Opening Bond Fee (Set by Engineer) _____
yes no

READ AND SIGN BELOW; The undersigned hereby agrees complete the work described above and to make use of said sewers only as allowed by and in strict accordance with all applicable provisions of The Napoleon Engineering Dept. Rules and Regulations, The Napoleon Standard Specification for Water Main, Sanitary Sewer and Storm Sewer Construction and other Pertinent Sections of the Napoleon Code of Ordinances.

Date _____ Signature of Applicant Mort Cordes
Permit not valid without signature

INSPECTION RECORD _____ to be completed by the Field Inspector


Date Inspection is made 7-28-92 Size and Type of Sewer 4" PVC SDR

Location See sketch Depth _____ Type of Test _____ Additional Information replace old san. sewer service line disconnect footer tile from said line.


Date 7-28-92 Inspected By Burt M...man
signature of inspector

Sketch Of Installation on Back or Attached

PAID
JUL 29 1992
CITY OF NAPOLEON

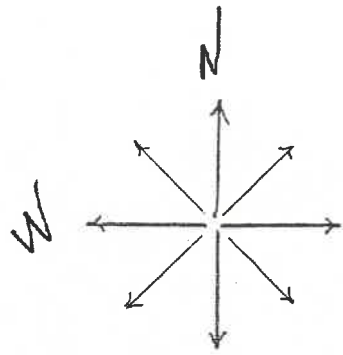


Date — 7-28-92
 Location — 412 Daggett
 Owner — Bud Shew
 Address — 412 Huddle
 Contractor — Mort Cordes
 Address —
 Work Discip. — Sanitary sewer
 replace as needed
 Footer file capped.

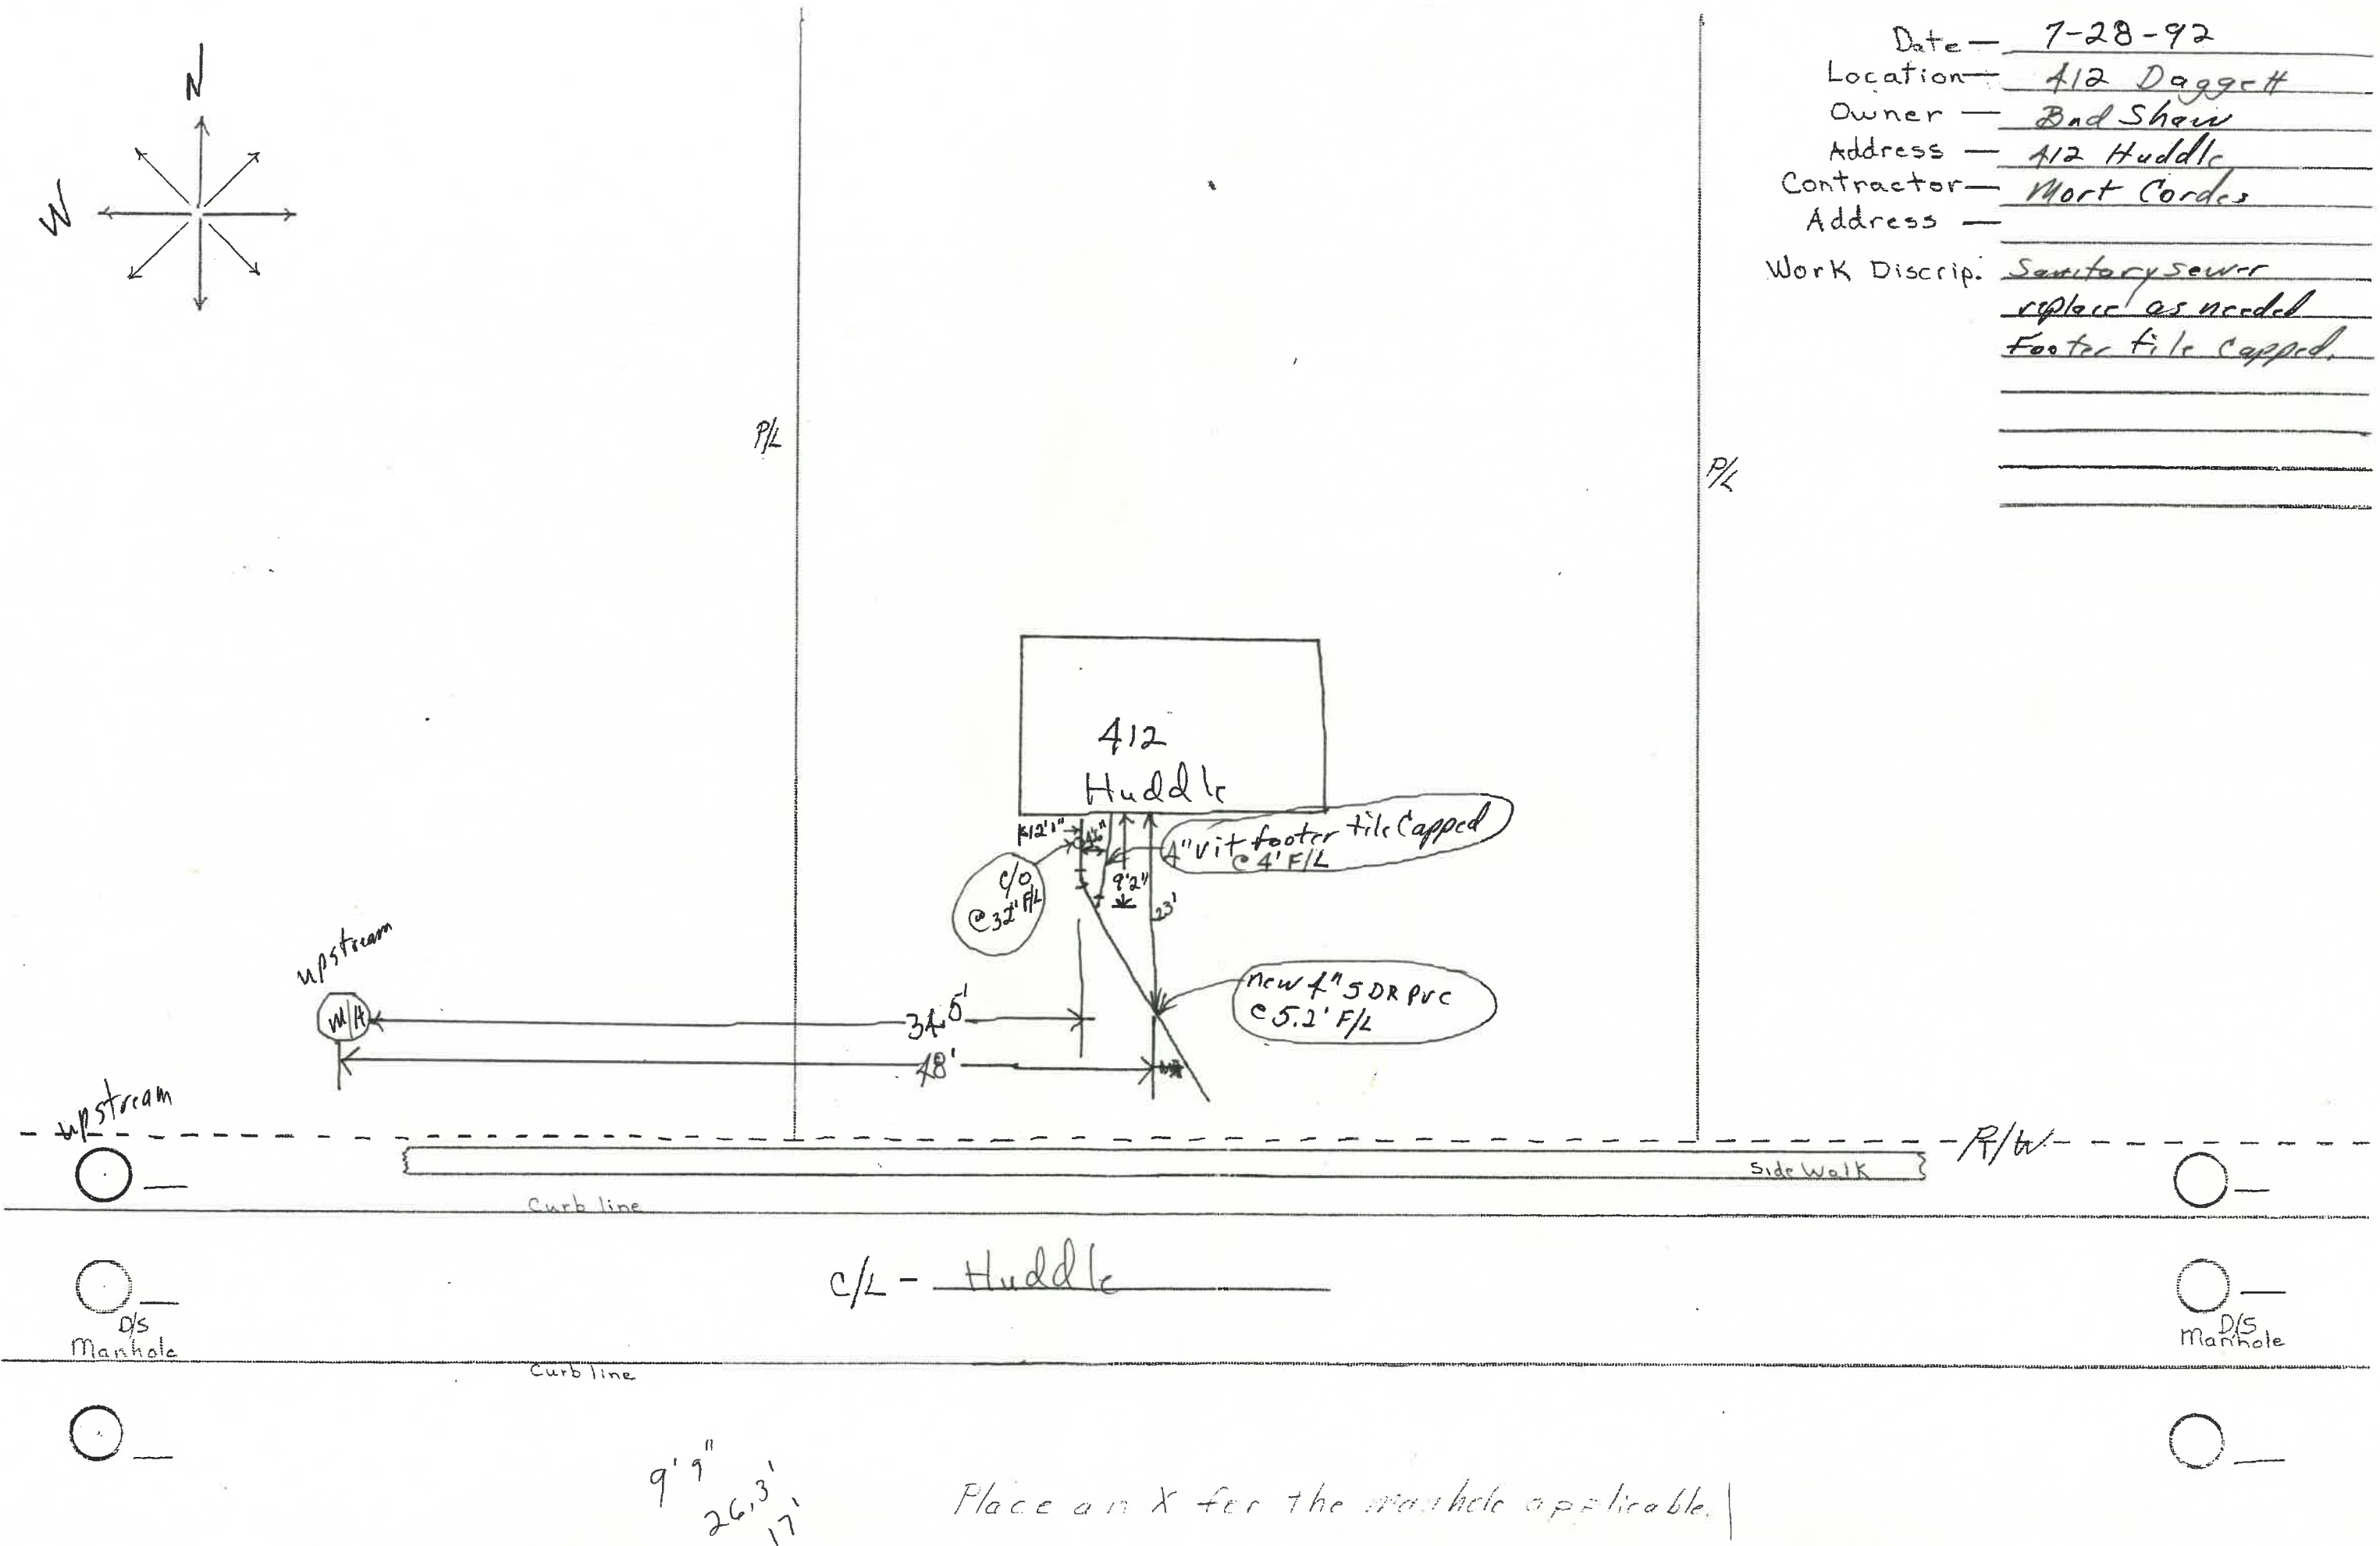


9'9" 26'3" 17"

Place an X for the manhole applicable.

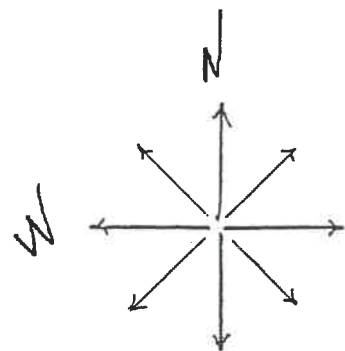


Date — 7-28-92
 Location — 412 Daggett
 Owner — Bud Shaw
 Address — 412 Huddle
 Contractor — Mort Cordes
 Address —
 Work Discrip. — Sanitary sewer
 replace as needed
 Footer tile capped,

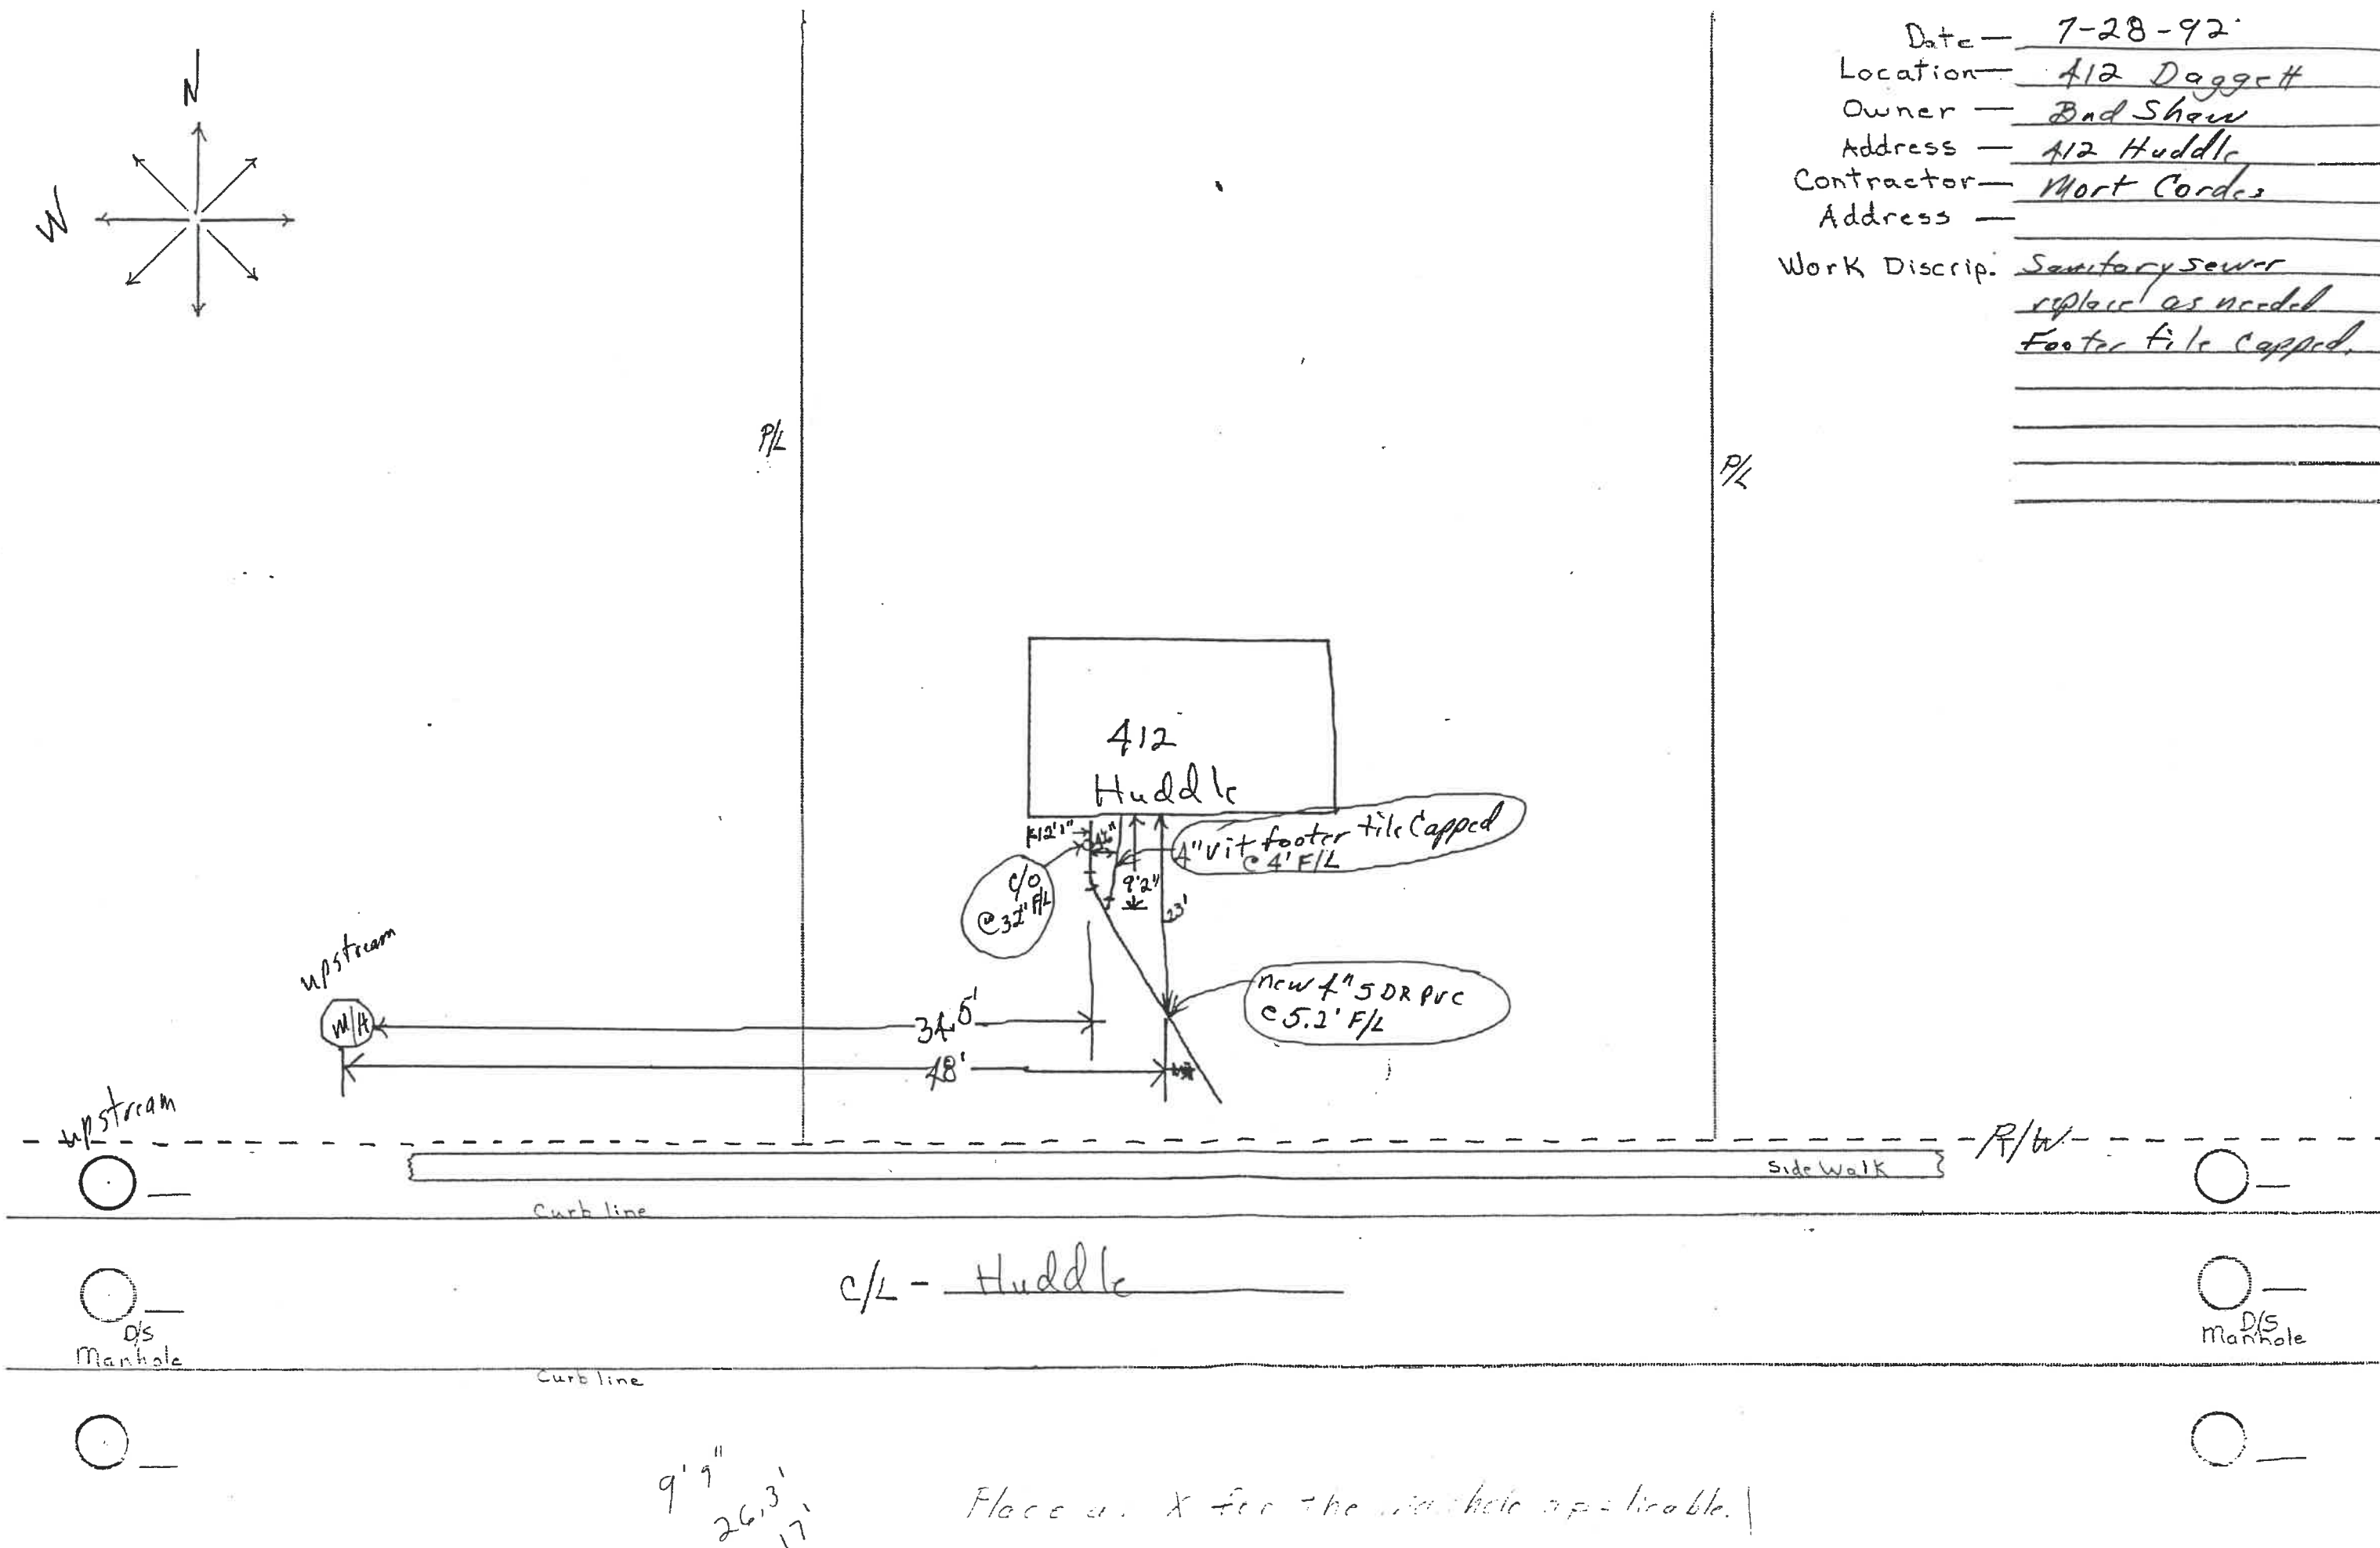


9' 9"
 26' 3"
 17'

Place an X for the manhole as applicable.

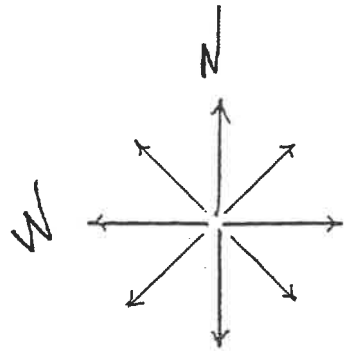


Date — 7-28-92
 Location — 412 Daggett
 Owner — Bud Shaw
 Address — 412 Huddle
 Contractor — Mort Cordes
 Address —
 Work Discip: Sanitary sewer
 replace as needed
 Footer tile capped.

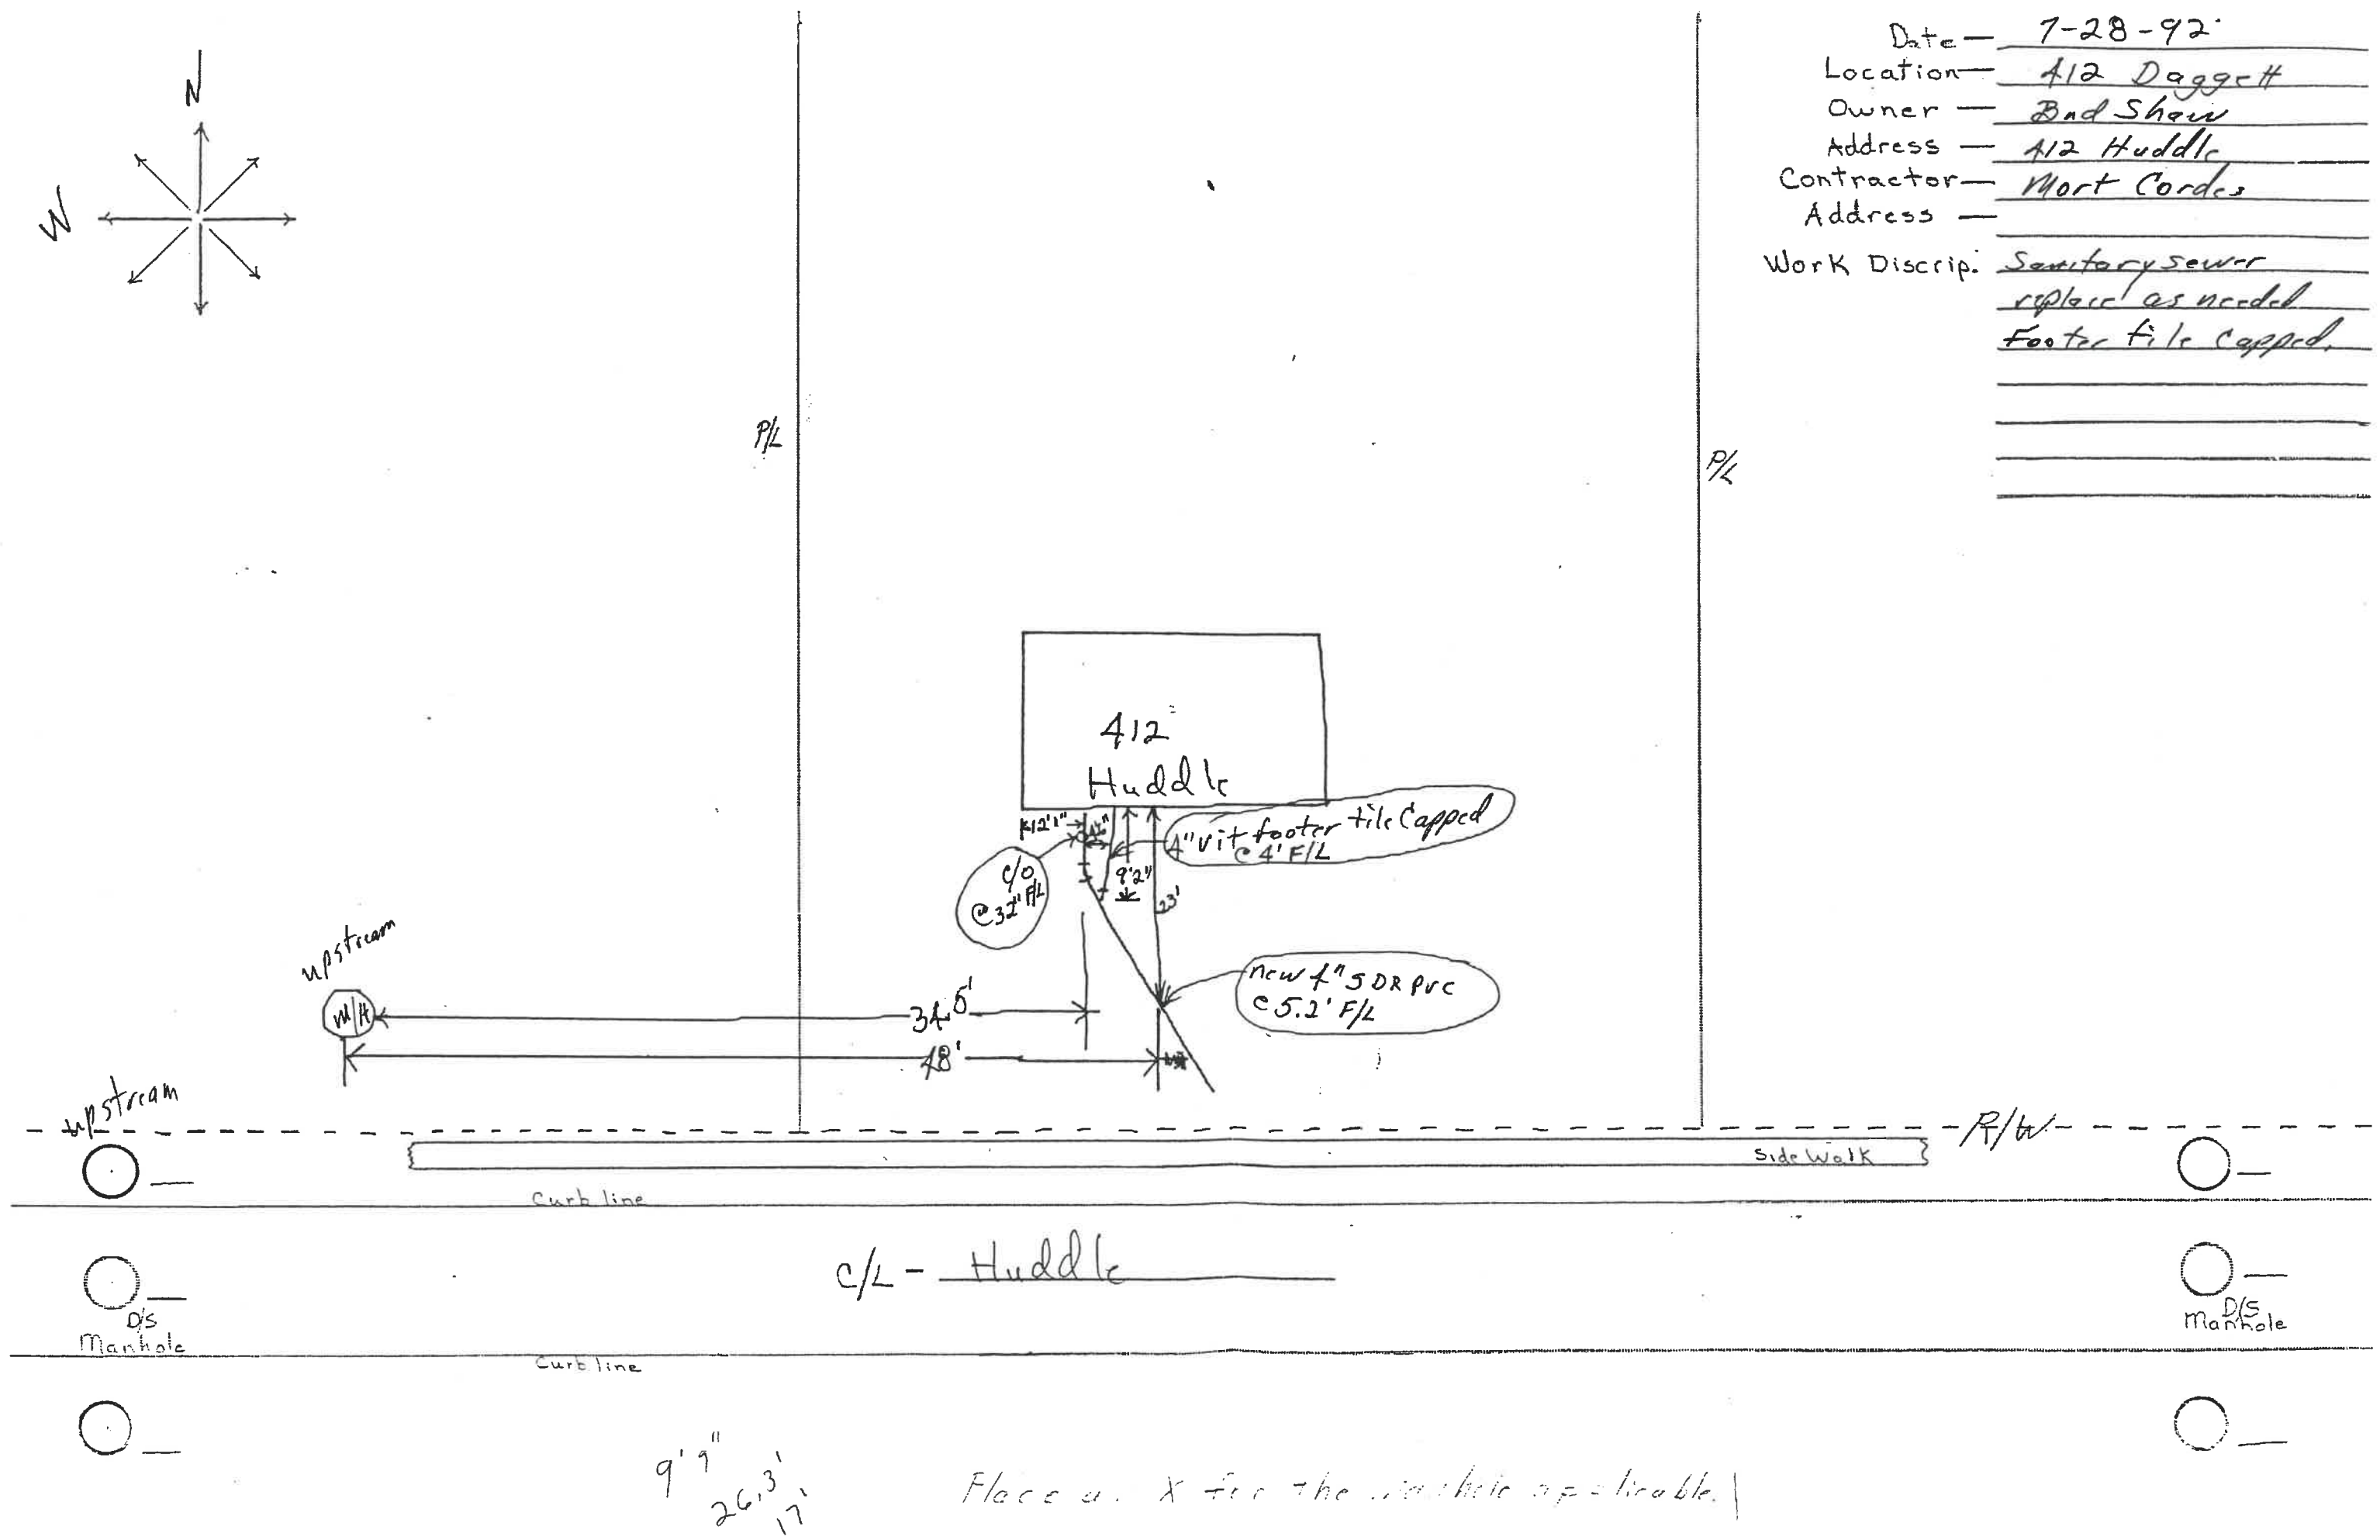


9' 9"
 26' 3"
 17'

Place an X for the manhole if applicable.

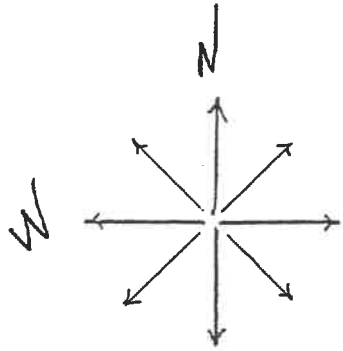

Date — 7-28-92
 Location — 412 Daggett
 Owner — Bud Shaw
 Address — 412 Huddle
 Contractor — Mort Cordes
 Address —
 Work Discrip: Sanitary sewer
 replace as needed
 Footer tile capped.

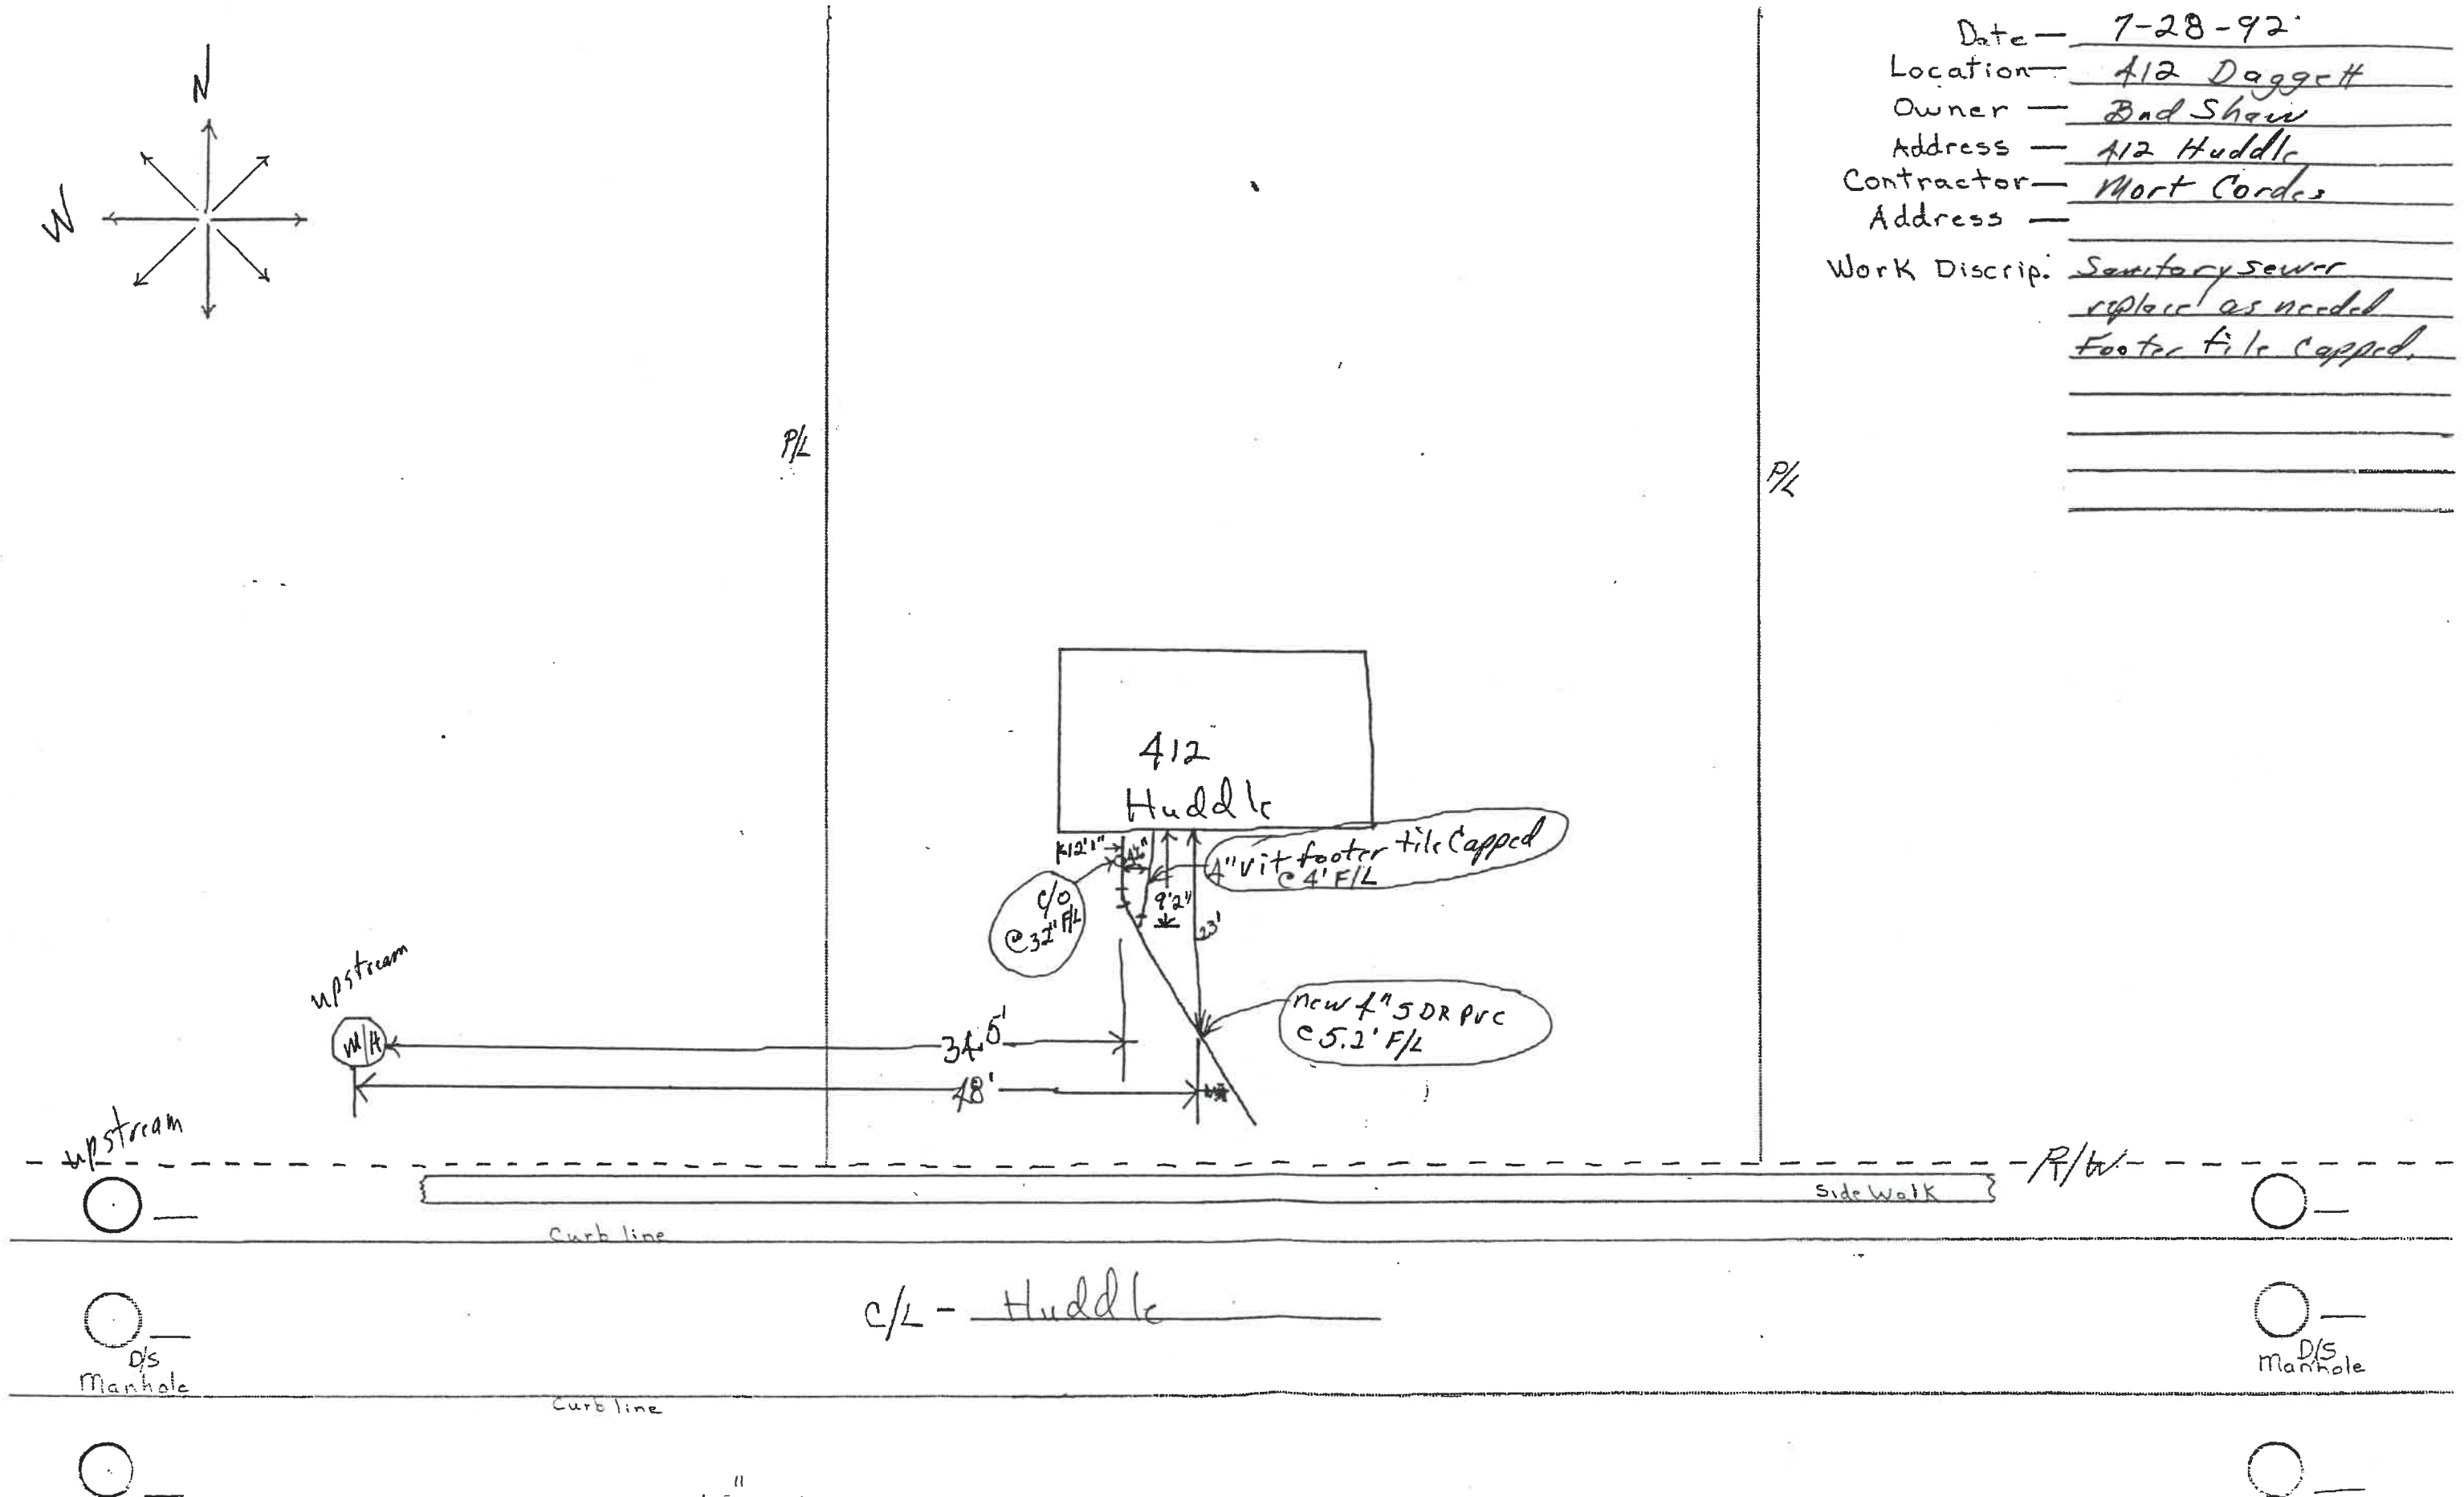

9' 9"
 26.3'
 17'

Place an X for the manhole if applicable.