




DATE: _____
 BY: _____
 SURVEYED: _____
 PLOTTED: _____
 CHECKED: _____
 NOTE BOOK NO. _____
 STRUCTURE NOTATIONS CHND

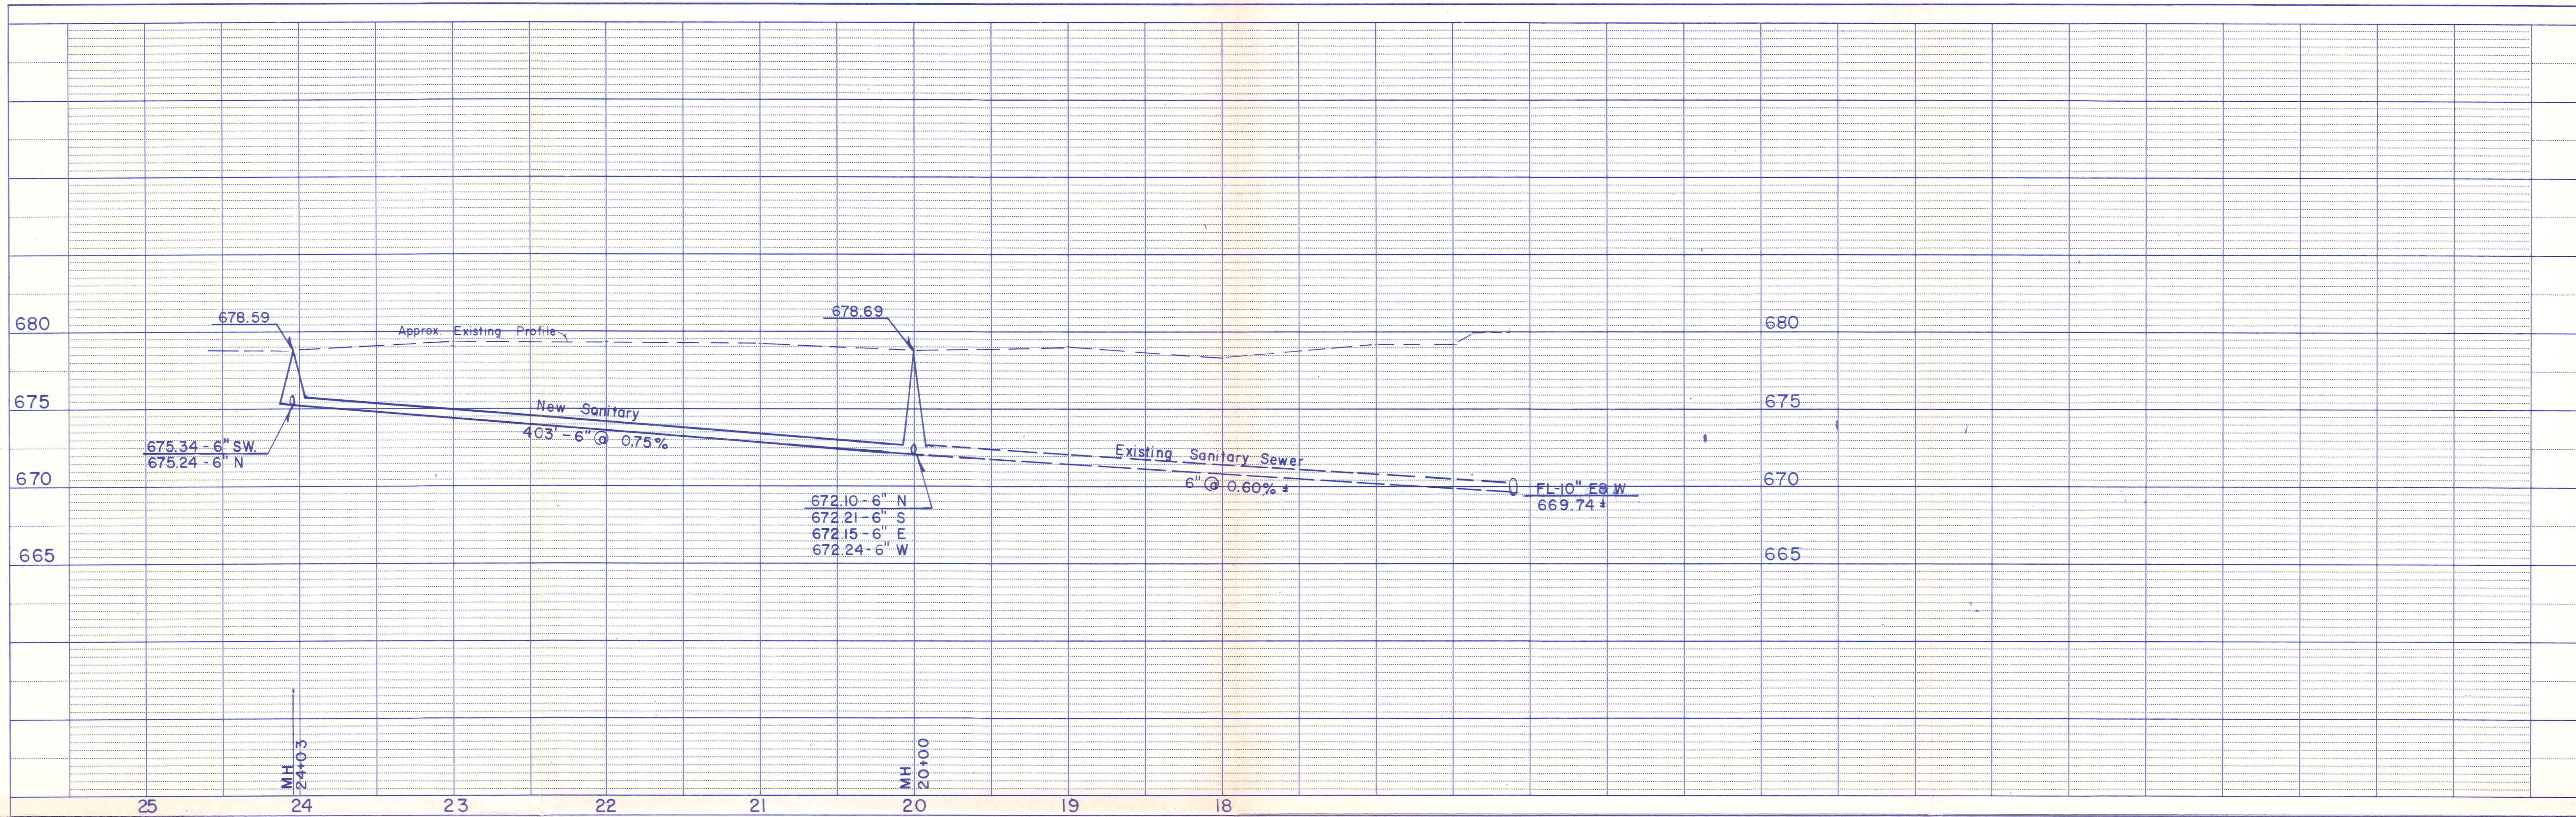

DATE: _____
 BY: _____
 SURVEYED: _____
 PLOTTED: _____
 CHECKED: _____
 NOTE BOOK NO. _____
 RT. OF WAY CHECKED

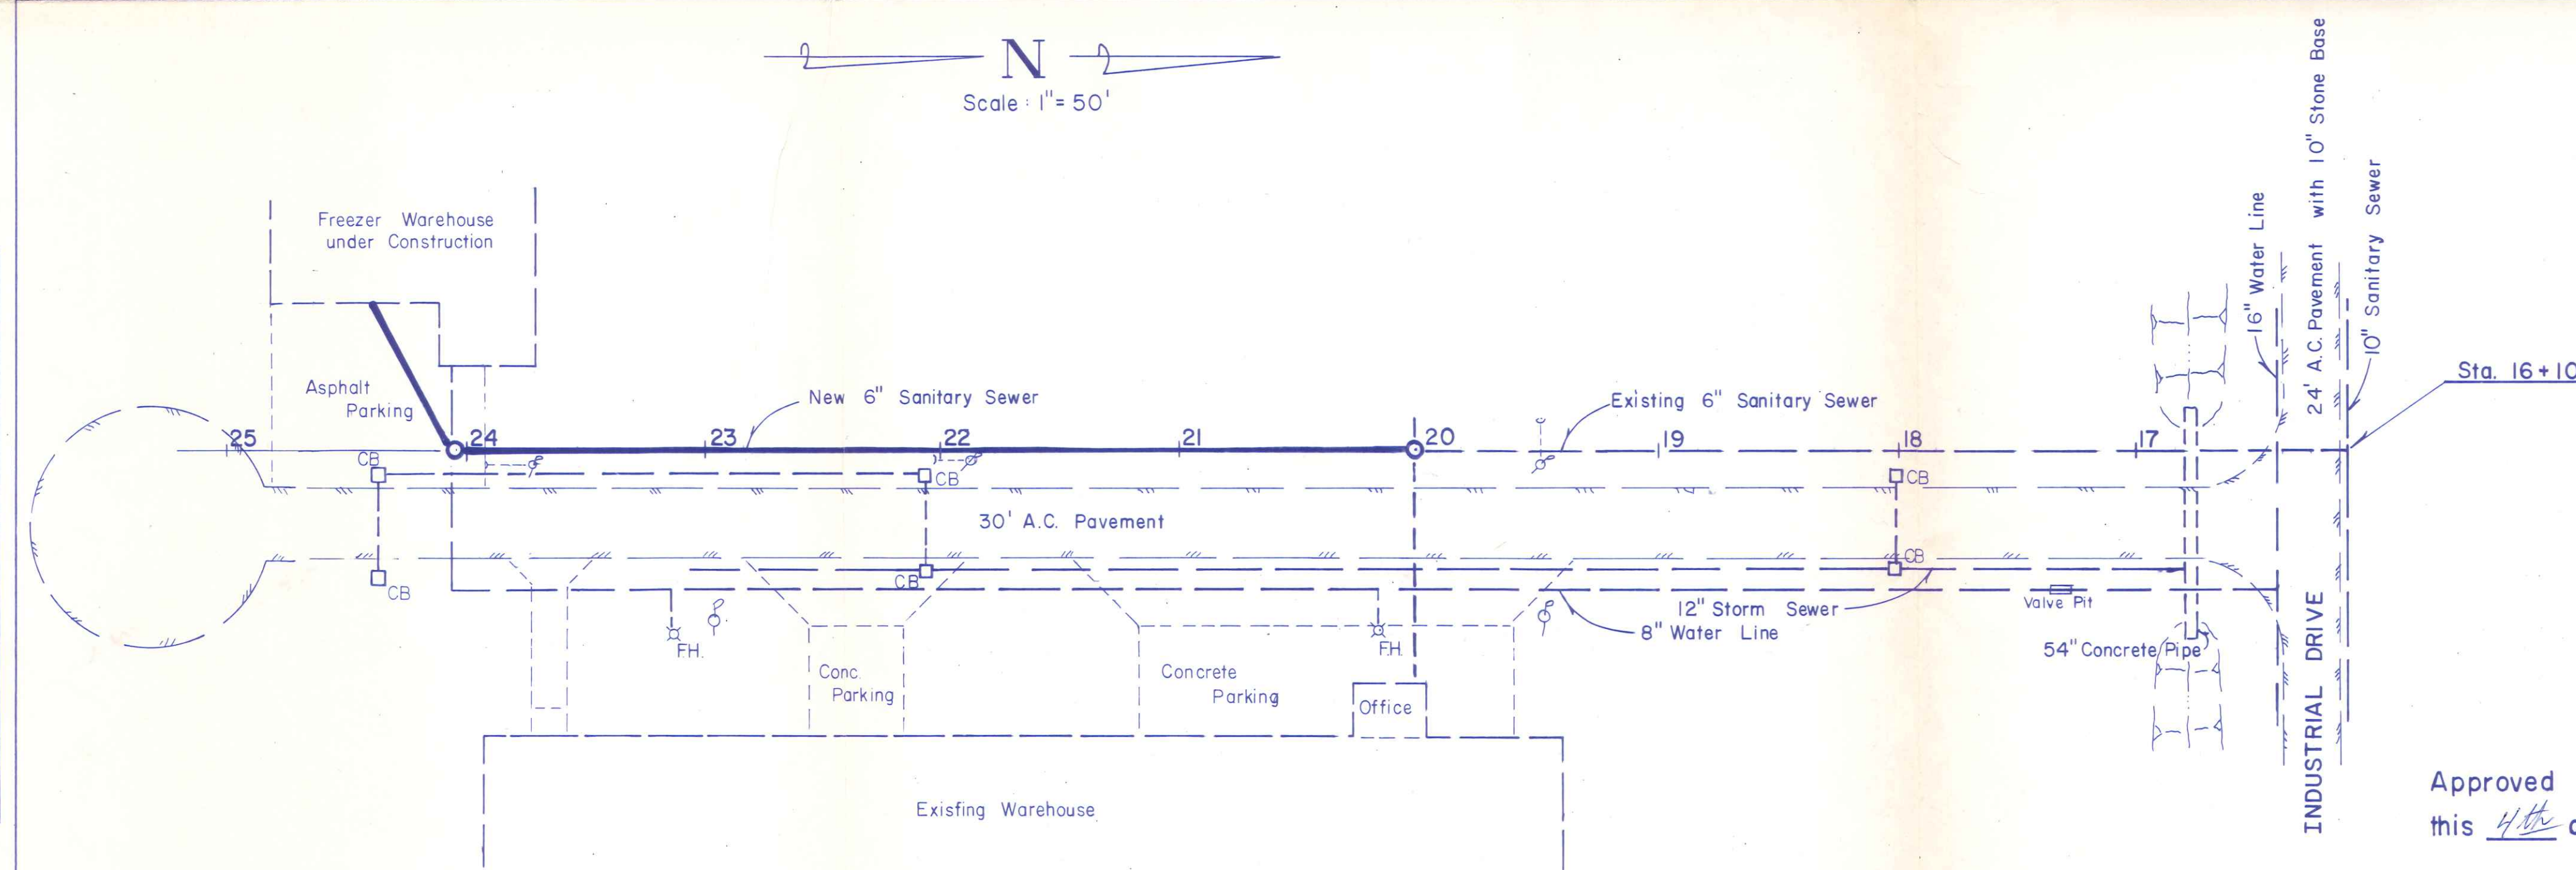

Scale: 1" = 50'

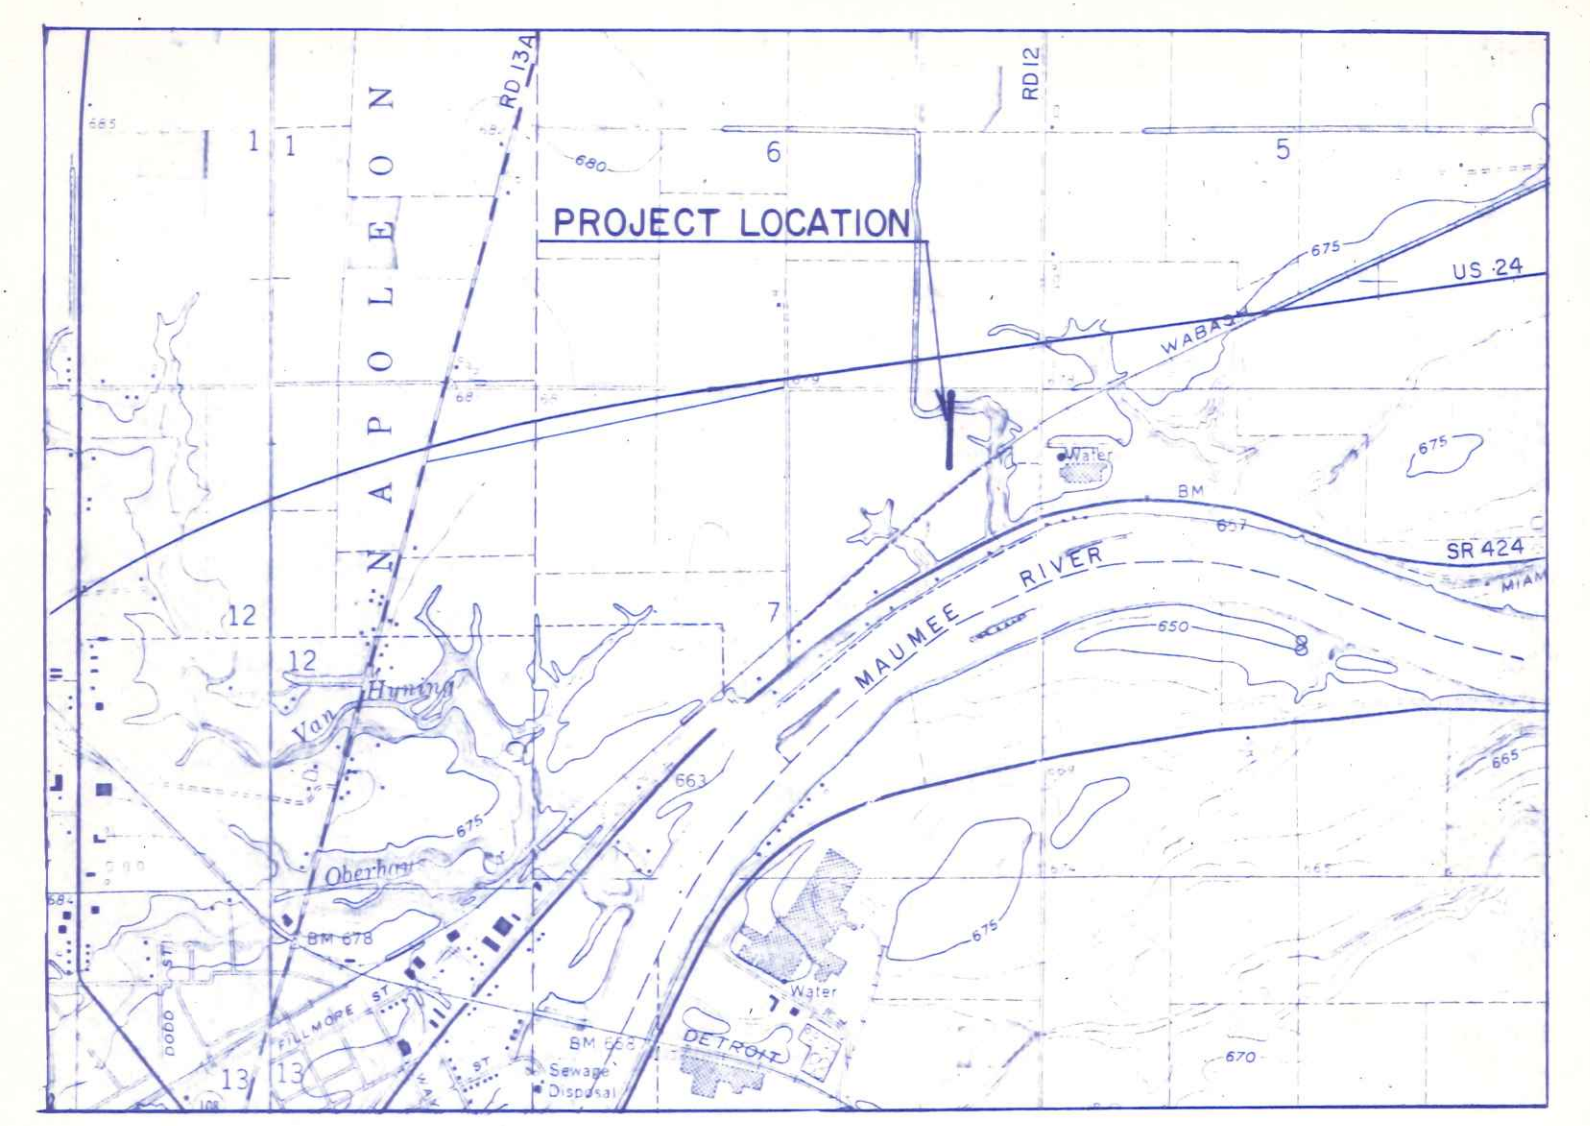

Approved by Napoleon Warehouse, Inc.
 this 4th day of March, 1977.

Napoleon Warehouse Inc.
 By Robert Bauman
 Title Sec. - Treas.

Approved by the City of Napoleon, Ohio
 this 4 day of March, 1977.

Dr. R. Bishop
 City Manager

LOCATION MAP
 Scale: 1" = 2000'

CITY OF NAPOLEON, OHIO

NAPOLEON WAREHOUSE INC.

SEWER EXTENSION
 AS-BUILT PLAN

E. C. Gerken & Associates
 Consulting Engineers & Surveyors
 Defiance, Ohio

Engineer
 P.E. 31410
 Feb. 1, 1977