

# CITY OF NAPOLEON ZONING CERTIFICATE

Hogrefe, Inc.  
Independence Dr.

Certificate No. 270  
Issued 02/18/94  
By Brent N. Damman  
Zoning Inspector  
Filing Fee \$5.00 2-21-94  
Amount Date Paid

Subdivision G & B Subdivision  
(or Legal Description)  
50 X 636.57 Yard Set Back: Front 15 Rear 0  
636.66 Sq. Ft. Side West - 30 Side East - 0

Industrial  
Description of Use Ryder semi tractor trailer  
and Associated use. trailer Leasing,  
Off Street Parking Spaces Required 1 - space employer  
1 - space per customer  
Loading Spaces Required

no  
02/18/94 Board of Zoning Appeals N/A

Applicant Signature Barbara Hogrefe  
(Owner-Agent)  
Applicant  
Yellow - Board of Zoning Appeals  
Pink - Engineering

SEWER TAPPING PERMIT

Issued by

The City of Napoleon Engineering Dept.

255 West Riverview Ave. Napoleon, Ohio 43545 Ph. 592-4010

Entry No. \_\_\_\_\_

Permit No. 10248 Issued 3-14-94 Build. Permit No. \_\_\_\_\_

Permit Fee \$ 130.00

Job Location 515 Independence

Street Bond \$ \_\_\_\_\_

Lot \_\_\_\_\_

Date Paid \_\_\_\_\_

Issued By BND sub div. or legal disc. \_\_\_\_\_

Owner Eugene Hogrefe Pn. 592-2831

Address 1600 Oakwood Ave

Agent Fox Chase Inc. Pn. 445-3008

Address 2001 S. Defiance Lot 300  
Archbold, Ohio

for office use only  
.....

WORK INFORMATION

Sanitary Sewer Tap  \_\_\_\_\_ Size of Tap 6" Size and Type of Sewer Main 12" PVC SDR Street to be Opened  \_\_\_\_\_  
yes no yes no

Storm Sewer Tap \_\_\_\_\_ Size of Tap \_\_\_\_\_ Size and Type of Sewer \_\_\_\_\_ Street to be Opened \_\_\_\_\_  
yes no yes no

Street opening Agreement Approval Date \_\_\_\_\_ Opening Bond Fee (Set by Engineer) \_\_\_\_\_

READ AND SIGN BELOW; The undersigned hereby agrees complete the work described above and to make use of said sewers only as allowed by and in strict accordance with all applicable provisions of The Napoleon Engineering Dept. Rules and Regulations, The Napoleon Standard Specification for Water Main, Sanitary Sewer and Storm Sewer Construction and other Pertinent Sections of the Napoleon Code of Ordinances.

Date 3-14-94 Signature of Applicant Eugene Hogrefe  
Permit not valid without signature

INSPECTION RECORD \_\_\_\_\_ to be completed by the Field Inspector

Date Inspection is made \_\_\_\_\_ Size and Type of Sewer \_\_\_\_\_

Location \_\_\_\_\_ Depth \_\_\_\_\_ Type of Test \_\_\_\_\_ Additional Information \_\_\_\_\_

Date \_\_\_\_\_ Inspected By \_\_\_\_\_  
signature of inspector

Sketch Of Installation on Back or Attached

**PAID**  
APR 05 1994  
CITY OF NAPOLEON




3-11-94

Fox Chase (Contractor)

Burdette Pathage

Eugene Hogrefe (Owner)

Sonny Helberg - (Inspect.)

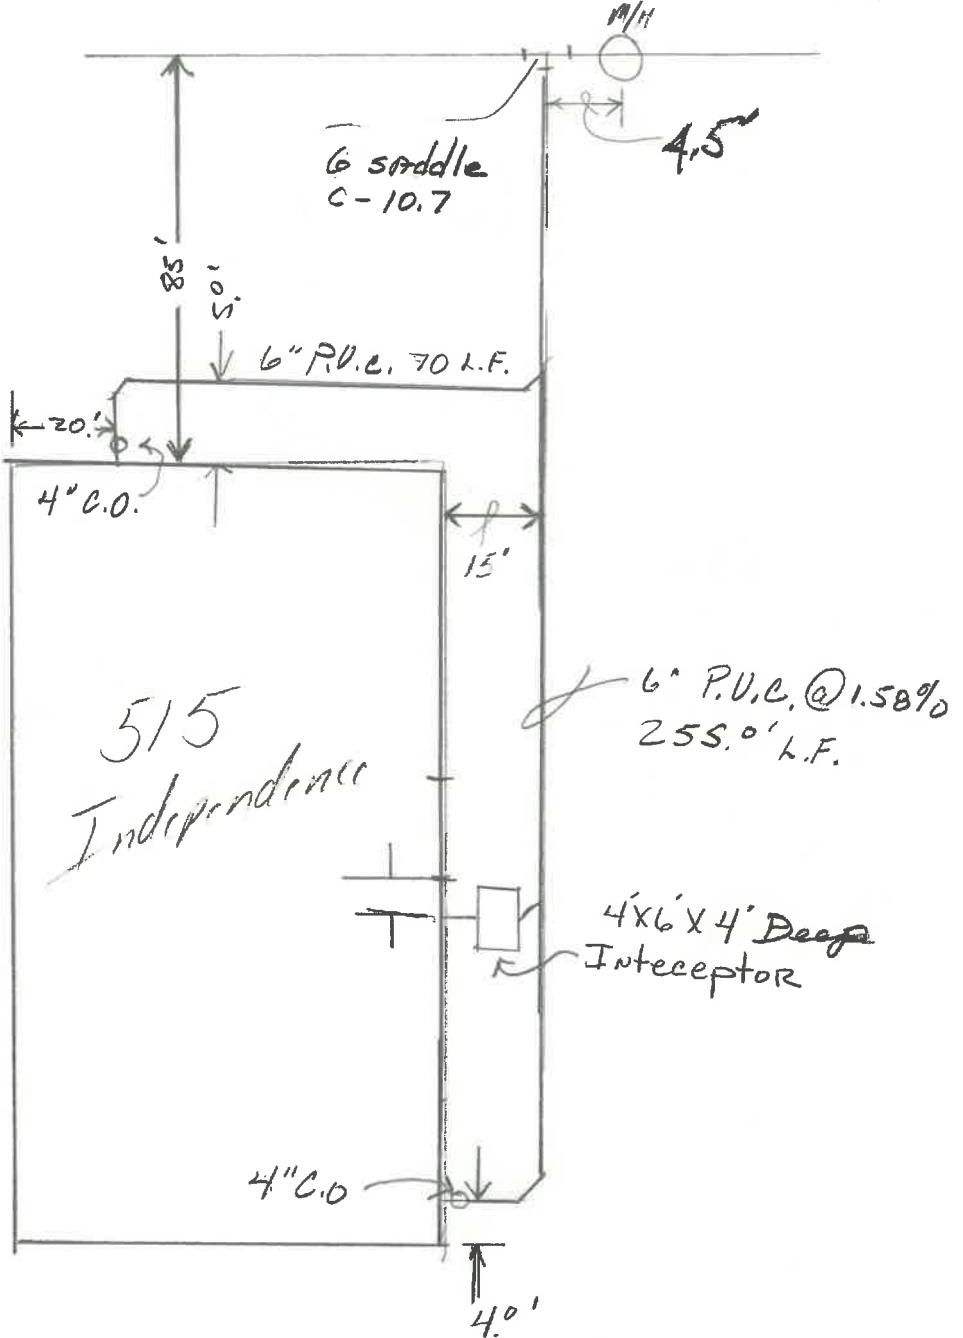

3-11-94

Fox Chase (Contractor)

Burdette Rathage

Eugene Hogrefe (Owner)

~~Inspector~~ (Inspector)

Sonny Helberg - Inspector




Brent:

Sonny Hogrefe didn't know anything about a permit, but will now be in at 11:00 this a.m. left you this copy to determine footage.

255  
70

6" P.V.C. 325 L.F.

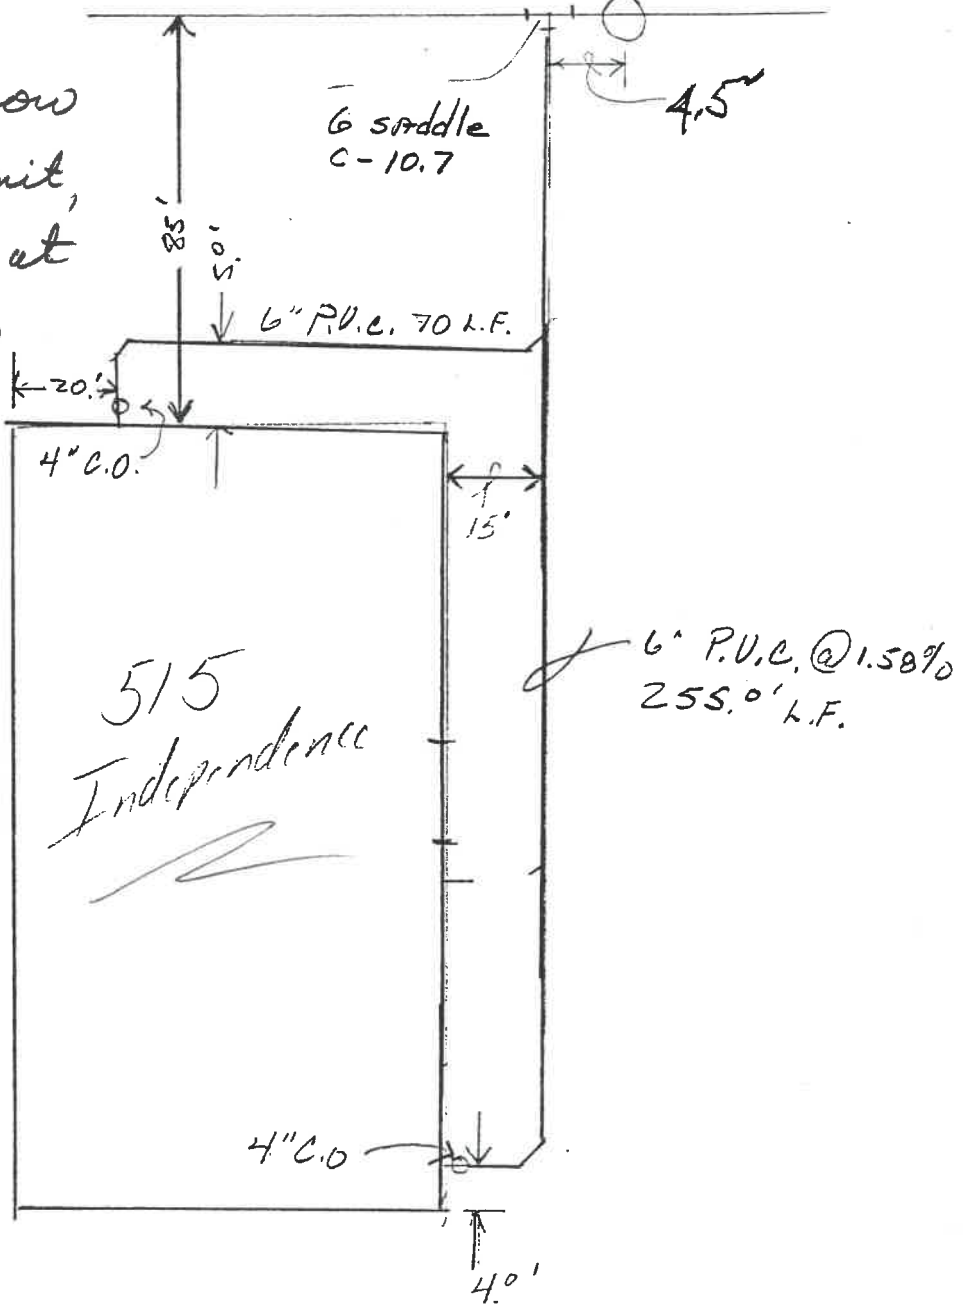

515  
Independence