

P E R M I T

CITY OF NAPOLEON
255 W. RIVERVIEW AVE
NAPOLEON, OHIO 43545

DIVISION OF BUILDING & ZONING
PH (419) 592-4010
FAX (419) 599-8393

PERMIT NO: 98247

DATE ISSUED: 08-04-98

ISSUED BY: BND

JOB LOCATION: 550 INDEPENDENCE DR

EST. COST: 1500.00

LOT #:

SUBDIVISION NAME:

OWNER: CULLIGAN
ADDRESS: 550 INDEPENDENCE DR
CSZ: NAPOLEON, OH 43545
PHONE: 419-592-7936

AGENT: HARMON SIGN COMPANY
ADDRESS: 7844 W CENTRAL AVE
CSZ: TOLEDO, OH 43617
PHONE: 419-841-6656

USE TYPE - RESIDENTIAL:

OTHER:

ZONING INFORMATION

DIST: LOT DIM: AREA: FYRD: SYRD: RYRD:
MAX HT: # PKG SPACES: # LOADING SP: MAX LOT COV:

BOARD OF ZONING APPEALS:

WORK TYPE - NEW: REPLMNT: ADD'N: ALTER: REMODEL:

WORK INFORMATION

SIZE - LGTH: WIDTH: STORIES: LIVING AREA SF:
GARAGE AREA SF: HEIGHT: BLDG VOL DEMO PERMIT:

WORK DESCRIPTION

SIGN (COPY BOARD ADD)

FEE DESCRIPTION	PAID DATE	FEE AMOUNT DUE
SIGN PERMIT		25.00

TOTAL FEES DUE 25.00

DATE

APPLICANT SIGNATURE



550 Independence



7844 W. Central Ave • Toledo, Oh 43617
Ph: 419-841-6656
Fax: 419-841-7160

FACSIMILE COVER SHEET

Date: 7/25/98

Time: 9:53 AM

Number of pages: 3 including cover sheet.

To: BRENT DAMMAN Firm: ZONING OFFICE

From: SCOTT BRADY Fax#: 599-8393

MESSAGE AREA

PLEASE REVIEW AND ADVISE


WHAT DO WE NEED TO DO TO MAKE
FORWARD ON CULLIGAN SIGN?

ADDITION OF COPY BOARD SIGN TO
ORIGINAL STRUCTURE

THANKS

SB

RESPONSE AREA

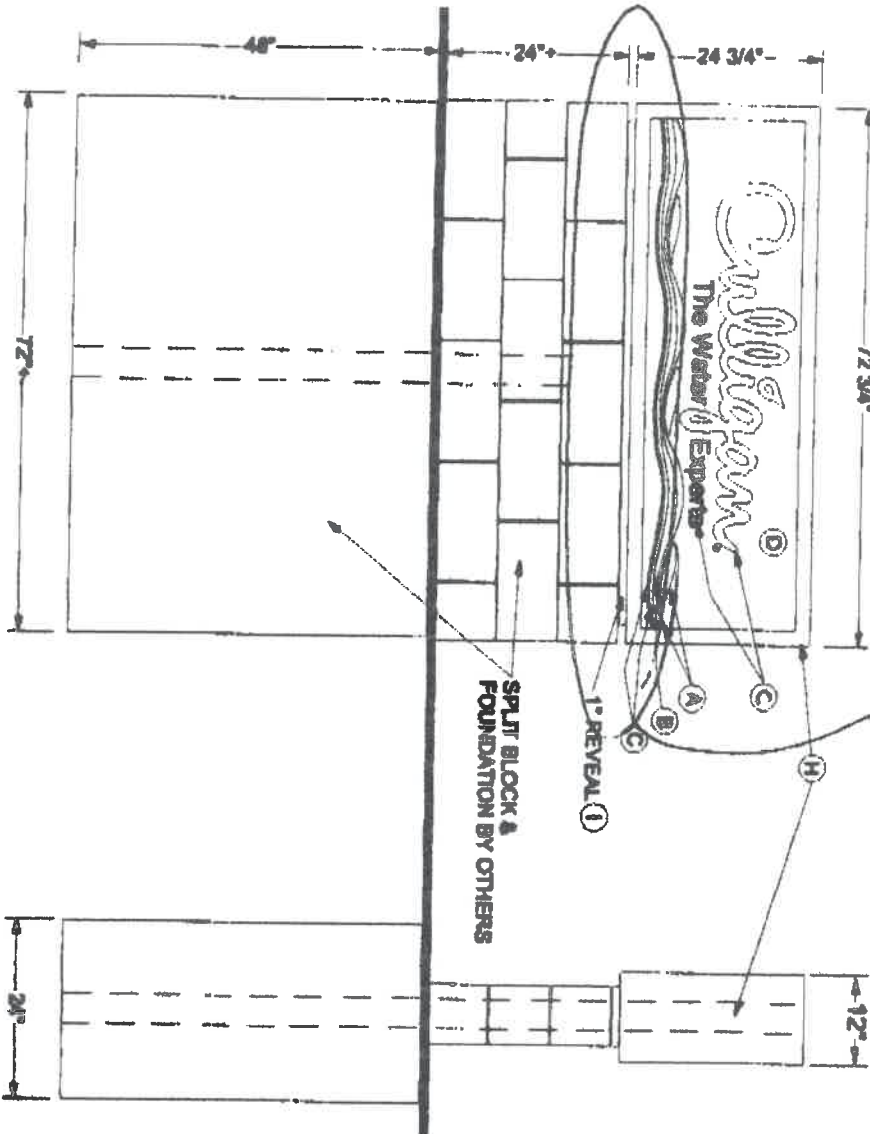

RAISE UP
 SINK ADD A
 4" COPY
 LINE
 RAISE SINK AND
 ADDRESS TO
 END OF SINK
 "SSO"

8914

CABINET

GRV. 1 SF B/D/F NON. IL B/L RADIUS CORNER
 24 3/4" H. 72 3/4" W. 12" D. FAL. B/ST. RET.
 BLEED FACE ROUTED FACE KNOBS 120 SWL.
 PHOTO CAB. BEC. LOC. WALL MT.
 CONCEALED MT. MATCH PLATE SLEVE SADDLE
 SIGND. POLE 3.5" O.D. ROUND SQUARE
 BASE 72" L. 24" W. 48" D. DIRECT FOUR
 DRILLED FOUNDATION DIA. _____ DEPTH _____
 CONDUIT STUB _____ FORM UP _____

FACE

GRV. 2 B/NEW REPLACEMENT • TRIM 24" H. 72" W.
 BLEND OTHER 18 1/8" 37 1/8" BREAKAWAY 2"
 B/PLAT STD. PAN SPECIAL PAN RANGE
 B/SKOOIN BRGD. PLANK BRGD. EMBOSSED
 CHARL. COPY _____ LINES OF _____ D/PEZ
 WAGNER
 OTHER _____

COLORS

FACE COLORS _____ STRUCTURE COLORS _____


A RED TYPHOONE BLUE VANT. H PAIS SEE BLUE (BATH)
 B BUCKINGHAM GREEN VANT. I WHITE GAITRO
 C BUCKINGHAM BLUE VANT. J _____
 D WHITE K _____
 E L _____
 F M _____
 G N _____

HARMON
 DRIVING SINCE 1897

AS BUILT / ORDER CALLIGAN / NAPOLEON, OH.
 S. BRADY 00132200

DATE 1/2" x 1-0" RE CALLIGAN

THE DESIGN & CONSTRUCTION IS SUBJECT TO OUR APPROVAL. 5 & 6 TO APPROVE OUR FINISHED DELIVERABLES WITH ACCEPTED & APPROVED BY PROVIDER. © COPYRIGHT 1998

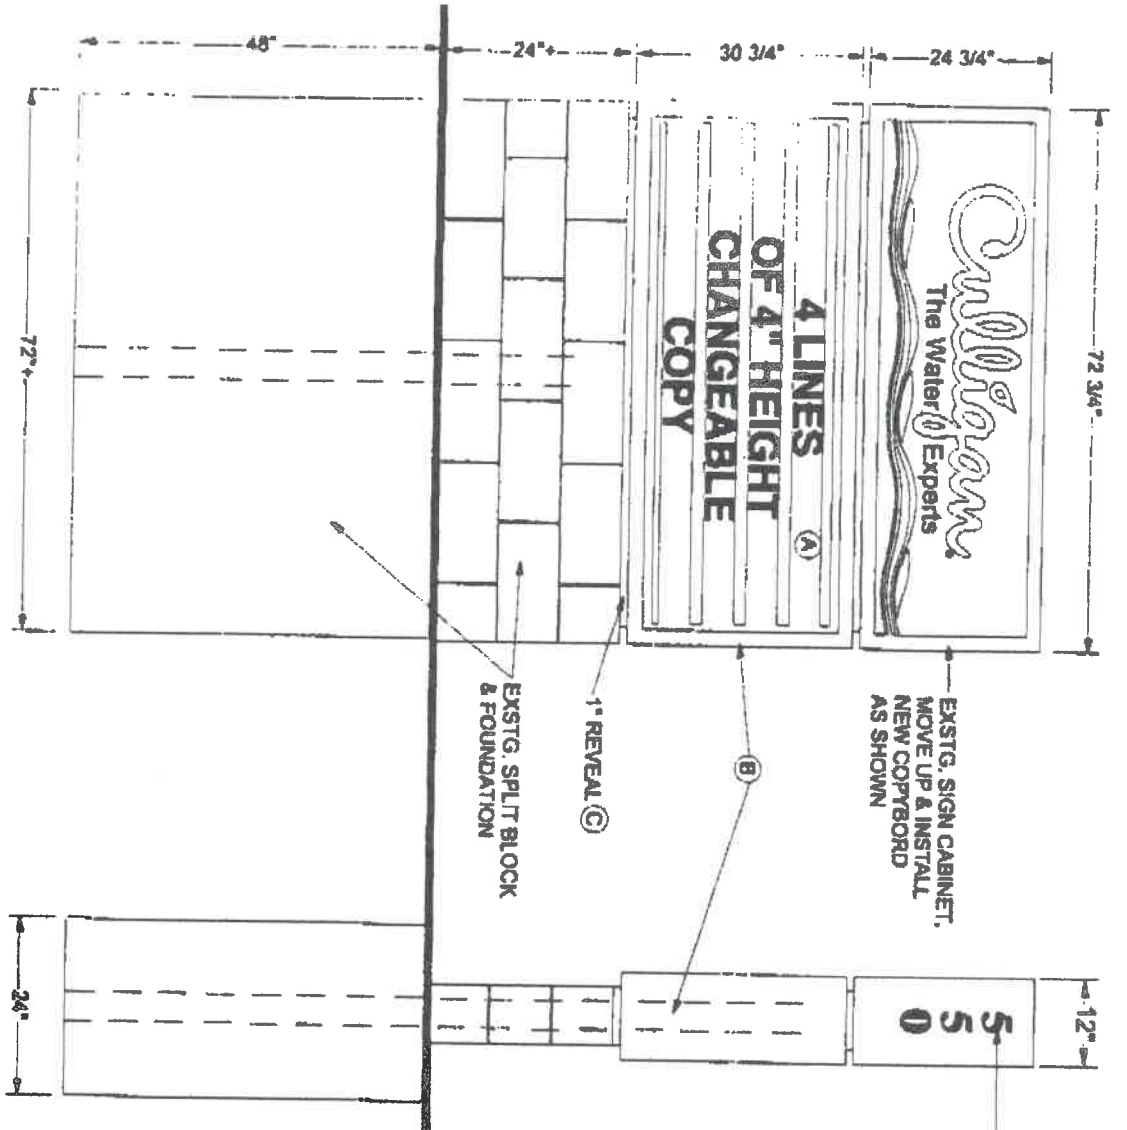

EXSTG. SIGN CABINET.
MOVE UP & INSTALL
NEW COPYBOARD
AS SHOWN

1" REVEAL (A)
EXSTG. SPLIT BLOCK
& FOUNDATION

50

QTY. - 1

ADDITION OF ADDRESS ON CABINET AS SHOWN
H.P. WHITE VINYL
APPLY TO ROAD SIDE OF CABINET

COPYBOARD ADDITION TO EXSTG. SIGNAGE

CABINET

QTY. 1 S/F/EXID/F NON. ILL. DRILL. RADIUS CORNER
 30 3/4" H. 72 3/4" W. 12" D. F/AL. EXXI. I/RET. 2"
 BLEED FACE ROUTERED FACE VOLTIS. 120 I/UL
 PHOTO CELL ELEC. LOC. WALL MT.
 CONCEALED MT. MATCH PLATE SLEEVE SADDLE
 RIGID. POLE 3.5 "O.D. ROUND SQUARE
 BASE _____ W. _____ D. DIRECT POUR
 DRILLED FOUNDATION DIA. _____ DEPTH _____
 CONDUIT STUB _____ FORM UP

FACE

QTY. 2 B/NEW REPLACEMENT • TRIM 30" H. 72" W.
 B/EXAN OTHER 81/8" 31/6" B/RETAINER 2"
 B/PLAT STD. PAN SPECIAL PAN FLANGE
 B/SMOORH BKGD. PLANK BKGD. EMBOSSED _____
 CHGIL. COPY 4 LINES OF 4 • ZIPPER WAGNER OTHER _____

- A WHITE
- B PMS 282 BLUE SATIN
- C WHITE SATIN

HARMON SIGN
QUALITY SIGNS SINCE 1937

JOB #	DESCRIPTION #	SIZE	MT.
28 INT./LICENSING		1/2" = 1'-0"	CU
CULLIGAN / NAPOLEON, OH.	1, KONSTELMAN / 1-23-84		
BY/DESIGNER S. BRADY	EST. # 8974	DATE/REV. 7-14-98	REVISED BY/MT.

1/8" (3/32") & OVERLAPPING & GUARANTEED 45-60 DAY WARRANTY & 5-10 YEAR/1000 HRS. WARRANTY ON FOUNDATION. © COPYRIGHT 1998