

APPLICATION FOR PERMIT TO TAP SEWER

Owner O. W. E. SCREW
ADDRESS 655 INDEPENDENCE DR.
CONTRACTOR CORNERSTONE CONSTRUCTION
ADDRESS _____ TEL. _____

NO. _____
BLDG. PERMIT _____
PERMIT FEE \$ 110.00
STREET BOND _____
DATE PAID _____

For office use only

LOCATION OF CONNECTION

Street and No. 655 INDEPENDENCE DR Sanitary Storm _____
Lot No. _____ Subdivision _____ Size of Tap _____
Size and Type of Sewer _____ ALL WORK MUST BE INSPECTED
Street to be opened-Yes _____ No Opening bond fee set by Engineer \$ _____
Street opening agreement approval date VIA

I certify that the sewer will be used only as indicated and no other drainage will be connected.

Date 12-18-86 Signature Martin Helberg
Owner-Builder-Agent

DO NOT WRITE BELOW THIS LINE

INSPECTION RECORD

Date Inspected 12-24-86 Size and Type of Sewer 6" SCH 35 P.V.C.
Location 655 INDEPENDENCE Depth SEE DWG. Type of Test NONE
Inspected and Approved by: SONNY HELBERG 12-24-86
Inspector Date

Additional information _____

Send copy to: _____

SKETCH OF INSTALLATION -ON BACK

VIII. ZONING PLAN EXAMINERS NOTES

DISTRICT SEWER TAP 655 INDEPENDENCE DR

USE D.W.I.E, SCREW


FRONT YARD

SIDE YARD SIDE YARD

REAR YARD


NOTES

IX. SITE OR PLOT PLAN - For Applicant Use

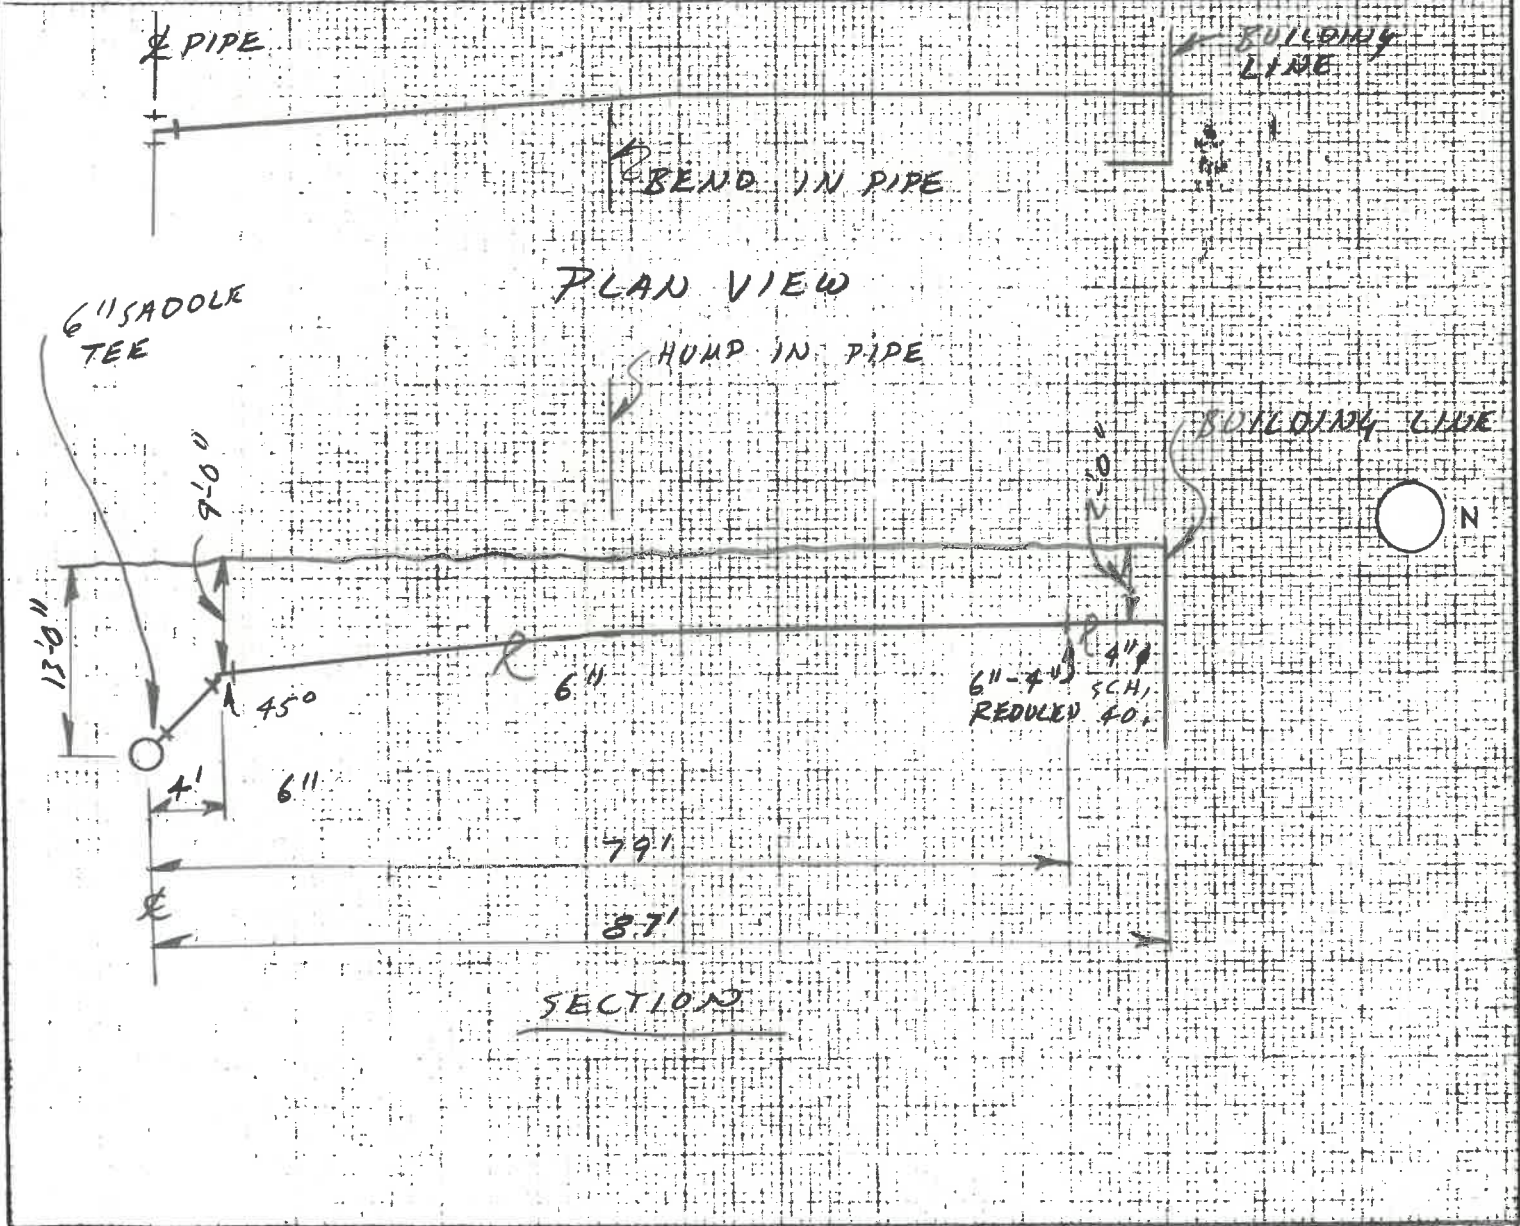

D.W.E. Sewer

89' to downstream Man hole

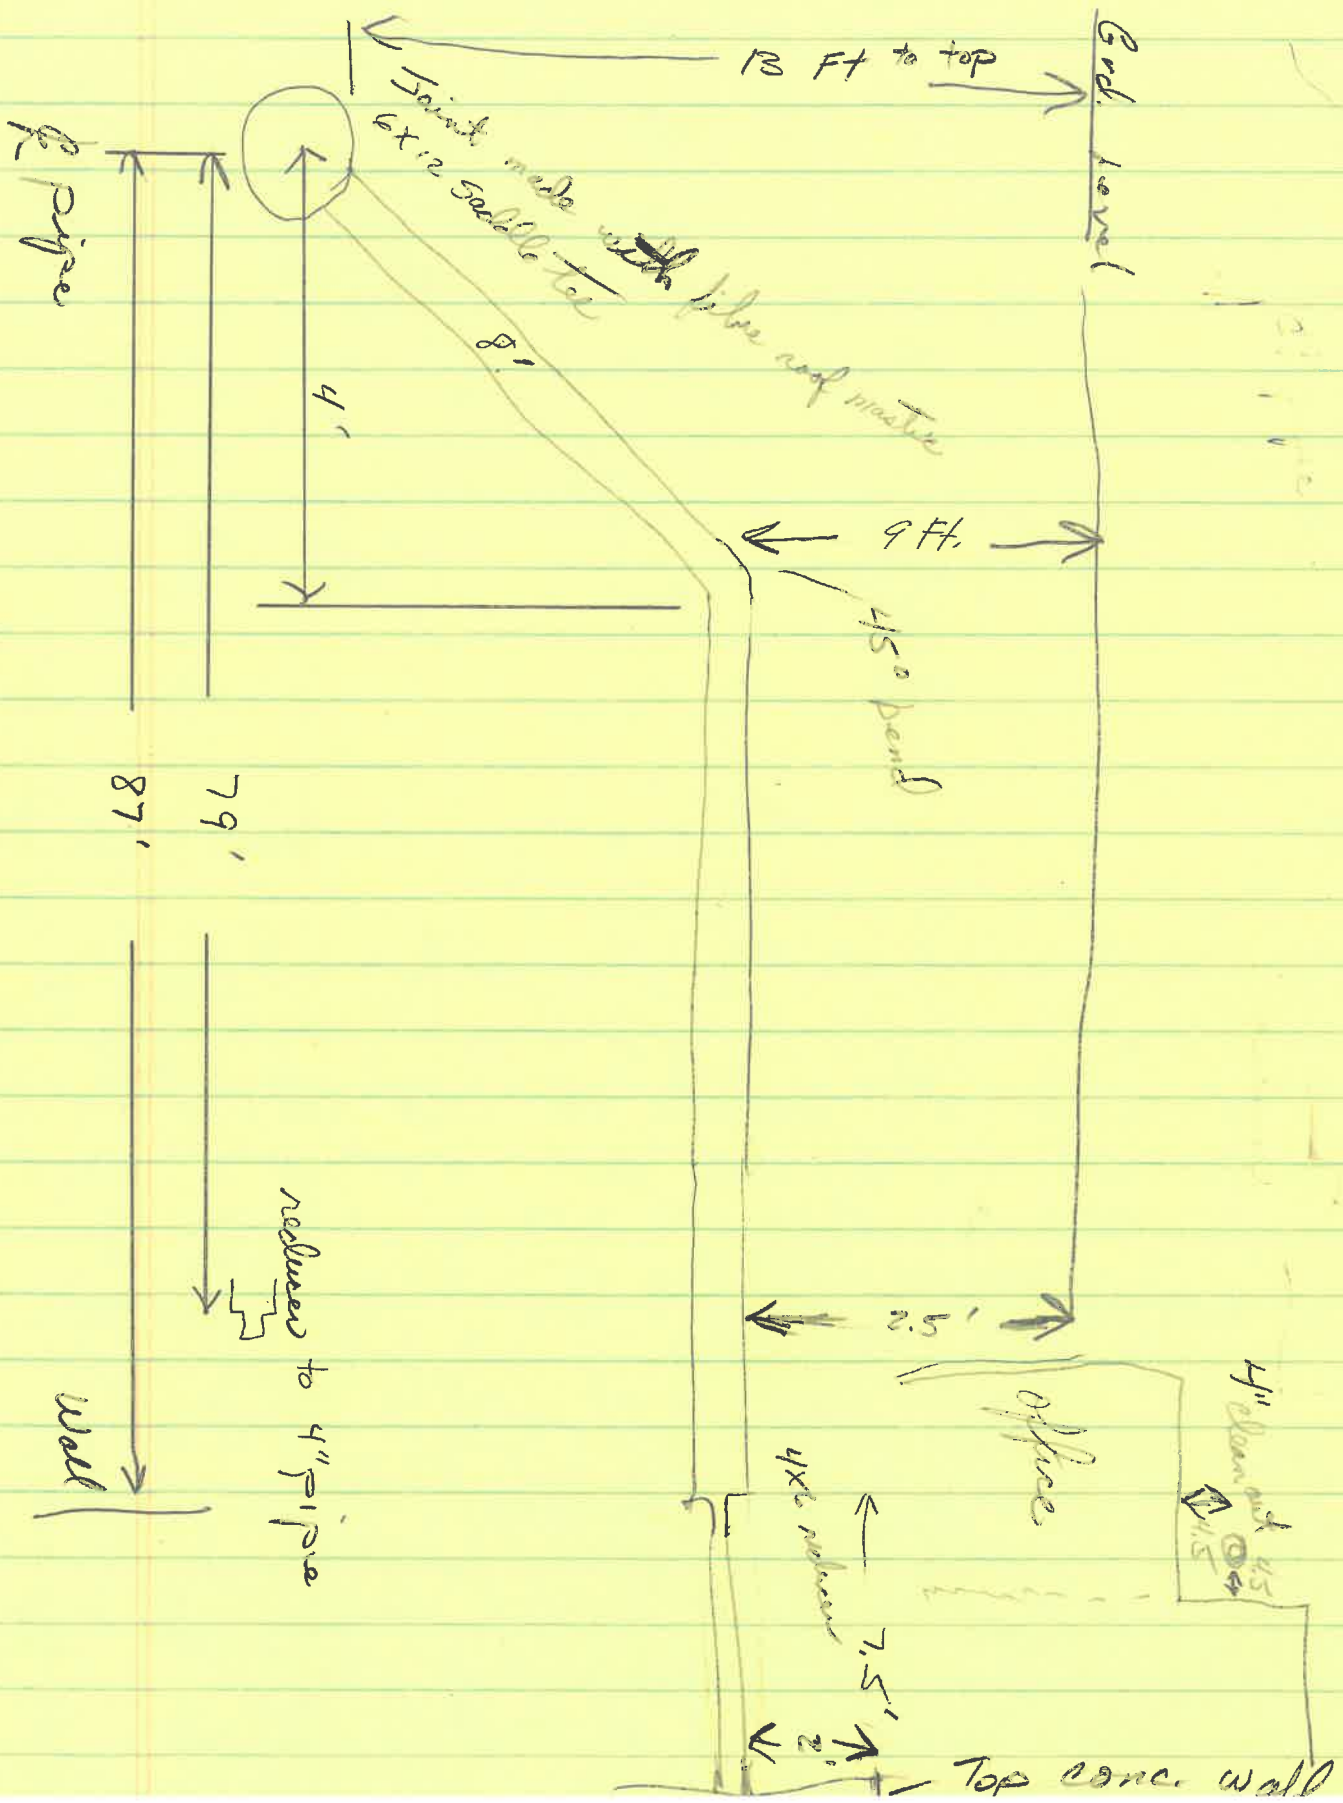

Sign Location

161 ft from west End of Property

132 ft from East End of Property


55 ft from 3 ft from Independence Rd

25 ft from front of Building

Sign is mounted on 1 1/2" steel poles

4 ft of pole is in ground held by concrete

- A. 3 1/2" 6"
- B. 6"
- C. 9 1/2"
- D. 14 1/2" 2 1/2"

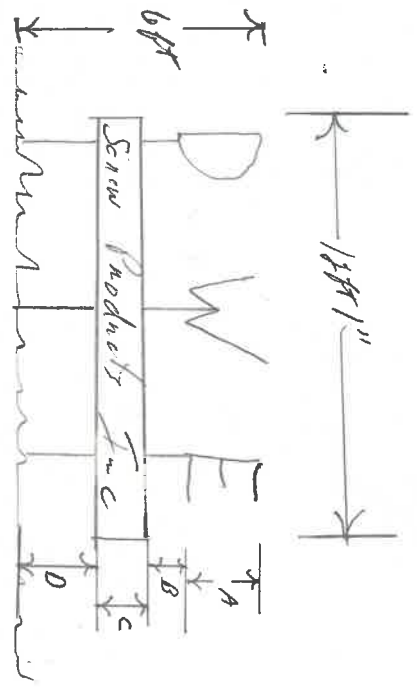

PERMISSIBLE VARIATION ON LINEAR DIMENSIONS IS PLUS OR MINUS .010 AND ON ANGULAR DIMENSIONS PLUS OR MINUS 0.30° UNLESS OTHERWISE SPECIFIED.

CORRECTIONS	DATE	MATERIAL	CHECK	SCALE	DATE
		Sign	HTL	Nours	8-19-83

B.T. COPY

APPLICATION FOR PERMIT TO TAP SEWER

Owner C. W. E. SCREW
ADDRESS 685 INDEPENDENCE DR.
CONTRACTOR CORNISTONK CONSTRUCTION
ADDRESS _____ TEL. _____

NO. _____
BLDG. PERMIT _____
PERMIT FEE \$ 110.00
STREET BOND _____
DATE PAID _____
For office use only

LOCATION OF CONNECTION

Street and No. 685 INDEPENDENCE DR Sanitary Storm _____
Lot No. _____ Subdivision _____ Size of Tap _____
Size and Type of Sewer _____ ALL WORK MUST BE INSPECTED
Street to be opened-Yes _____ No Opening bond fee set by Engineer \$ _____
Street opening agreement approval date N.A.

I certify that the sewer will be used only as indicated and no other drainage will be connected.

Date 12-18-86 Signature Martin Helmke
Owner-Builder-Agent

DO NOT WRITE BELOW THIS LINE

INSPECTION RECORD

Date Inspected _____ Size and Type of Sewer _____
Location _____ Depth _____ Type of Test _____
Inspected and Approved by: _____
Inspector _____ Date _____

Additional information _____

Send copy to: _____

SKETCH OF INSTALLATION -ON BACK

PAID
DEC 22 1986
CITY OF NAPOLEON

TAPPING PERMIT

655
~~655~~ INDEPENDENCE DR

Office of
Water Works
Napoleon, Ohio

No. _____

Date 12-18-86

Received of D.V.E. SCREW PRODUCTS

THREE HUNDRED Dollars $\frac{100}{100}$

Charge for tapping permit to supply water services to Lot No. _____

Addition INDUSTRIAL PARK

Street No. 655 INDEPENDENCE DR.

Tap Size 1 Inch Cost 300.⁰⁰

Plumber ZACHRICH CONSTRUCTION

Clerk-Treasurer

Date completed _____

Water Distribution Department

PAID
DEC 22 1986
CITY OF NAPOLEON