

We have provision to believe that this area is increased in steel, which would not allow a tap as proposed. Also we do not have easement in part of the area proposed to be crossed over.

what type of pipe is this? If PVC is used there must be a 12 gauge stranded copper wire along the entire length of line.

This tank is not in this location.

connecting to object. Sec. 1019.5. Location of fire department. Connection shall be located front of street front of building.


MR. Right of Way. Please provide road crossing detail. We will require a permit to install as shown.

SITE PLAN
SCALE 1"=40'

WATER FLOW INFO
DATE & TIME: 1993
PROJECT: SHAMBAUGH & SON, INC. INDUSTRIAL DR.
CITY OF MAPLETON
STATION: 82 PSI
RESIDUAL: 50 PSI
FLOWING: 1319 GPM



SUBMITTED FOR APPROVAL
By: R. R. Barnes
DATE: 4/19/93
R. R. Barnes
Shambaugh & Son Fire Protection

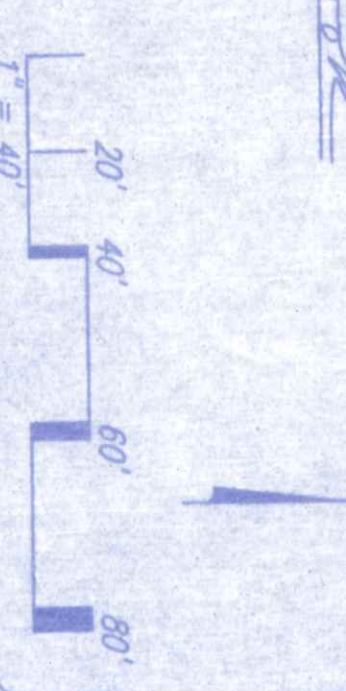

CAD DWG 231292-1
SHEET NO. 231292
PP-1 OF 2

PROJECT NAME:
VISION MOLDED PLASTICS, INC.
1675 INDUSTRIAL DRIVE
NAPOLEON, OHIO

DESIGN: <input type="checkbox"/> HYDRAULIC CALC <input type="checkbox"/> PIPE SCHEDULE	WATER DEMAND: _____ PSI AT BASE OF RISER
DENSITY: _____	HAZARD CLASS: _____
AREA: _____	OCCUPANCY: _____
HOSE LO: _____	RACK ALLOW: _____
SPRINKLERS	
MAKE / MODEL: _____	MAKE / MODEL: _____
SIZE / TYPE: _____	SIZE / TYPE: _____
K-FACTOR / TEMP: _____	K-FACTOR / TEMP: _____
QTY. THIS SHIT: _____	QTY. THIS SHIT: _____
BUILDING CONSTRUCTION	
TYPE: <input type="checkbox"/> NON-COMBUSTIBLE <input type="checkbox"/> COMBUSTIBLE	BUILDING HEIGHT: _____
TOTAL SQUARE FEET: _____	

PRIDE
S&S
FIRE PROTECTION DIVISION
SHAMBAUGH & SON, INC.
CONTRACTORS - ENGINEERS
7814 OPPORTUNITY DRIVE, FORT WAYNE, INDIANA 46825
PHONE (219) 482-7777 FAX 482-7781