

SEWER TAPPING PERMIT

Issued by

The City of Napoleon Engineering Dept.

255 West Riverview Ave. Napoleon, Ohio 43545 Pn. 592-4010

Entry No. \_\_\_\_\_

Permit No. 00418 Issued 1-12-93 Build. Permit No. \_\_\_\_\_

Job Location 303 Jahns Rd

Lot \_\_\_\_\_

Issued By BND sub div. or legal disc.

Owner John Sickmiller Pn. \_\_\_\_\_

Address 303 Jahns Rd.

Agent Cordis P+H. Pn. 758-3855

Address RTA Napoleon Ohio

Permit Fee \$ 2500

Street Bond \$ \_\_\_\_\_

Date Paid 1-20-93

for office use only

WORK INFORMATION

*Repair + C/O placement*

Sanitary Sewer Tap \_\_\_\_\_ Size of Tap \_\_\_\_\_ Size and Type of Sewer \_\_\_\_\_ Street to be Opened \_\_\_\_\_  
yes no

Storm Sewer Tap \_\_\_\_\_ Size of Tap \_\_\_\_\_ Size and Type of Sewer \_\_\_\_\_ Street to be Opened \_\_\_\_\_  
yes no

Street opening Agreement Approval Date \_\_\_\_\_ Opening Bond Fee (Set by Engineer) \_\_\_\_\_  
yes no

READ AND SIGN BELOW; The undersigned hereby agrees complete the work described above and to make use of said sewers only as allowed by and in strict accordance with all applicable provisions of The Napoleon Engineering Dept. Rules and Regulations, The Napoleon Standard Specification for Water Main, Sanitary Sewer and Storm Sewer Construction and other Pertinent Sections of the Napoleon Code of Ordinances.

Date 1-20-93 Signature of Applicant *[Signature]*

Permit not valid without signature

INSPECTION RECORD

to be completed by the Field Inspector

Date Inspection is made \_\_\_\_\_ Size and Type of Sewer \_\_\_\_\_

Location \_\_\_\_\_ Depth \_\_\_\_\_ Type of Test \_\_\_\_\_ Additional Information \_\_\_\_\_

Date 1-12-93 Inspected By Malcolm Helberg

signature of inspector


Sketch Of Installation on Back or Attached

PAID

JAN 20 1993

CITY OF NAPOLEON

1-12-93

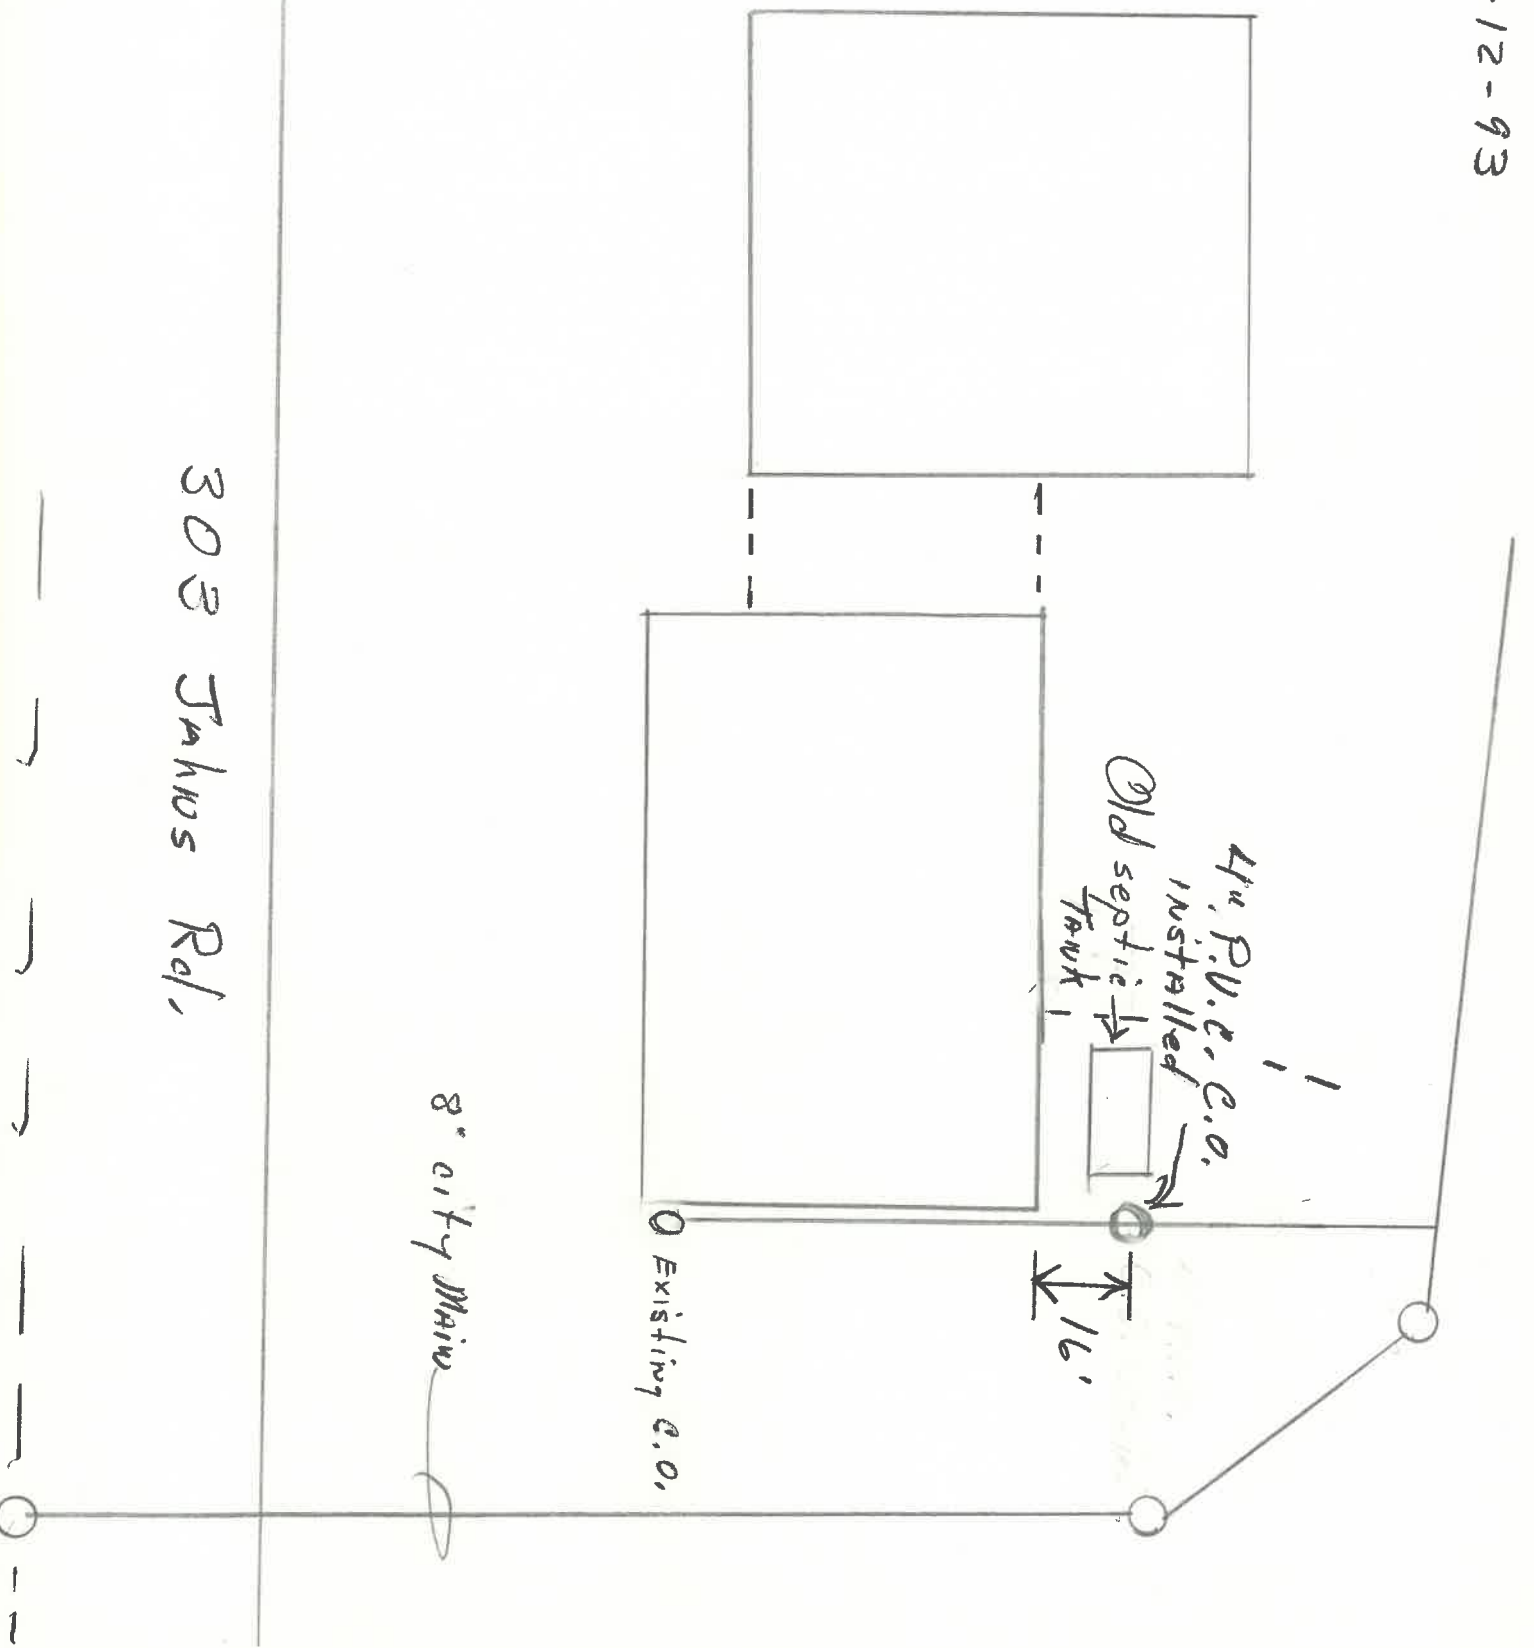

303 Johns Rd.

8" city main

Existing C.O.

16'