

P E R M I T

CITY OF NAPOLEON
255 W. RIVERVIEW AVE
NAPOLEON, OHIO 43545

DIVISION OF BUILDING & ZONING
PH (419) 592-4010
FAX (419) 599-8393

PERMIT NO: 99145 DATE ISSUED: 05-14-99 ISSUED BY: BND
JOB LOCATION: 240 KOLBE ST EST. COST: 7500.00

LOT #: SUBDIVISION NAME:
OWNER: MILLER, MIKE AGENT: SELF
ADDRESS: 240 KOLBE ST ADDRESS:
CSZ: NAPOLEON, OH 43545 CSZ:
PHONE: 419-592-6059 PHONE:

USE TYPE - RESIDENTIAL: OTHER:

ZONING INFORMATION

DIST: LOT DIM: AREA: FYRD: SYRD: RYRD:
MAX HT: # PKG SPACES: # LOADING SP: MAX LOT COV:

BOARD OF ZONING APPEALS:

WORK TYPE - NEW: REPLMNT: ADD'N: ALTER: REMODEL:

WORK INFORMATION

SIZE - LGTH: WIDTH: STORIES: LIVING AREA SF:
GARAGE AREA SF: HEIGHT: BLDG VOL DEMO PERMIT:

WORK DESCRIPTION
GARAGE DETACHED 24X26

FEE DESCRIPTION	PAID DATE	FEE AMOUNT DUE
BUILDING PERMIT		53.00
ELECTRICAL PERMIT		6.00

TOTAL FEES DUE ~~59.00~~

5/14/99

DATE

Michael E. Miller

APPLICANT SIGNATURE



11111c 11111c - 111 in + 5 applicable L-1173

592-4010

NAPOLEON BUILDING DEPARTMENT (SAMPLE DRAWING)

Note - I have filled in minimums.

VENTS YES
 ROOFING 3 TAB. FIBERGLASS
 UNDERLAYMENT FELT
 SHEATHING 7/16 O.S.B.

also need estimated cost

7500⁰⁰

TRUSSES TRUSSES
2x4 RAFTERS
 @ 24" O.C.
2x PER ATTACHMENT
 @ CEILING JOISTS
 @ O.C.

N/A CEILING INSULATION

N/A FINISH CEILING

2x4 TYPE OF FRAMING LUMBER

SIZE OF HEROERS

4" CONCRETE SLAB W/ 6x6 # WIRE MESH

YES VAPOR BARRIER


#57 STONE FILL

11x RIGID INSULATION HORIZ.
11x RIGID INSULATION VERT.

N/A


240 Kolbe St


SECTION
SCALE: 1/2" = 1'-0"

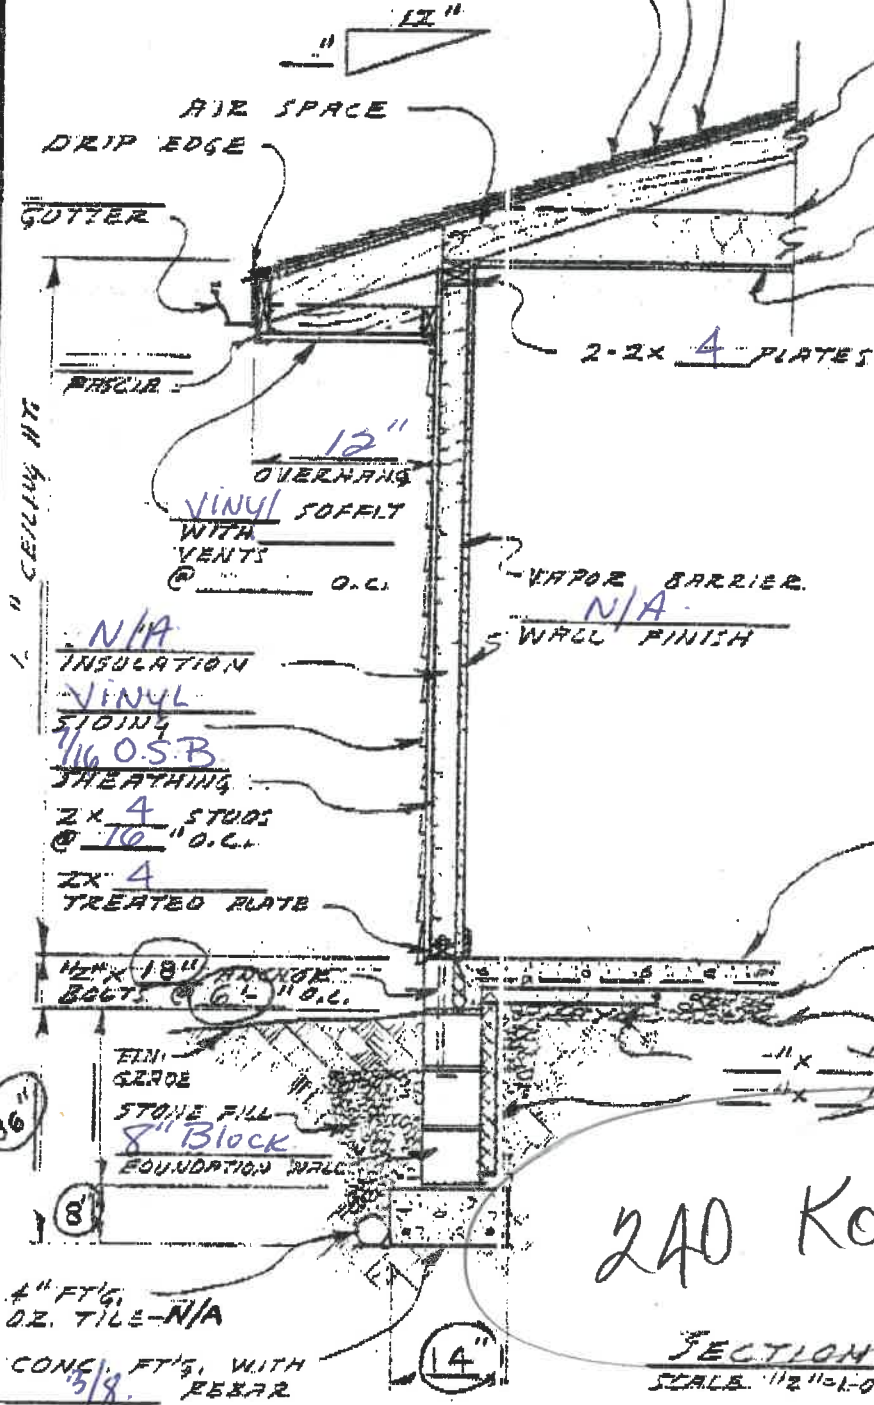

DATE	WALL SECTION @ SLAB ON GRADE	DWG. NO OF
------	------------------------------	------------

4-11-89 E

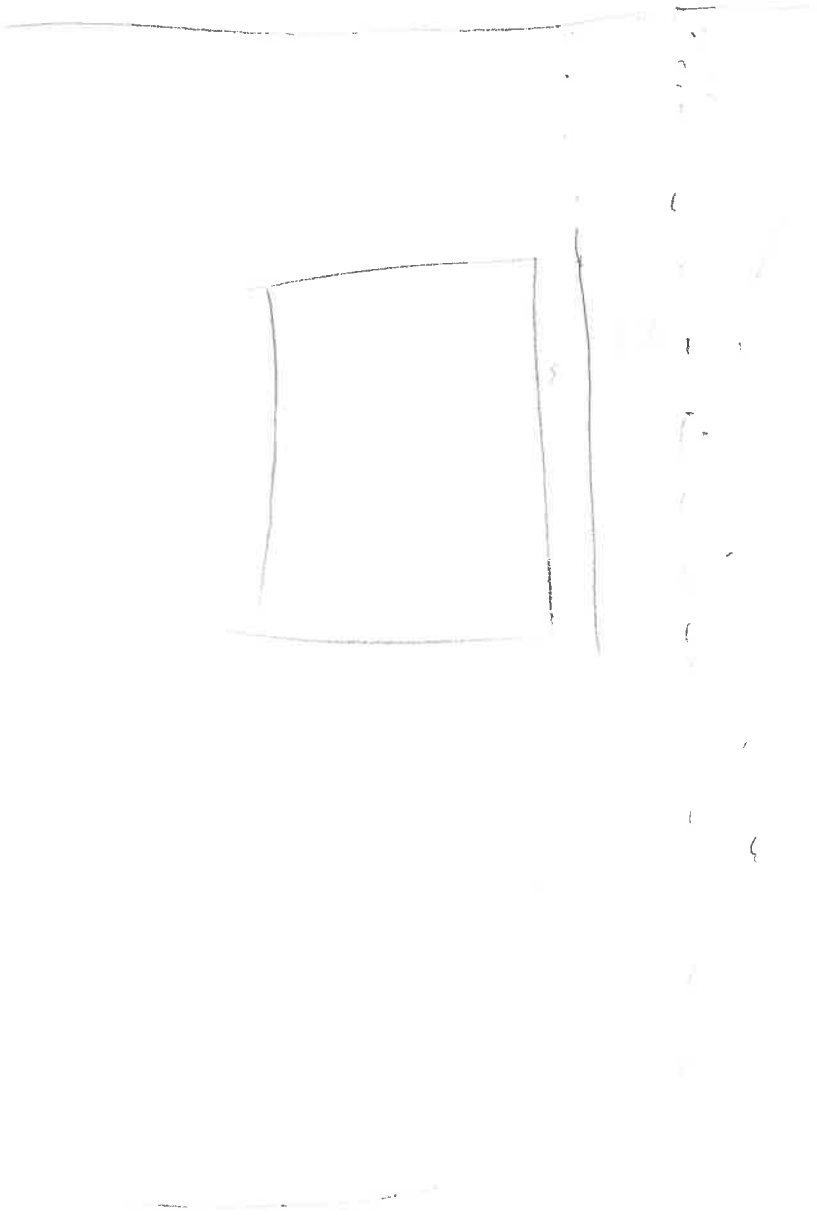

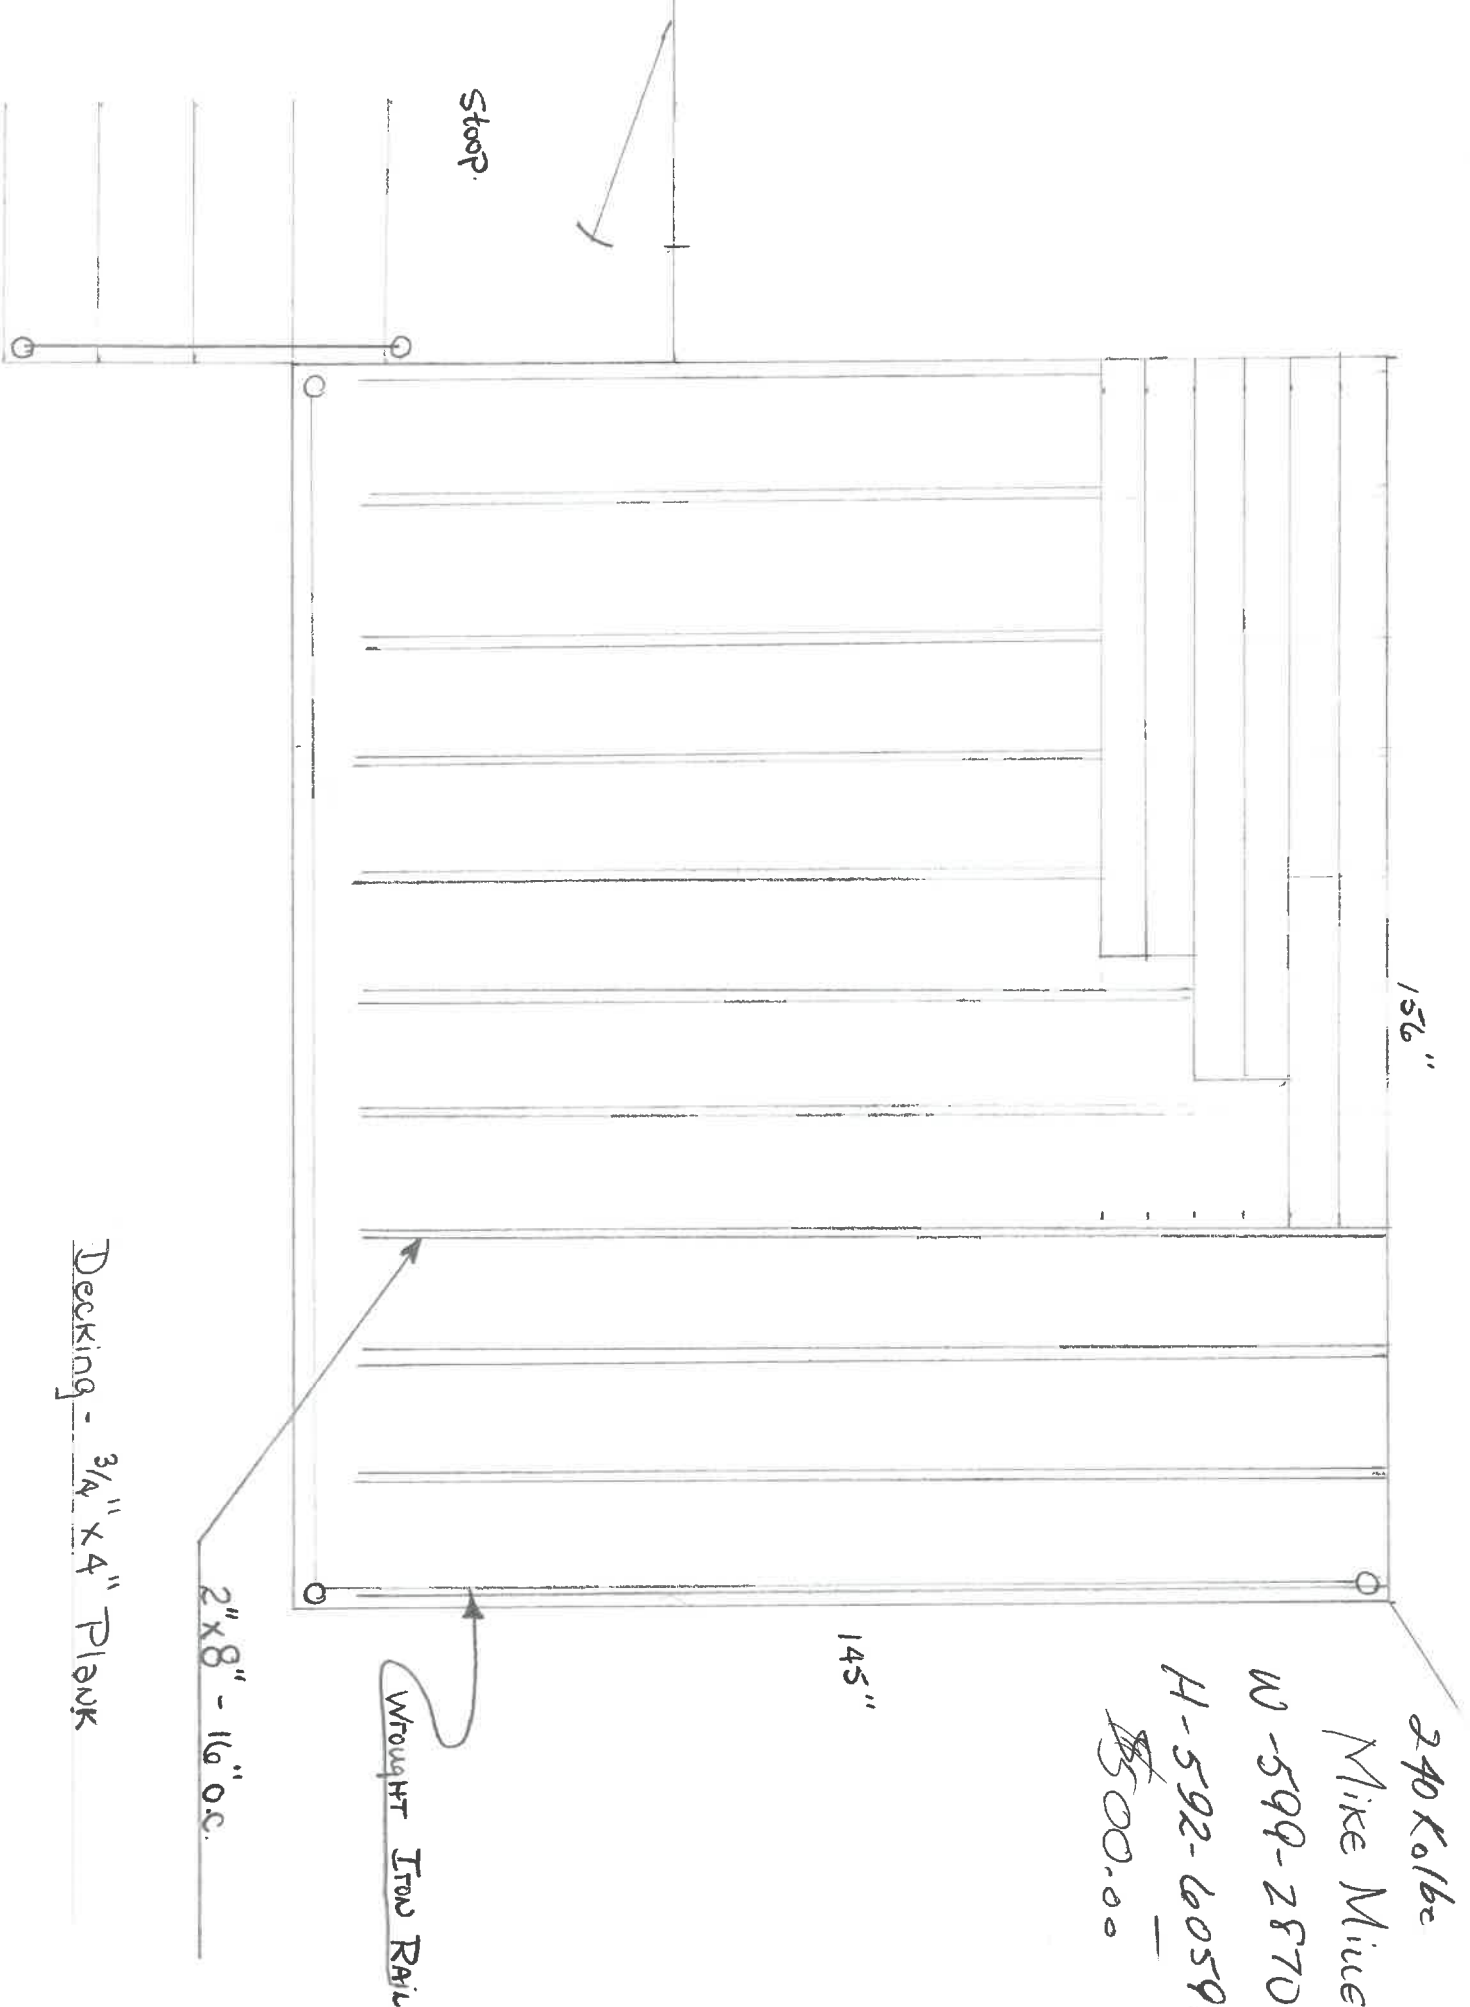

156"

145"

240 Kolbe
 Mike Miner
 W-599-2870
 H-592-6059
~~500.00~~


Stoop

Decking - 3/4" x 4" Plank

2" x 8" - 16' o.c.

Wrought Iron Rail


6" Concrete Block.

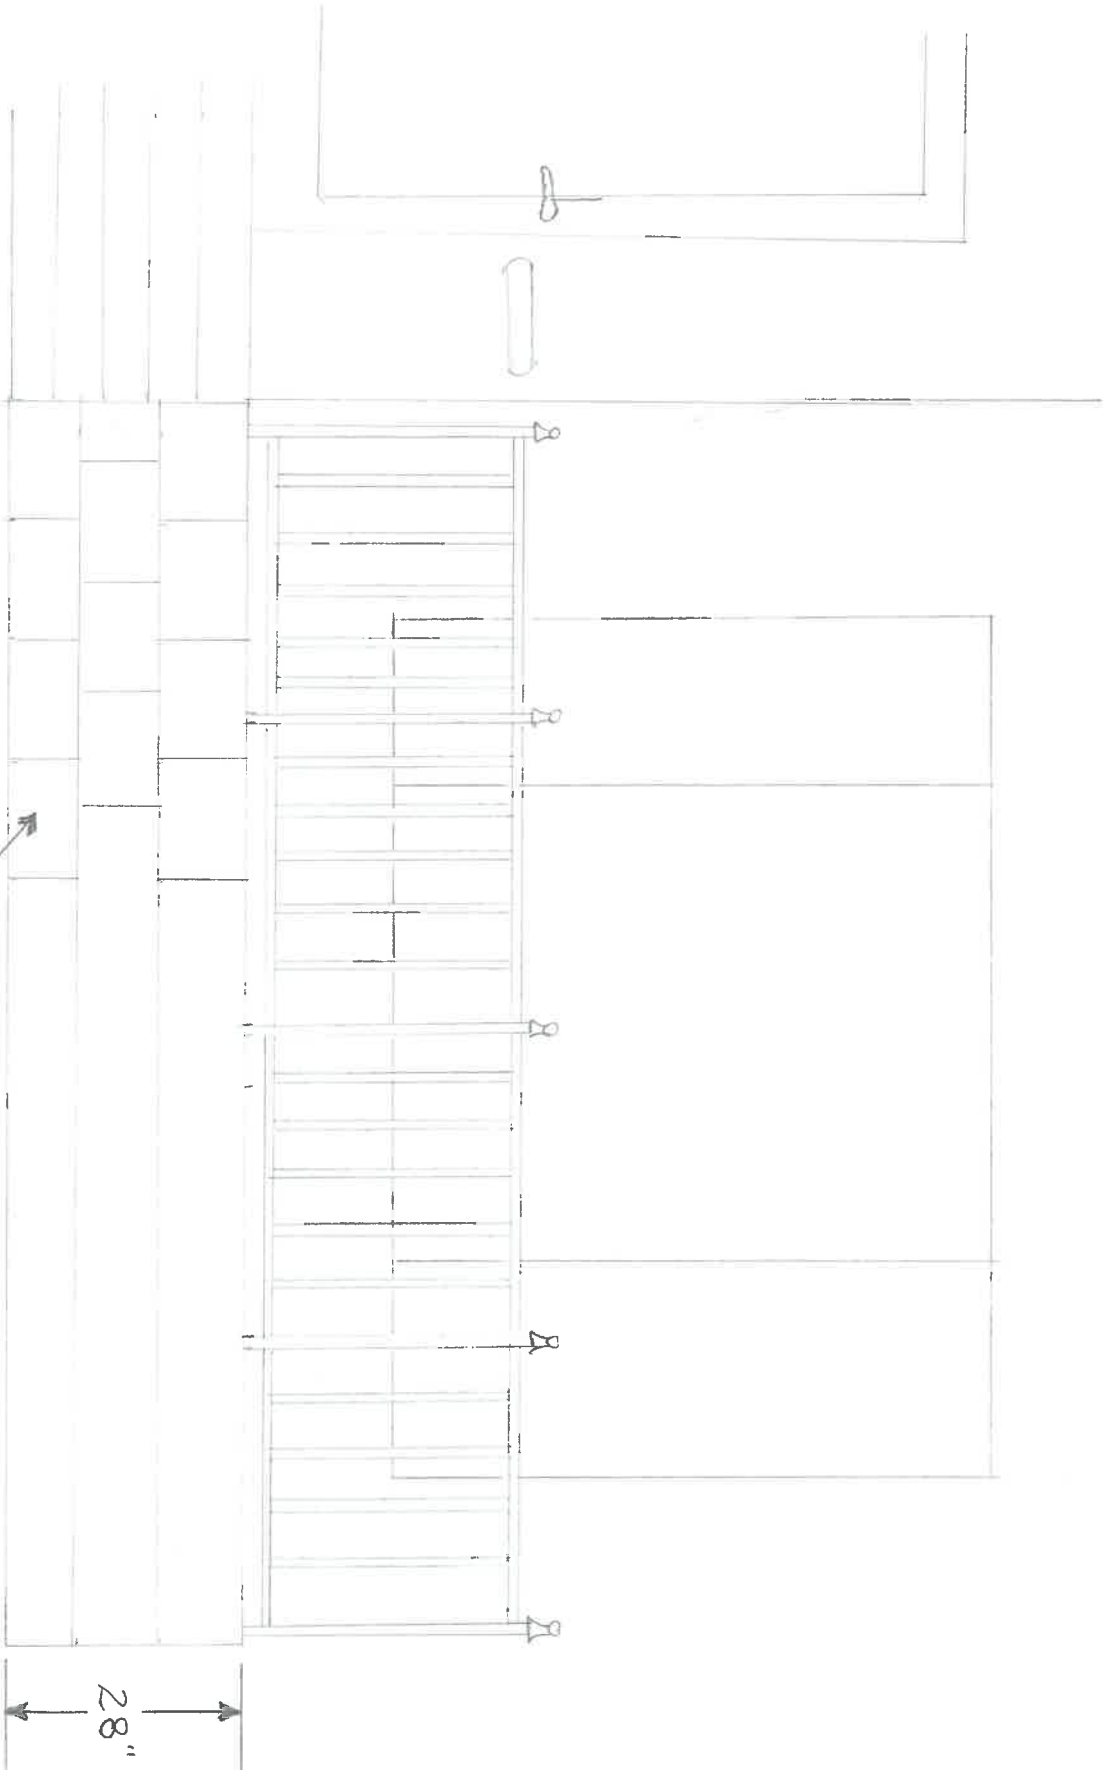

MIKE MILLER - Fill in as applicable 2-9195

NAPOLEON BUILDING DEPARTMENT (SAMPLE DRAWING)


Note - I have filled in minimums.

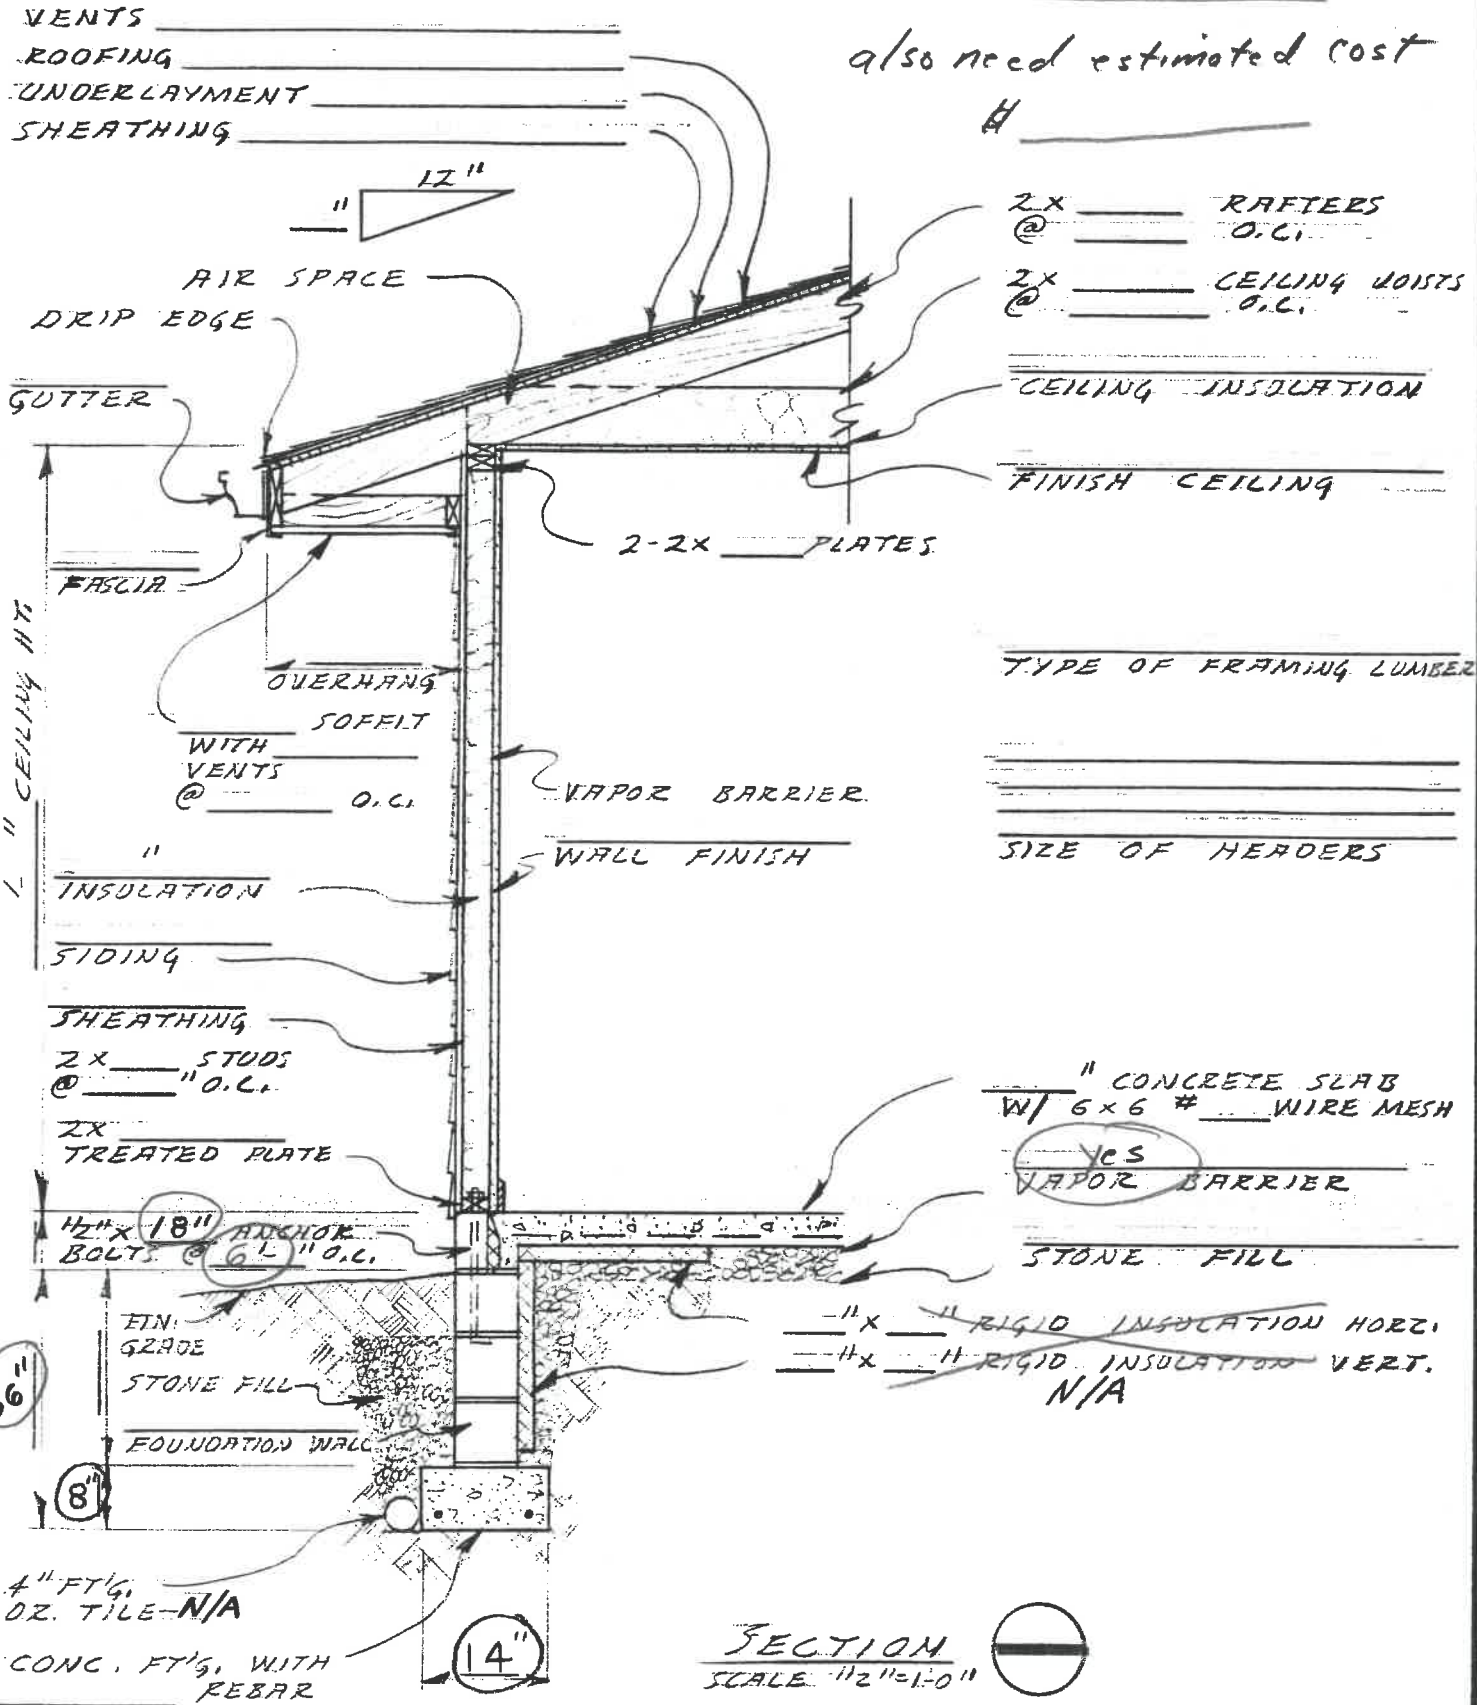

SECTION
 SCALE: 1/2" = 1'-0"

DATE	WALL SECTION @ SLAB ON GRADE	DWG. NO. OF
------	------------------------------	-------------

4-11-89 - 54

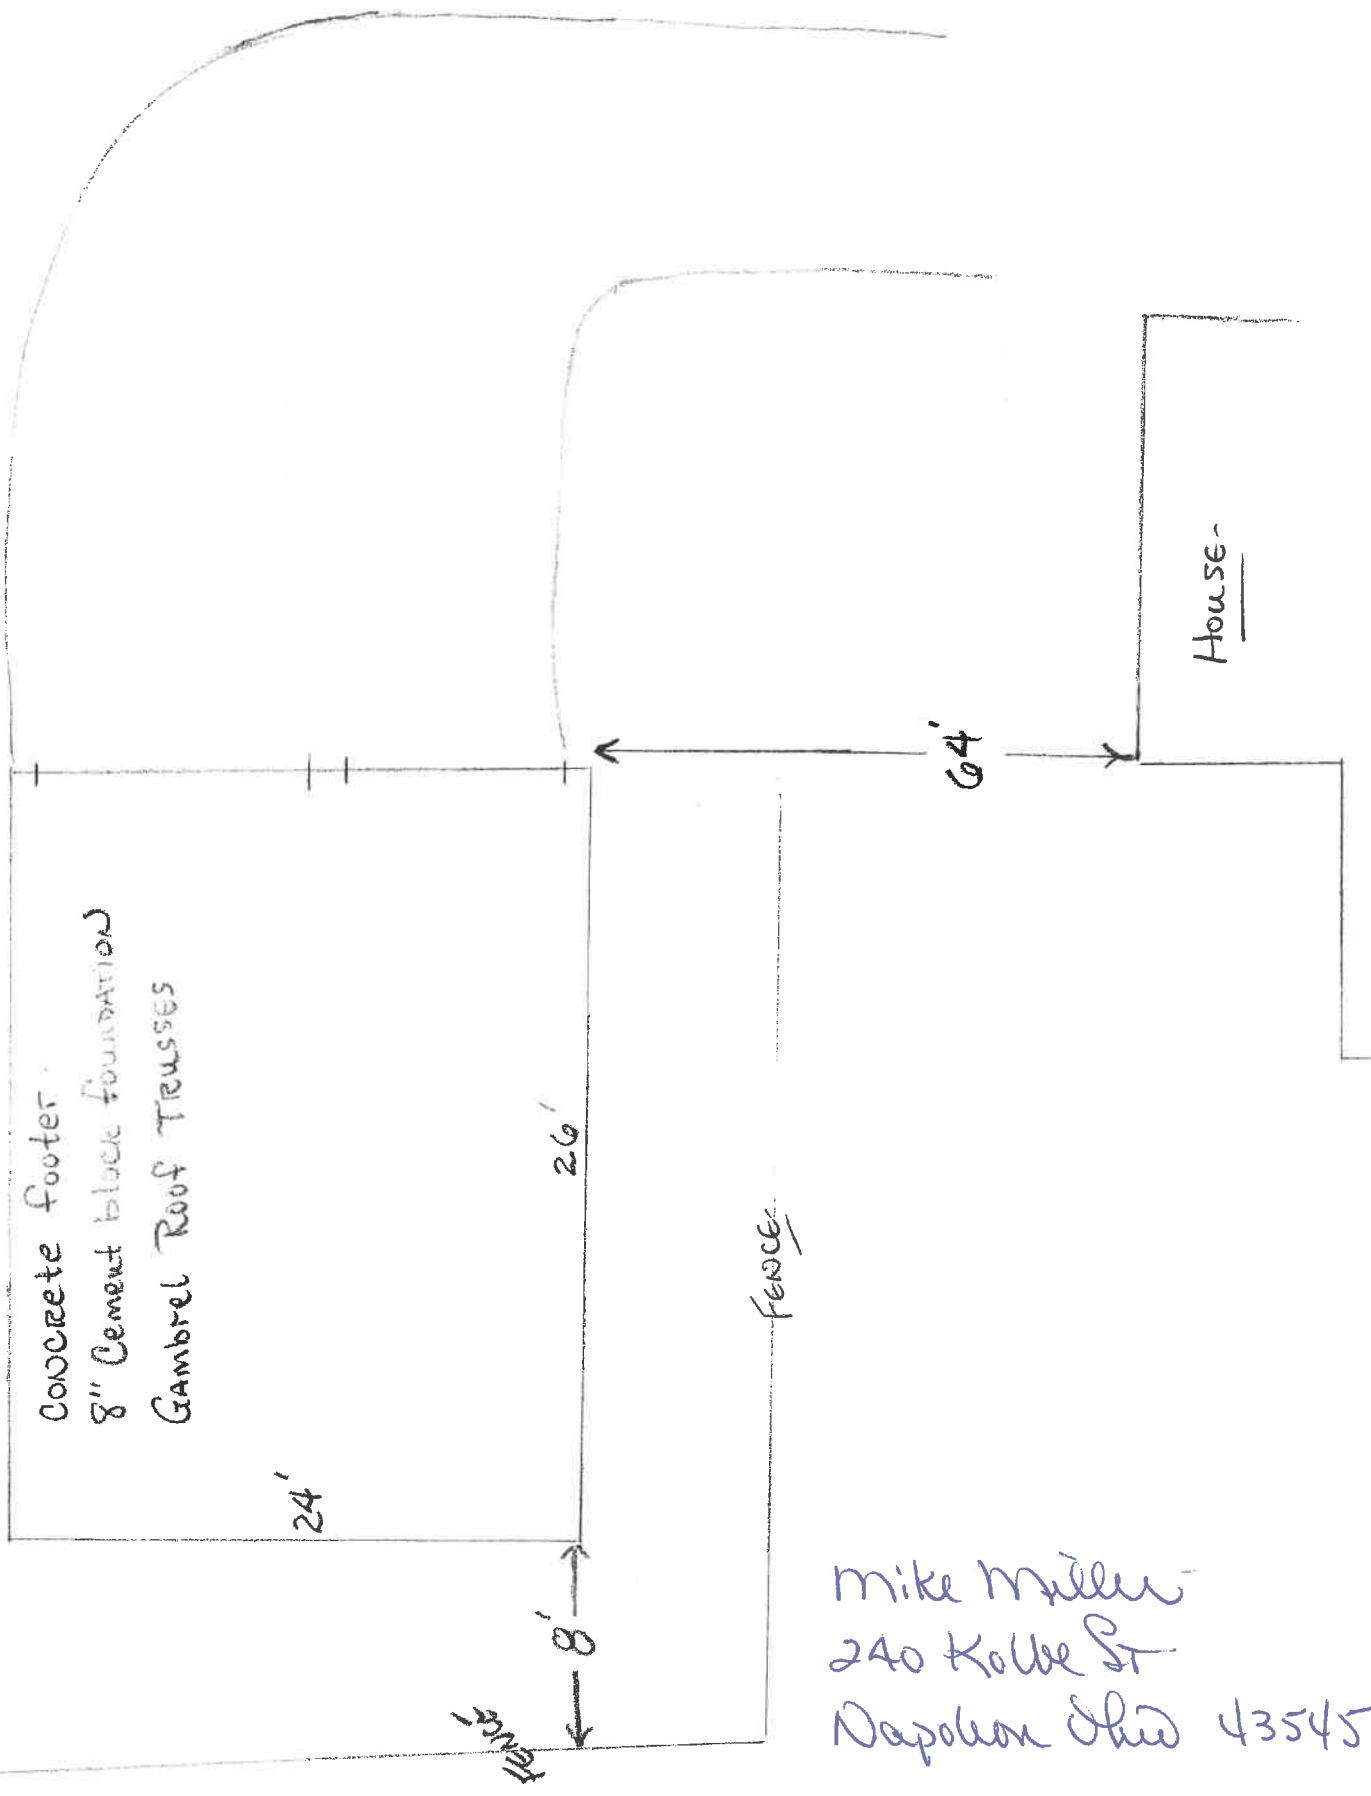

Concrete footer
 8" Cement block foundation
 Gambrel Roof Trusses

House-

Mike Miller
 240 Kolbe St
 Napoleon Ohio 43545

H- 592-6059
 W- 592-4816
 Fax-

Building Permit
 w/ Electrical 2 circuits

Cost-


Truss spec.

Stark Truss Co., Inc.

List Prices
Effective July 10, 1995

Gambrel Attic Frame Spaced 2' oc

Loading	(p.s.f.)
Top Chord Live (snow)	30
Top Chord Dead (plywood & shingles)	10
Bot Chord Live (room area only)	40
Bot Chord Dead (drywall & insulation)	10
Total Load	90

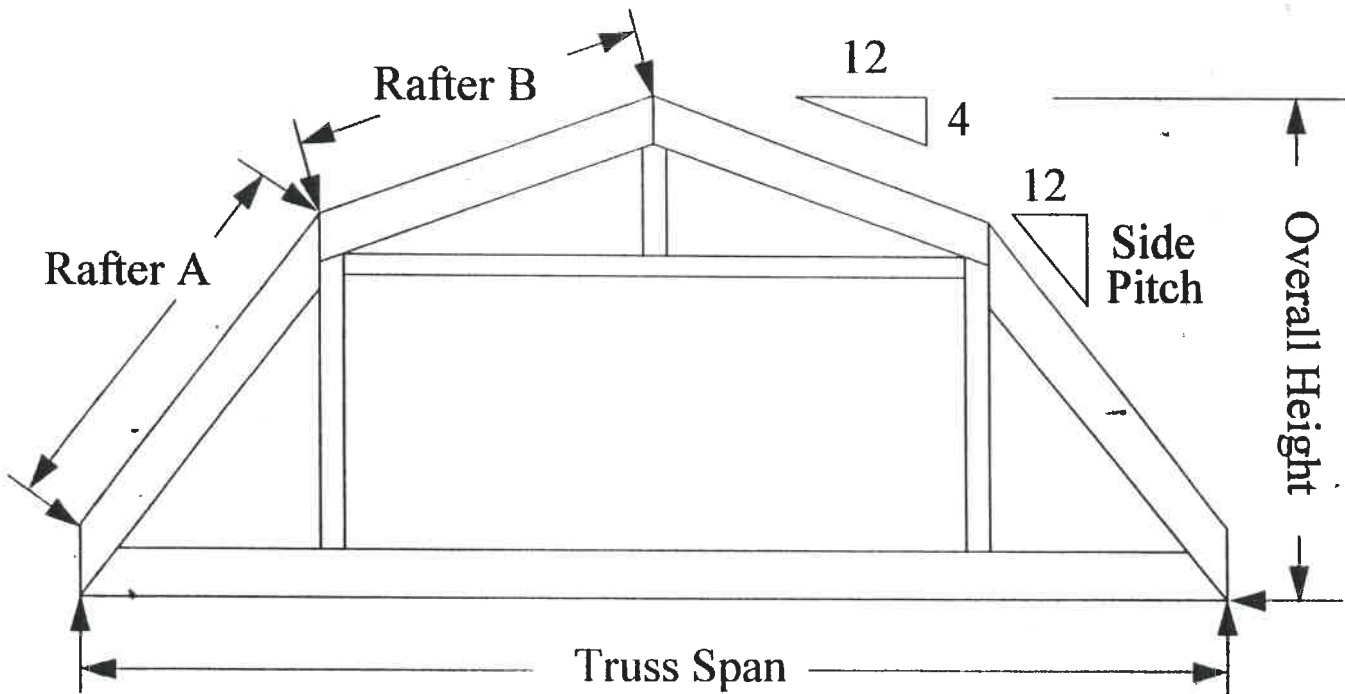

Span	Lumb.	Room Sz.	Rafter A	Rafter B	Side Pitch	Overall Ht.	List Price
16'	4/6	6 X 9	7' 0-5/16"	5' 0-5/8"	23.38	8' 6-1/8"	\$ 83.20
18'	4/8	6-6 X 10	7' 10-3/16"	5' 6-15/16"	22.39	9' 3-7/8"	\$102.60
20'	6/8	7 X 11	8' 5"	6' 1-1/4"	20.80	10' 1-15/16"	\$130.40
22'	6/8	7 X 11	9' 0-3/4"	6' 1-1/4"	17.08	10' 1-15/16"	\$136.40
24'	6/8	7 X 12	9' 4-11/16"	6' 7-9/16"	15.68	10' 3-15/16"	\$145.35
26'	6/8	7 X 13	9' 8-3/4"	7' 1-15/16"	14.48	10' 5-15/16"	\$156.75
28'	6/8	7 X 13	10' 5-1/4"	7' 1-15/16"	12.57	10' 6"	\$161.30
30'	6/10	7-6 X 15	10' 10-7/8"	8' 2-9/16"	13.63	11' 5-15/16"	\$199.50
32'	6/10	7-6 X 16	11' 3-1/8"	8' 8-7/8"	12.78	11' 7-15/16"	\$203.25
34'	6/10	7-6 X 16	11' 11-15/16"	8' 8-7/8"	11.36	11' 7-15/16"	\$217.10

Garages

*OSB Sheeting
Walls*

Deluxe Gambrel and Attic Storage



Gambrel Storage Garage



Features Include:

- 2 x 4 construction grade studs 16" O.C.
- Treated bottom sill plates for either slab or foundation application
- Trims
- Steel overhead garage doors
- Pre-hung steel entrance door with lockset
- Two maintenance-free windows with screens
- Pre-built roof trusses with storage room and 12" eave overhang
- 3/4" tongue and groove flooring for storage area
- Roof and soffit vents
- Durable roof sheathing
- Your choice of three shingle colors (white, brown, or black) — *green OK*
- Choose from 5 year EZ-Panel™ or 50 year warranty white vinyl siding
- Pull-down stair system *WALK-up steps.*
- Heavy duty hardware and nails
- Blueprints and instruction guide

Vinyl Siding

