

Sewer Inspection Fee

SEWER TAPPING PERMIT

Issued by

The City of Napoleon Engineering Dept.

255 West Riverview Ave. Napoleon, Ohio 43545 Pn. 592-4010

Entry No. _____

Permit No. ⁰¹²² SA ~~0202~~ Issued 7-12-89 Build. Permit No. _____

Permit Fee \$ 60.⁰⁰

Job Location 930 Lynne St

Street Bond \$ _____

Lot 9 Glenwood Addition
sub div. or legal disc.

Date Paid _____

Issued By _____

Owner Frank Saman Pn. _____

Address 930 Lynne St

Agent EH Glanz Pn. 599-4103

Address #6 Lakeview Dr.

for office use only

WORK INFORMATION

Sanitary Sewer Tap _____ Size of Tap _____ Size and Type of Sewer _____ Street to be Opened _____
yes no

Storm Sewer Tap _____ Size of Tap _____ Size and Type of Sewer _____ Street to be Opened _____
yes no

Street opening Agreement Approval Date _____ Opening Bond Fee (Set by Engineer) _____

Will be working on a San-Sewer Service thought to be plugged with roots
READ AND SIGN BELOW; The undersigned hereby agrees complete the work described above and to make use of said sewers only as allowed by and in strict accordance with all applicable provisions of The Napoleon Engineering Dept. Rules and Regulations, The Napoleon Standard Specification for Water Main, Sanitary Sewer and Storm Sewer Construction and other Pertinent Sections of the Napoleon Code of Ordinances.

Date 6/12/89 Signature of Applicant Jerry Glanz
Permit not valid without signature

INSPECTION RECORD _____ to be completed by the Field Inspector

Date Inspection is made _____ Size and Type of Sewer _____

Location _____ Depth _____ Type of Test _____ Additional Information _____


Date 6-13-89 Inspected By Malcolm Welbesy
signature of inspector

Sketch Of Installation on Back or Attached

PAID


JUN 12 1989

CITY OF NAPOLEON

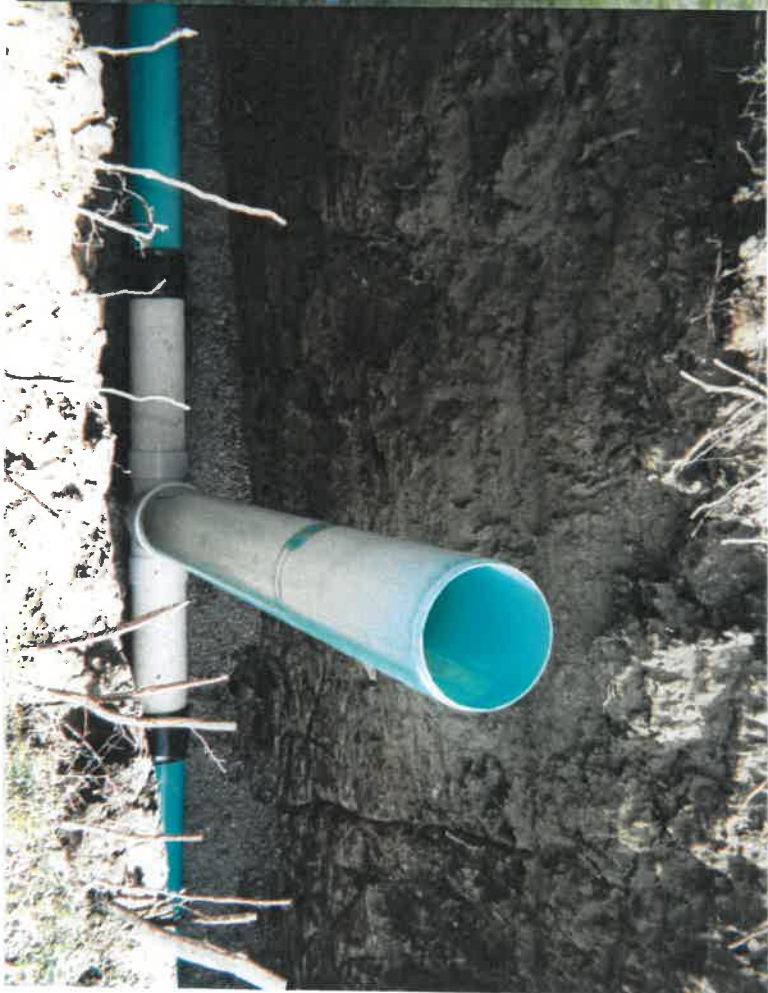

S-10-01

J. GLANZ

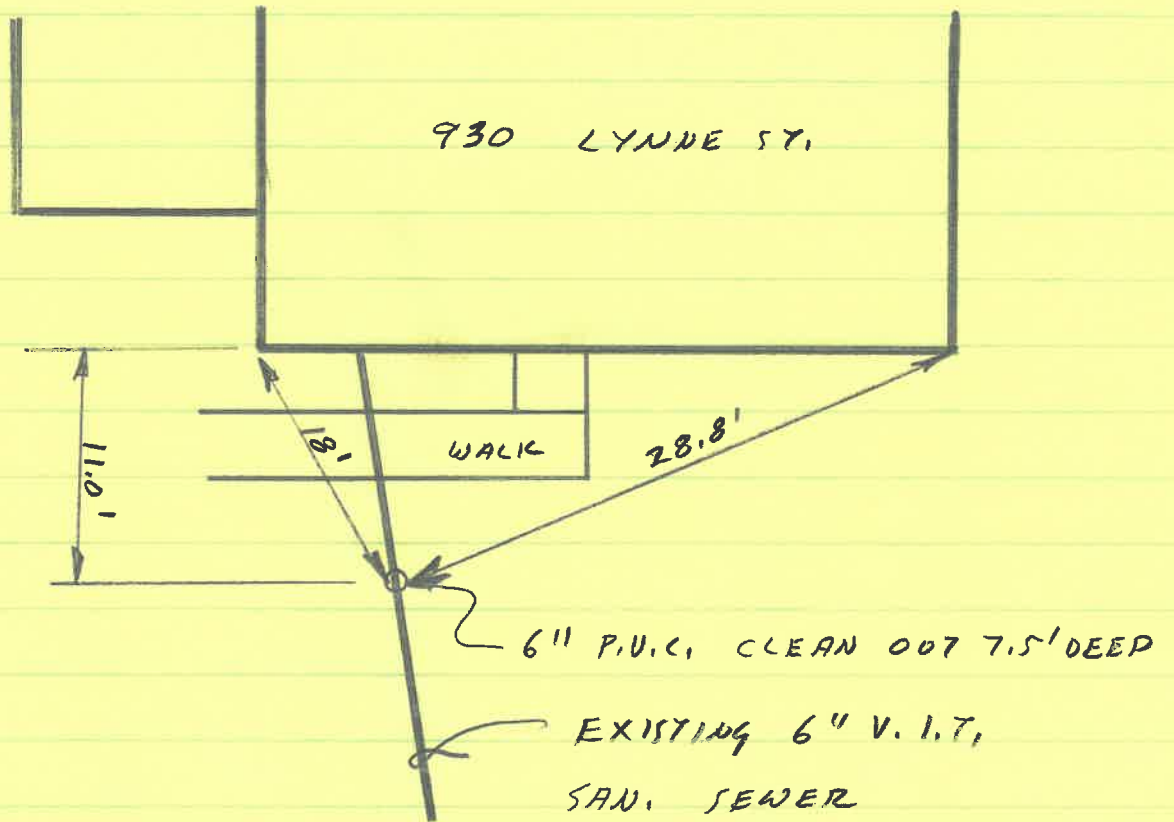

~~5-10-01~~

~~J. GLANZ~~

11/8/11

S. German n

