
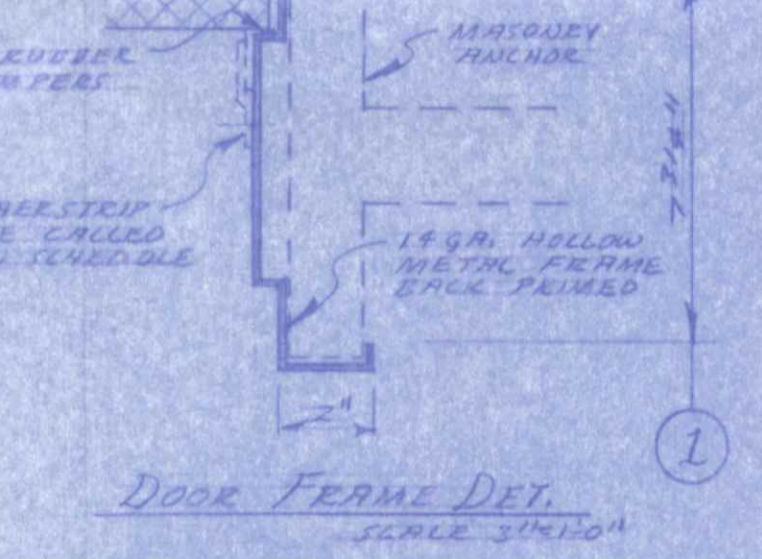





ROOM FINISH SCHEDULE

SPACE DESIGNATION	FLOOR MATERIAL	BASE MATERIAL	WALL MATERIAL	CEILING MATERIAL	FIXTURES
101 WOMEN'S TOILET	EXPO. CONG. W/ SCALER	D-1	PRINTED CONG. SUR.	7"-11" FIR PLYWOOD	8'-0"
102 MEN'S TOILET	EXPO. CONG. W/ SCALER	D-1	PRINTED CONG. SUR.	7"-11" FIR PLYWOOD	8'-0"

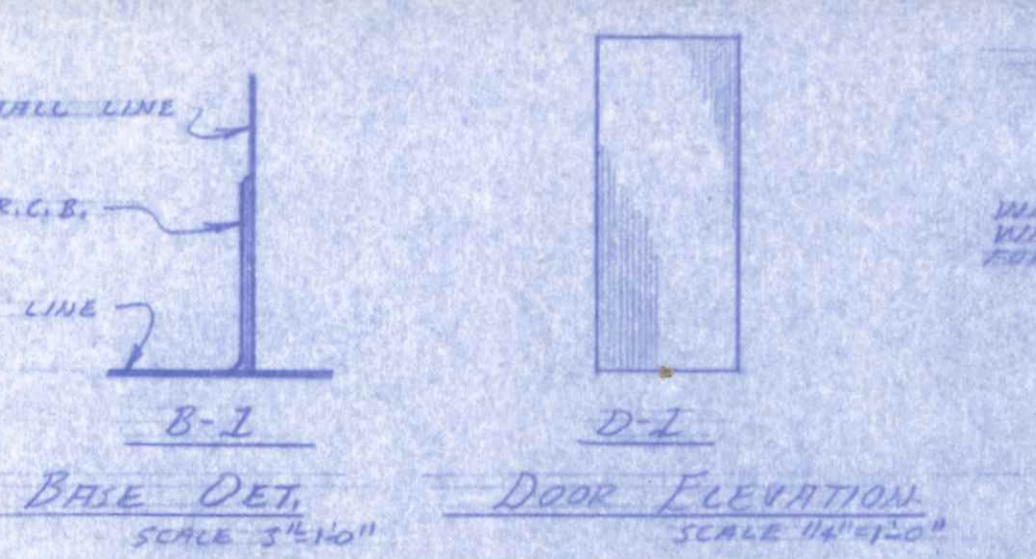

DOOR SCHEDULE

DOOR NO.	OPENING SIZE	TYPE	DOOR MATERIAL	FRAME MATERIAL	DOOR GLASS	HW. SET	FIXTURES
1	5'-0" x 7'-0" x 13'-0"	1	HOLLOW METAL 16 GA.	HOLLOW METAL 16 GA. 4" HEAD	---	---	4" MTRG. RICHARDI PER JAMB SACK PRIME FRAME
2	5'-0" x 7'-0" x 13'-0"	1	HOLLOW METAL 16 GA.	HOLLOW METAL 16 GA. 4" HEAD	---	---	4" MTRG. RICHARDI PER JAMB SACK PRIME FRAME
3	5'-0" x 7'-0" x 13'-0"	1	HOLLOW METAL 16 GA.	HOLLOW METAL 16 GA. 4" HEAD	---	---	4" MTRG. RICHARDI PER JAMB SACK PRIME FRAME

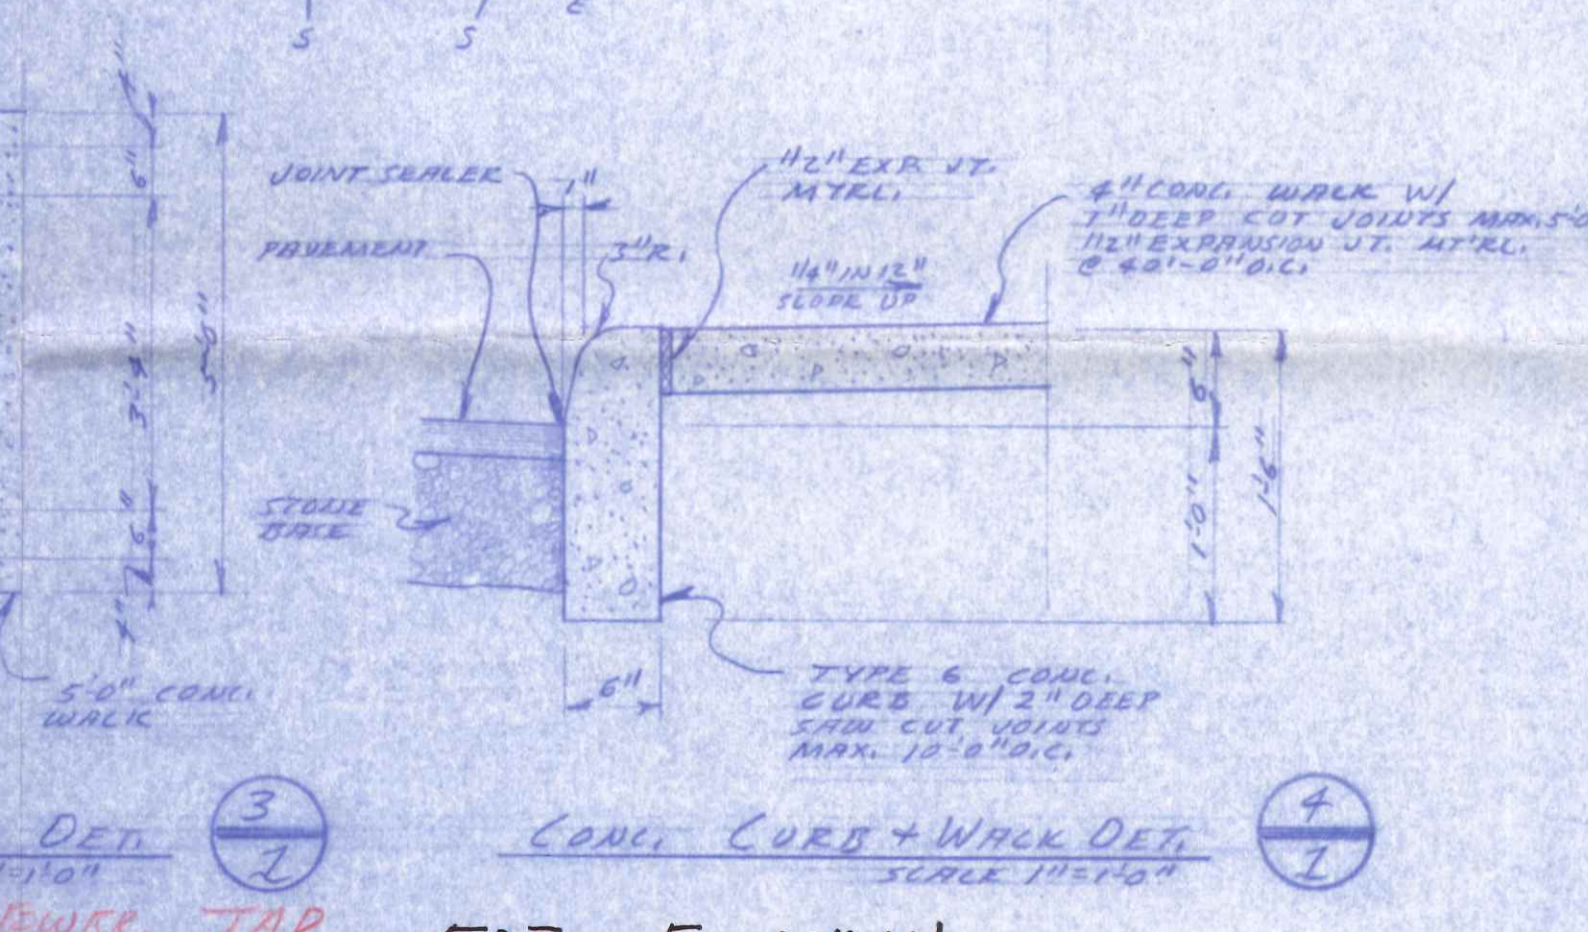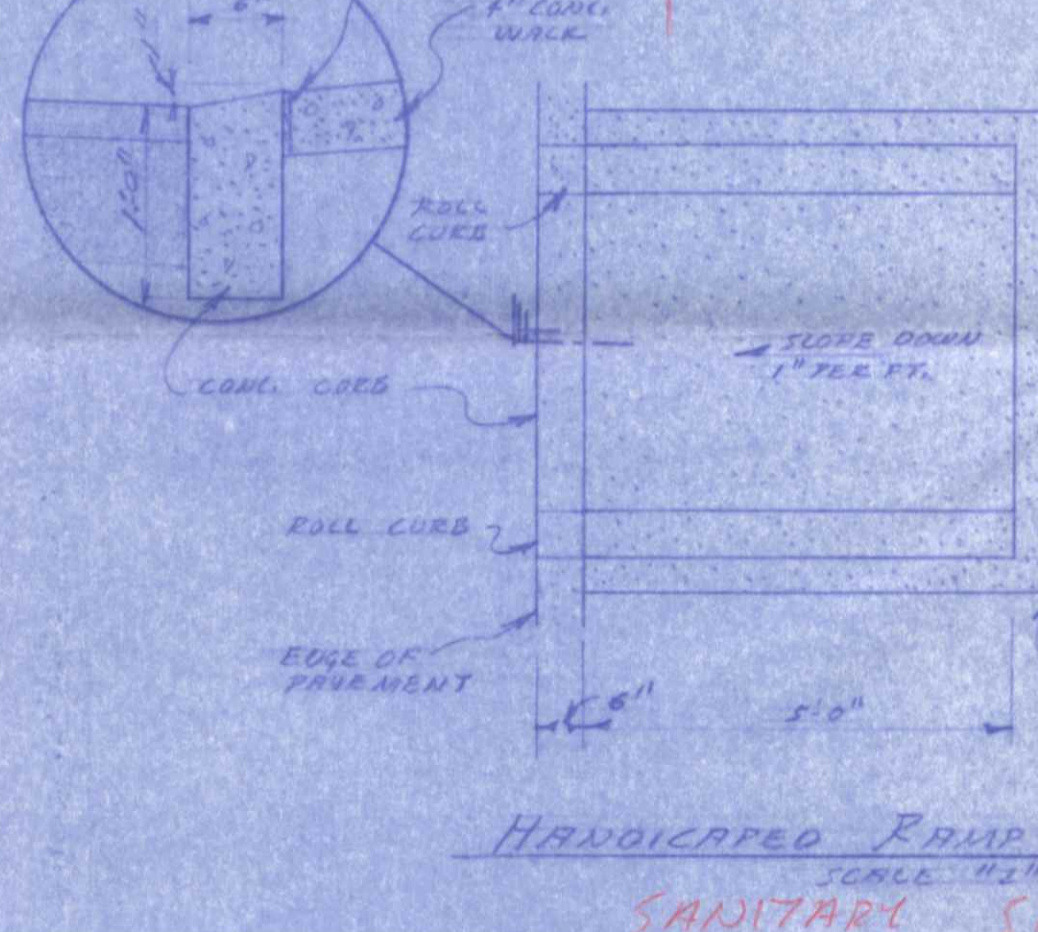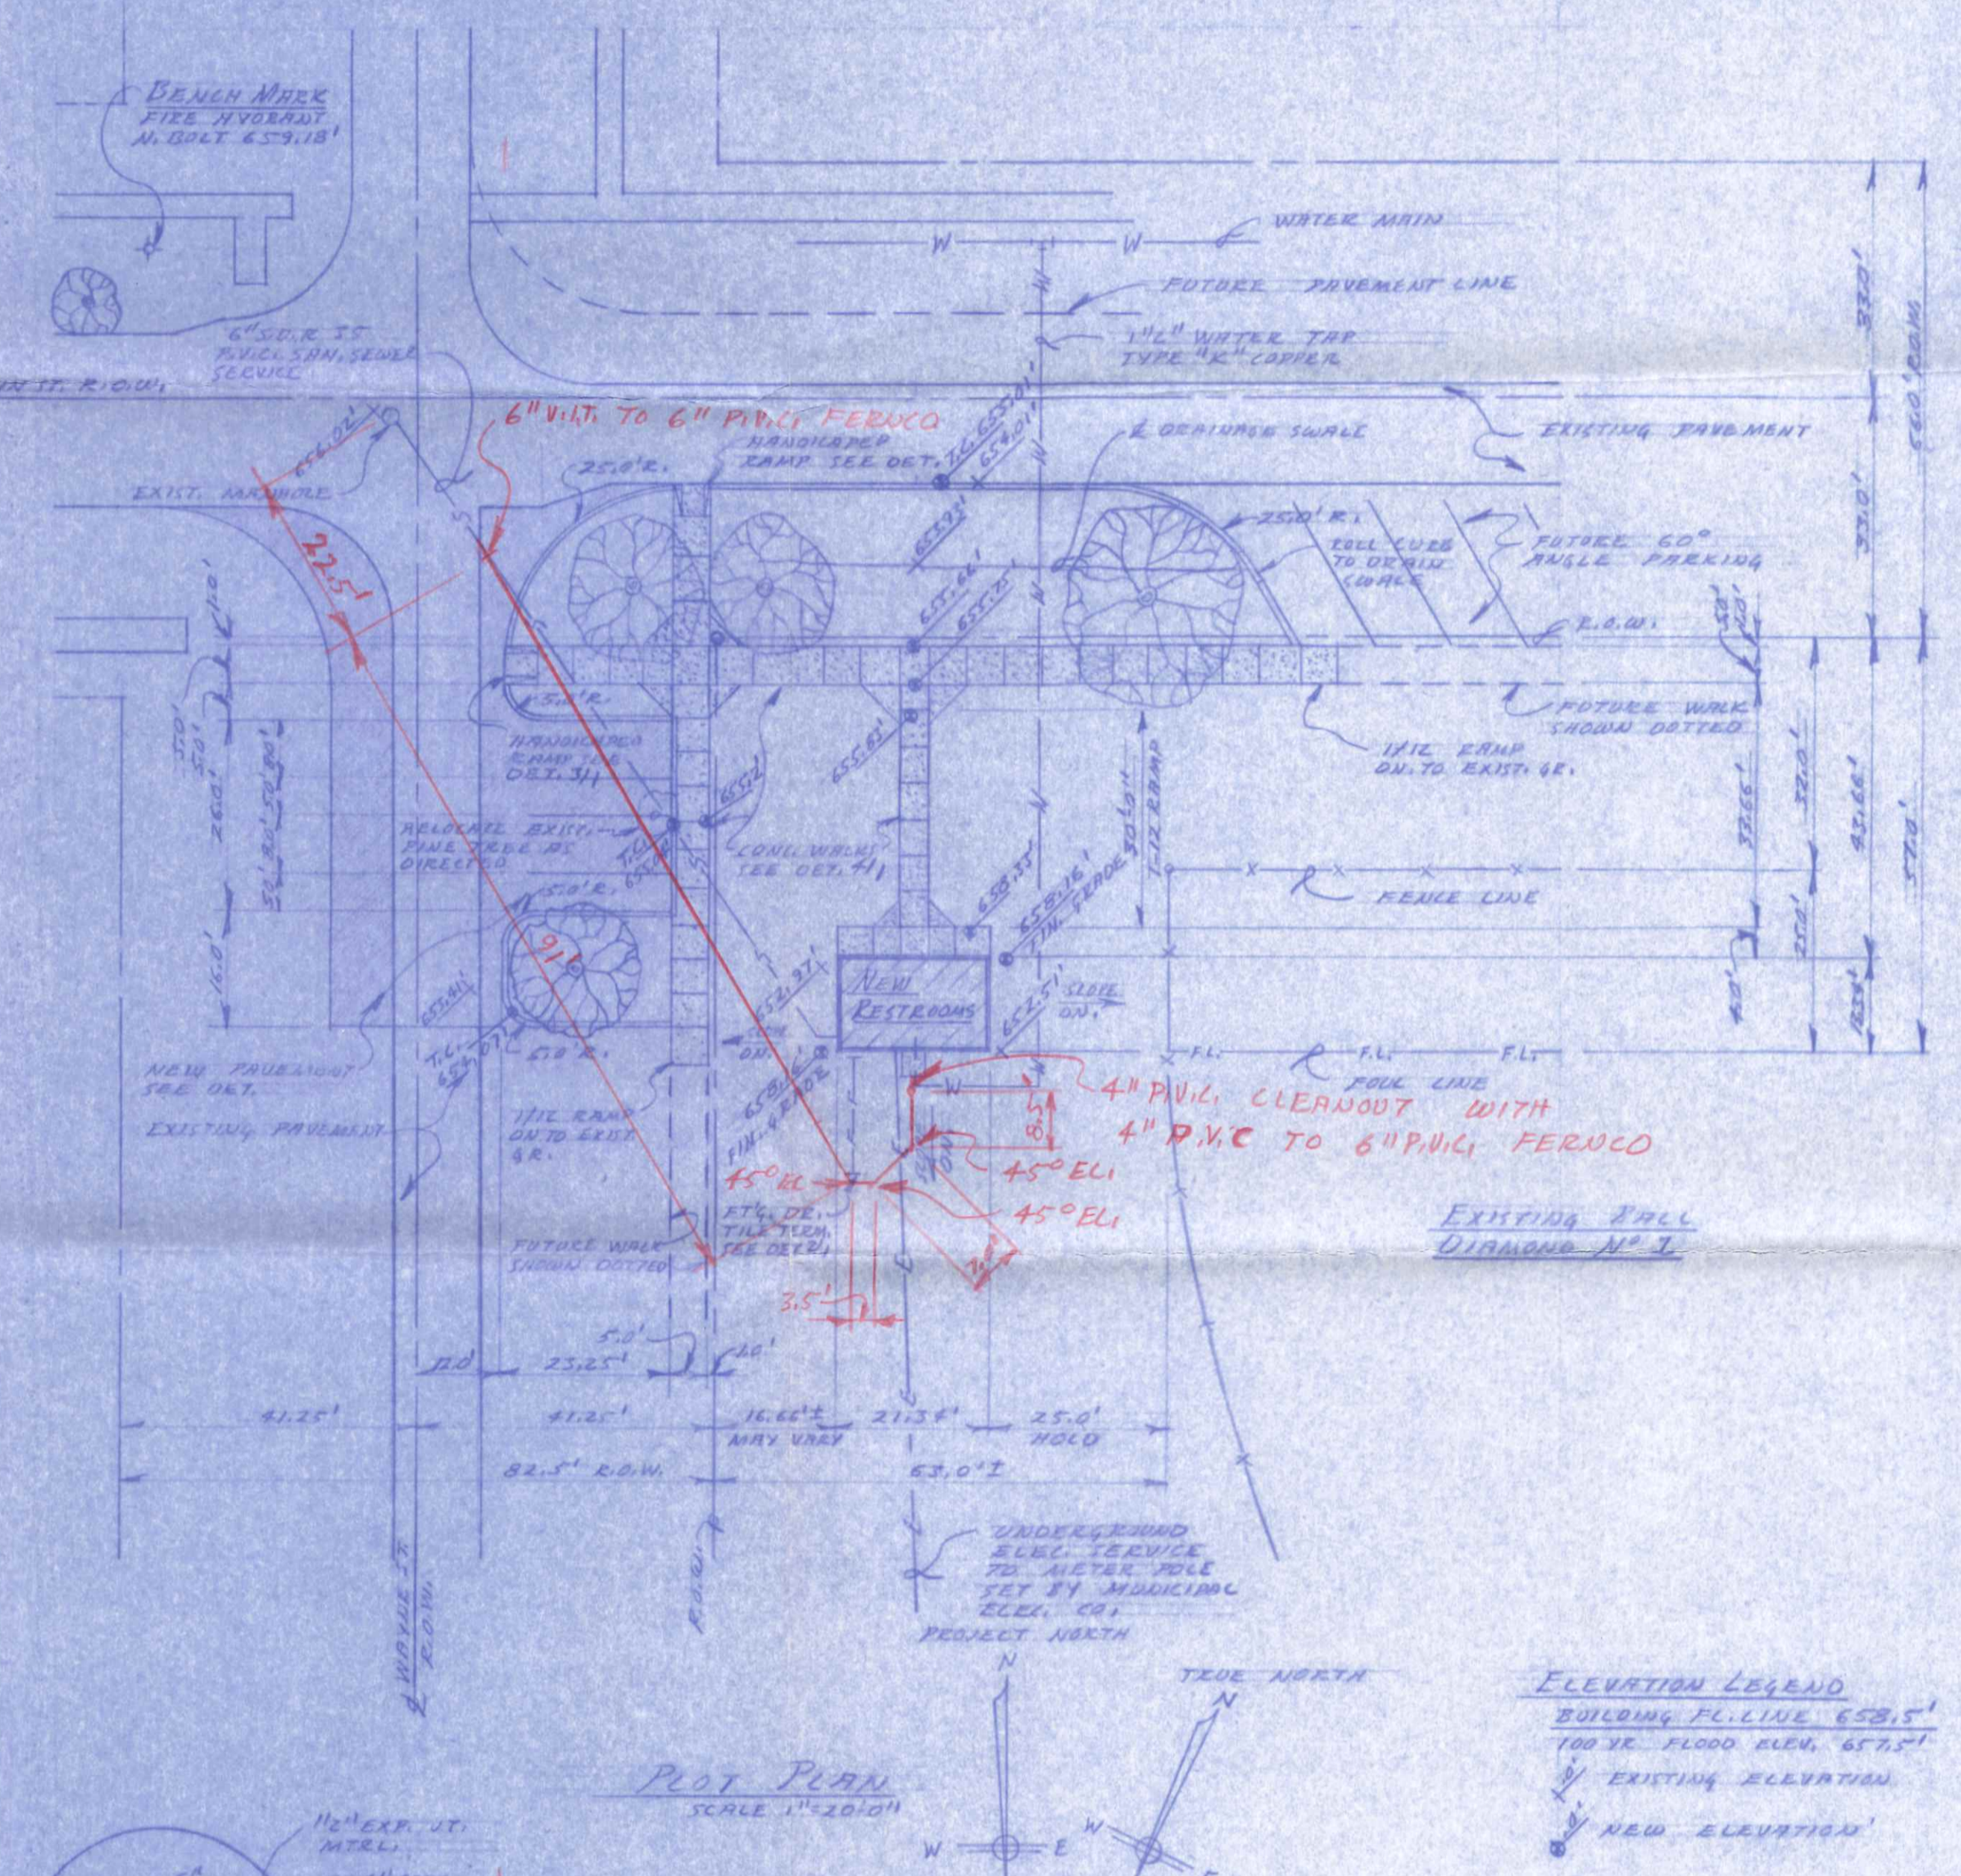

SANITARY SOURCE TAP AS BUILT

EAST RIVERDOWNS PARK RESTROOMS

CORNER OF E. MAIN + RICHARDI ST. NORTHEAST, OHIO

CITY OF NAPLES ENGINEERING DEPARTMENT
MARK S. GERKEN CITY ENGINEER

DATE 3-31-88
SCALE AS NOTED
DRAWN BY E. OF 3

SITE PLAN, FLOOR PLAN, + FOUND. PLAN 1087-87
JOB NO. 1087-87
DATE 3-31-88
SCALE AS NOTED
DRAWN BY E. OF 3