

SEWER TAPPING PERMIT

Issued by  
The City of Napoleon Engineering Dept.  
255 West Riverview Ave. Napoleon, Ohio 43545 Ph. 592-4010

Entry No. \_\_\_\_\_  
Permit No. ~~JA 0125~~ Issued 6-8-89 <sup>0125</sup> Build. Permit No. \_\_\_\_\_  
Permit Fee \$ 60.<sup>00</sup>

Job Location 516 E Main St  
Lot \_\_\_\_\_  
Street Bond \$ \_\_\_\_\_  
Date Paid 6-8-89

Issued By \_\_\_\_\_  
sub div. or legal disc.

Owner Lou McCabe Ph. \_\_\_\_\_

Address 516 E Main St

Agent Jerry Glang Ph. 599-4103

Address 6 Riverview Dr.  
for office use only

WORK INFORMATION

Sanitary Sewer Tap ✓ Size of Tap 6" Size and Type of Sewer \_\_\_\_\_ Street to be Opened X  
yes no \_\_\_\_\_ yes no \_\_\_\_\_  
Storm Sewer Tap \_\_\_\_\_ Size of Tap \_\_\_\_\_ Size and Type of Sewer \_\_\_\_\_ Street to be Opened \_\_\_\_\_  
yes no \_\_\_\_\_ yes no \_\_\_\_\_  
Street opening Agreement Approval Date None Opening Bond Fee (Set by Engineer) \_\_\_\_\_

READ AND SIGN BELOW; The undersigned hereby agrees complete the work described above and to make use of said sewers only as allowed by and in strict accordance with all applicable provisions of The Napoleon Engineering Dept. Rules and Regulations; The Napoleon Standard Specification for Water Main, Sanitary Sewer and Storm Sewer Construction and other Pertinent Sections of the Napoleon Code of Ordinances.

Date June 8, 89 Signature of Applicant Jerry Glang  
Permit not valid without signature

INSPECTION RECORD \_\_\_\_\_ to be completed by the Field Inspector


Date Inspection is made 6-8-89 Size and Type of Sewer 6 P.U.C.

Location \_\_\_\_\_ Depth \_\_\_\_\_ Type of Test \_\_\_\_\_ Additional Information \_\_\_\_\_  
See Sketch

Date 6-8-89 Inspected By Malcolm Helms  
signature of inspector

Sketch Of Installation on Back or Attached

PAID  
JUN 08 1989  
CITY OF NAPOLEON

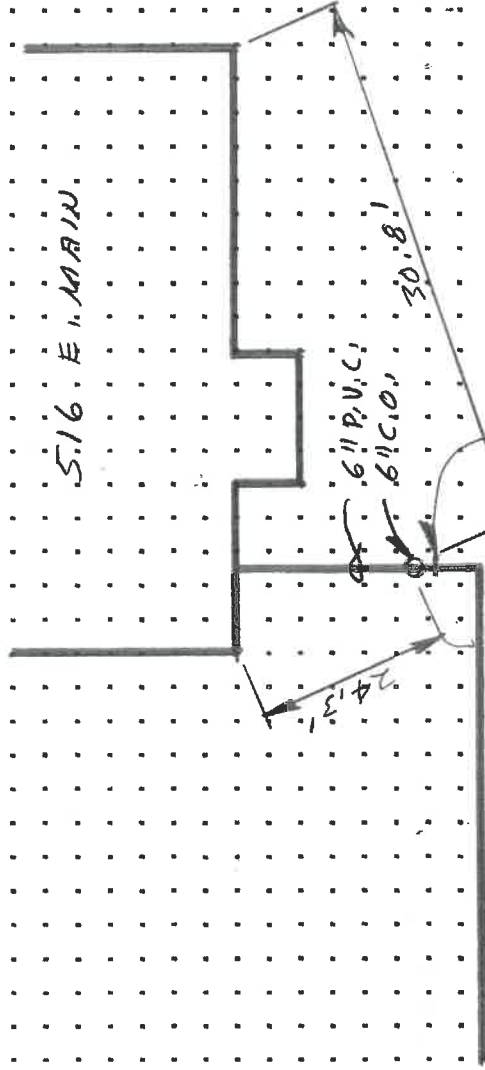

5.16 E. MAIN

24.3'

6" P.V.C.

6" C.O.

30.8'

CONNECT TO EXISTING  
6" V.P.

E. MAIN ST.

DIAG

PLAN

SECTION

South

