

FILE



City of NAPOLEON

ENGINEERING DEPARTMENT

255 W. Riverview Avenue, PO Box 151, Napoleon, OH 43545
Phone: 419-592-4010 - Fax: 419-599-8393

Mayor
J. Andrew Small

Members of Council
Glenn A. Miller
President

Terri A. Williams
Ronald Behm
Travis B. Sheaffer
John A. Helberg
Steven C. Small
Michael J. DeWit

City Manager
Dr. Jon A. Bisher

Finance Director
Gregory J. Heath

Law Director
David M. Grahm

City Engineer
Chad E. Lulfs, P.E., P.S.

August 18, 2006

Holt Investment Properties
15-202 Co. Rd. K
Napoleon, Ohio 43545

Attn: Tim Holt

Re: 158 E. Maumee Avenue
Sewer Relocation Notice

Dear Mr. Holt,

Last year the City of Napoleon replaced the deteriorated sanitary main along the river with a new sanitary main along E. Maumee Avenue. Sanitary leads were installed to the right-of-way line for each property when the main was installed. Because of the deterioration of the existing main, property owners are required to tie into the new sanitary services that have been provided. All expenses to make this tie in are the responsibility of the property owner.

This letter shall serve as notice that you have ninety (90) days from the date listed above to address this situation. If actions are not taken by such time, water service to the property shall be terminated. Please contact our office for all appropriate permits and to schedule inspections. A sketch of the location of your sanitary sewer tap has been enclosed. If you have any questions or require additional information, please contact me at your convenience.


Yours truly,

Chad E. Lulfs, P.E., P.S.
City of Napoleon Engineer

cc: Jon A. Bisher, City Manager
Tom Zimmerman, Building & Zoning Inspector
Rex Moll, Construction Inspector

Encl.

Date Installed: 10-25-06
Installed by: Vernon Nagel Constr.
Inspected by: Rex Moll

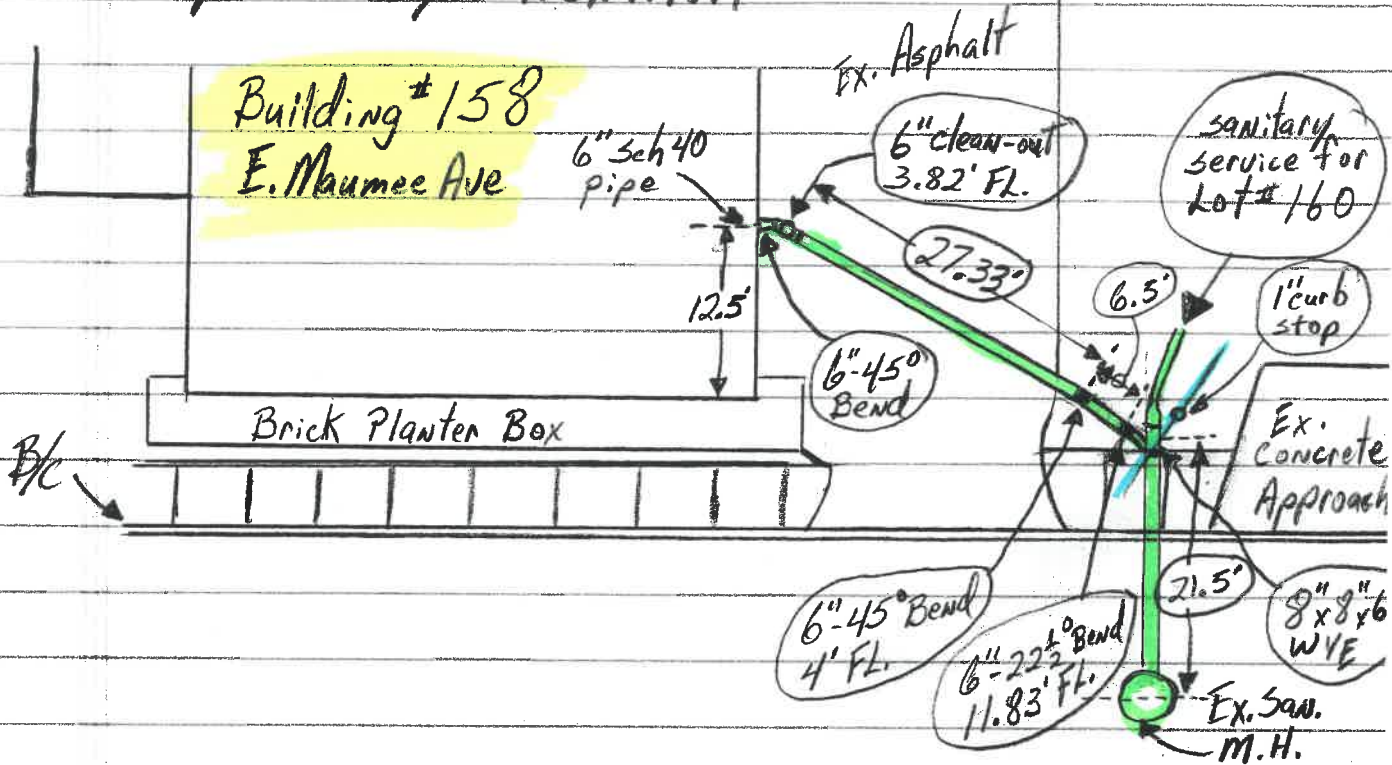

E. Maumee Ave.

B/C