

SEWER TAPPING PERMIT

Issued by

The City of Napoleon Engineering Dept.

255 West Riverview Ave. Napoleon, Ohio 43545 Pn. 592-4010

Entry No. _____

Permit No. _____ Issued 8-26-91 Build. Permit No. _____

Job Location ~~433~~ E Maumee

Lot _____

Issued By BND sub div. or legal disc.

Owner Genaviv Murray Pn. _____

Address 133 E Maumee

Agent Jerry Glanz Pn. 599-4103

Address 6 Lakeview Dr.

Permit Fee \$ 10

Street Bond \$ _____

Date Paid _____

SCANNED

for office use only

WORK INFORMATION

Sanitary Sewer Tap yes no Size of Tap 6" Size and Type of Sewer 4" PVC SDR Street to be Opened yes no

Storm Sewer Tap yes no Size of Tap _____ Size and Type of Sewer _____ Street to be Opened yes no

Street opening Agreement Approval Date _____ Opening Bond Fee (Set by Engineer) _____

READ AND SIGN BELOW; The undersigned hereby agrees complete the work described above and to make use of said sewers only as allowed by and in strict accordance with all applicable provisions of The Napoleon Engineering Dept. Rules and Regulations, The Napoleon Standard Specification for Water Main, Sanitary Sewer and Storm Sewer Construction and other Pertinent Sections of the Napoleon Code of Ordinances.

Date _____ Signature of Applicant _____
Permit not valid without signature

INSPECTION RECORD _____ to be completed by the Field Inspector

Date Inspection is made 8-26-91 Size and Type of Sewer _____

Location See back Depth 4' F/L Type of Test _____ Additional Information See back

Date 8-26-91 Inspected By Brent M. [Signature]
signature of inspector


Sketch Of Installation on Back or Attached

Genarive Murray

8-26-91

Jerry Glanz

Continued from 145 E. Maumee

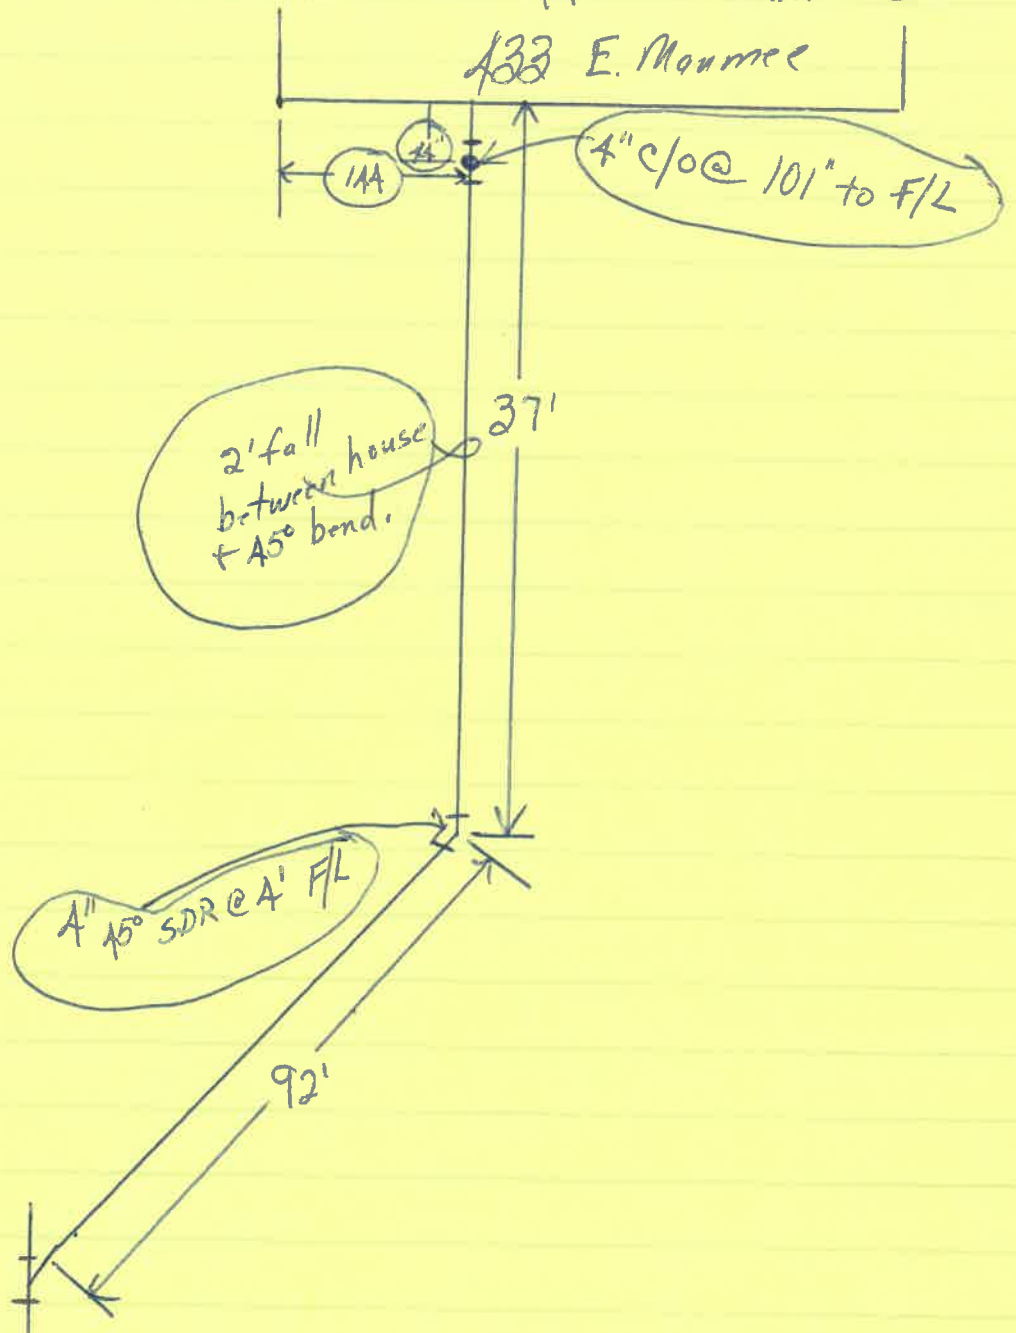


S
445 E. Mountain
433 E. Mountain + 445
4" c/o @ 3.0' F/L

8-23-91

Rick Thayer
Genevive Murray
----- P/L

New 6" PVC SDR

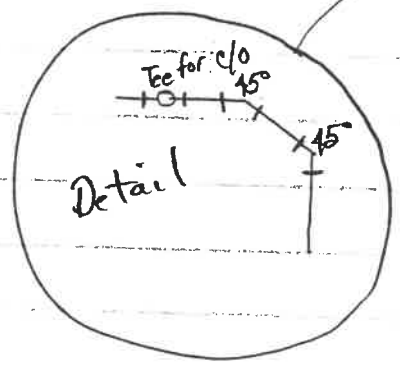

6" c/o @ 4.0' to F/L

2' center to center

6" x 4" y to West for Murray tap

119.10

W

9'

sanitary tap @ 7.9' F/L
from top of ground
5.4' to F/L

electric pole
on P/L

10'
23'
5'