

SEWER TAPPING PERMIT

Issued by

The City of Napoleon Engineering Dept.

255 West Riverview Ave. Napoleon, Ohio 43545 Pn. 592-4010

Entry No. \_\_\_\_\_

Permit No. SAO 160 Issued \_\_\_\_\_ Build. Permit No. \_\_\_\_\_

. X Permit Fee \$ 60.<sup>00</sup>

Job Location 451 W Maurice \_\_\_\_\_

. Street Bond \$ - 0 -

Lot \_\_\_\_\_

. Date Paid 1-2-91

Issued By Brent N. Dammann sub div. or legal disc. \_\_\_\_\_

Owner Mrs. Doyle Pitter Pn. \_\_\_\_\_

Address 451 W Maurice \_\_\_\_\_

Agent Ward Code Obj Pn. 758-3855

Address RR# 4 Napoleon, Ohio \_\_\_\_\_

for office use only

WORK INFORMATION

Sanitary Sewer Tap  Size of Tap 6" Size and Type of Sewer Vit. Street to be Opened \_\_\_\_\_

Storm Sewer Tap \_\_\_\_\_ Size of Tap \_\_\_\_\_ Size and Type of Sewer \_\_\_\_\_ Street to be Opened yes no

Street opening Agreement Approval Date \_\_\_\_\_ Opening Bond Fee (Set by Engineer) yes no

READ AND SIGN BELOW; The undersigned hereby agrees complete the work described above and to make use of said sewers only as allowed by and in strict accordance with all applicable provisions of The Napoleon Engineering Dept. Rules and Regulations, The Napoleon Standard Specification for Water Main, Sanitary Sewer and Storm Sewer Construction and other Pertinent Sections of the Napoleon Code of Ordinances.

Date 1/2/91 Signature of Applicant [Signature]

Permit not valid without signature

INSPECTION RECORD \_\_\_\_\_ to be completed by the Field Inspector

Date Inspection is made 1-2-91 Size and Type of Sewer 6" Existing Vit.

Location \_\_\_\_\_ Depth 4.0' Type of Test No Additional Information \_\_\_\_\_

Installed 4' of 6" P.V.C. and Clean out

Date 1-2-91 Inspected By Malcolm Helberg

signature of inspector


Sketch Of Installation on Back or Attached

PAID


JAN 03 1991

CITY OF NAPOLEON

N

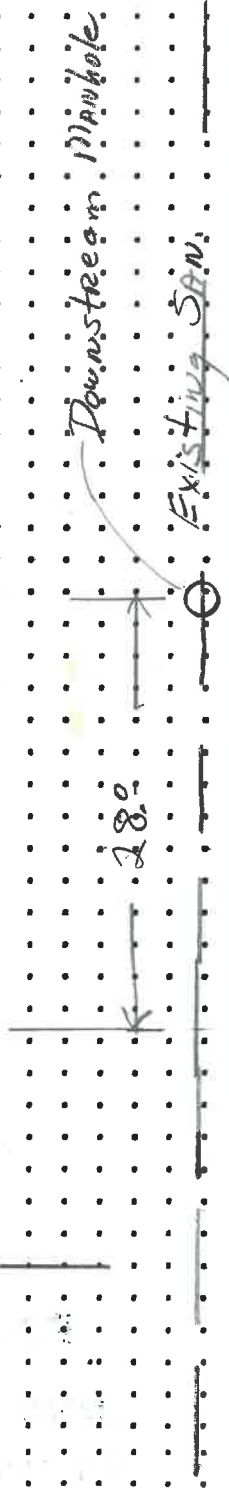

W. Maumee

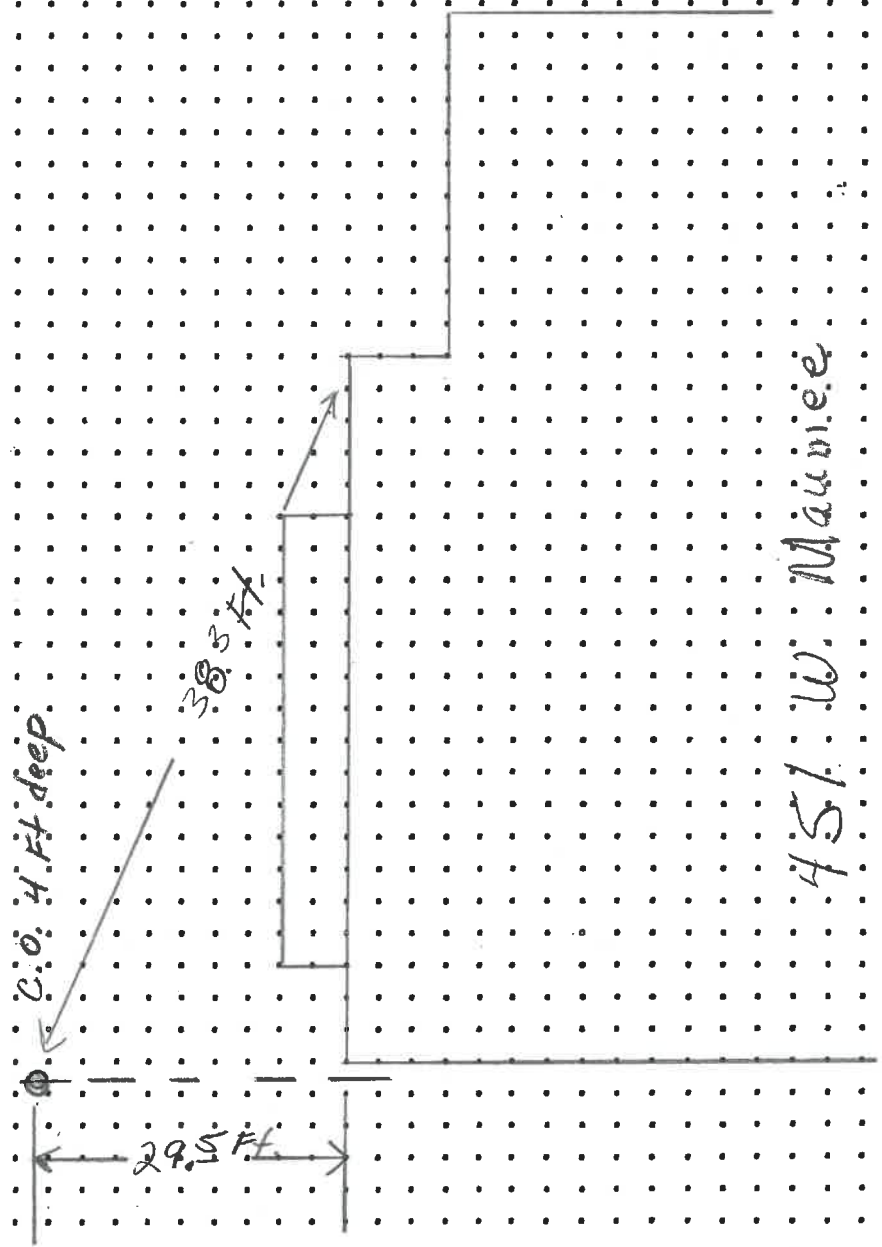

451 W. Maumee