

**CITY OF NAPOLEON
BUILDING CONSTRUCTION PERMIT
(1, 2 or 3 Family Dwelling)**

Owner Name WILLIAM KRUSE
 Address 503 W. MAUMEE AVE.
 Builder Name BERGSTEDT BUILDERS
 Address 1050 DODD ST. Tel. 592-3451

Permit No.	<u>443-75</u>		
Issued	<u>12-9-75</u>		
By	<u>T. W. T.</u> Building Inspector		
Valuation		
	Fees	Base	Plus Total
Construction
Plumbing
Electrical
Heating
Water Tap
Sewer Tap
Temporary Elec.
TOTAL

Lot Information:

Street No. 503 W. MAUMEE AVE.
 Lot Subdivision
 Lot Dimensions Lot Area Sq. Ft.
 Yard Set Back: Front Rear
 Side Side

Zoning Intended use of Building:

Building Information:

Single Double Multiple New Construction Addition Remodel
 Size: Length Width No. of Stories
 Floor Area: 1st Floor 2nd Floor 3rd Floor Basement
 Unfinished Attic Garage
 Foundation: Piers Full Basement Part Basement
 Concrete Block
 Walls: Frame Block Brick Other
 Electrical: Wiring Electric Heating Electrical Appliances
 Plumbing: Fixtures or Traps Warm Air Heating Hot Water Heating

Additional Information:

Date Applicant Signature
 Owner - Builder - Agent

Inspection Record:

Work Started <u>12/8/75</u>	Foundations	Plumbing, Heating
<u>12/8/75</u> ch'd by <u>P.W.F.</u> ok	Plumbing (Rough In)	And Air Conditioning
Set Back, Side Lines	Erecting Frame	Roof
Excavation <u>12/8/75</u>	Electrical Work	
Footings <u>12/8/75</u> poured ok. <u>P.W.F.</u>		

Comments:

Certificate of Occupancy Issued

Pink - Engineer Inspector

Approved Footers 12/3/75 *Ref.*

William Kruse
Bergstedt Builders

503 W Maumee
1050 Dodd. 592-3451

X 503 W Maumee

Lot #

Lot Area X 9280 Sq. Ft.

Front X 29'6"

Rear X 95'0"

Left Side X 10'0"

Right Side X 12'0"

Zoning District "A"

UTILITY INFORMATION:

Single _____ Double _____ Multiple _____ New Construction _____

Addition X Remodel _____ Attached Garage _____

Detached Garage _____ Accessory Building _____ Replacement _____

Brief Description of Work: Cement Paved open side with roof.

Size: Length _____ Width _____ No. of Stories 1

Floor Area: 1st Floor 60 Sq. Ft. 2nd Floor _____ Sq. Ft.

3rd Floor _____ Sq. Ft. Basement _____ Sq. Ft.

Unfinished Attic _____ Garage _____

Foundation: Piers _____ Full Basement _____ Part Basement _____

Concrete _____ Thickness _____ Block _____ Size _____

Walls: Frame _____ Block _____ Brick _____ Other _____

Specific Type of Exterior Siding _____

APPLICATION FOR PERMIT SHALL BE ACCOMPANIED BY TWO COMPLETE SETS OF PLANS INCLUDING: ELEVATIONS, FLOOR PLANS, CROSS SECTIONS AND PLOT PLAN. IF ADDITIONS OR REMODELING, SHOW ALL EXISTING STRUCTURES AND THEIR SIZE AND LOCATION. ALL PLANS SHALL BE DRAWN TO 1/4"=1'-0" SCALE. PLOT PLAN DRAWN TO 1/8"=1'-0" SCALE.

ESTIMATED COST OF COMPLETED PROJECT: X 500.⁰⁰

DATE Dec 8, 1975 APPLICANT'S SIGNATURE Donald Bergstedt
OWNER-BUILDER-AG

85
35-6
500

60
130-6
29.6

atky

85
26
49
111


95ft

36

95ft

43 ft Center
of road

Red line
12 1/2

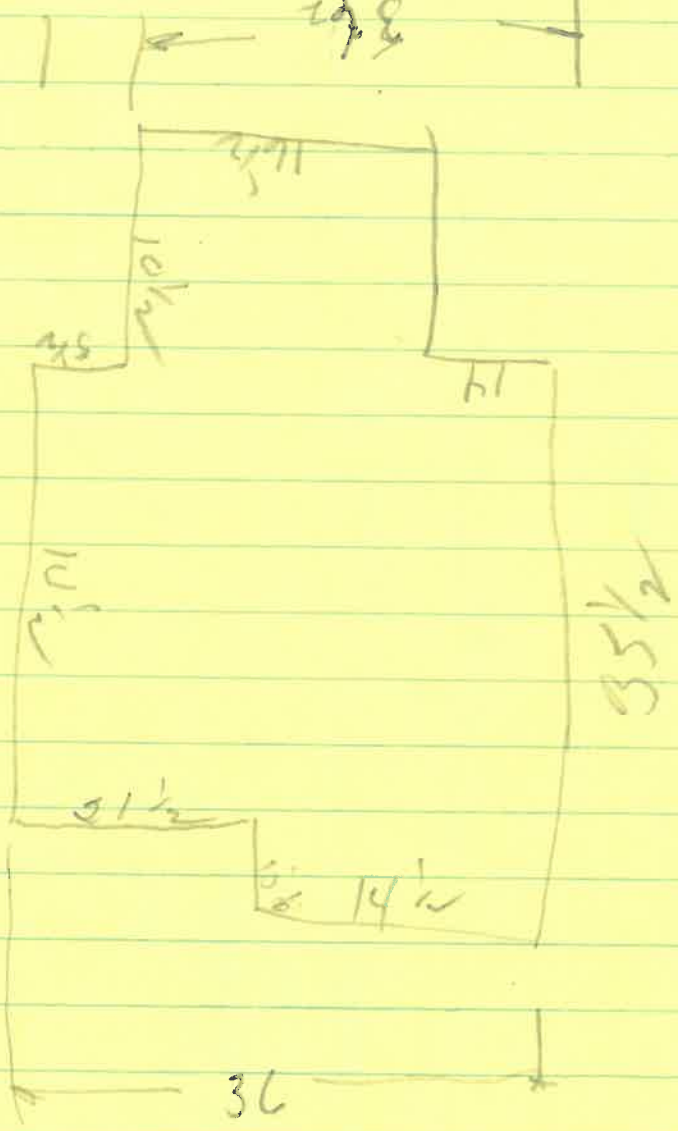

Measurements
to center

100
26
74