

SEWER TAPPING PERMIT

Issued by

The City of Napoleon Engineering Dept.

255 West Riverview Ave. Napoleon, Ohio 43545 Pn. 592-4010

Entry No. _____

Permit No. S.A. 0132 Issued 3-30-90 Build. Permit No. 01944

Permit Fee \$ 60.00

Job Location 910 Melody Lane

Street Bond \$ _____

Lot 11 Brick Yard

Date Paid 3-30-90

Issued By FH sub div. or legal disc.

Owner Mike Michaelis Pn. 592 0323

Address 125 W Washington

Agent Beck's Const Co Pn. 592 8307

Address 11622 Rd M Nap O

for office use only

WORK INFORMATION

Sanitary Sewer Tap Size of Tap 4 Size and Type of Sewer Plastic Street to be Opened

Storm Sewer Tap Size of Tap 4 Size and Type of Sewer Plastic Street to be Opened

Street opening Agreement Approval Date _____ Opening Bond Fee (Set by Engineer) _____

READ AND SIGN BELOW; The undersigned hereby agrees complete the work described above and to make use of said sewers only as allowed by and in strict accordance with all applicable provisions of The Napoleon Engineering Dept. Rules and Regulations, The Napoleon Standard Specification for Water Main, Sanitary Sewer and Storm Sewer Construction and other Pertinent Sections of the Napoleon Code of Ordinances.

Date 3/30/90 Signature of Applicant Robert L Beck
Permit not valid without signature

INSPECTION RECORD _____ to be completed by the Field Inspector

Date Inspection is made 4-9-90 Size and Type of Sewer 4" S.D.R. 11 ASTM 3034


Location SEE PLAN Depth 7.5' @ TAP Type of Test NOOT Additional Information _____

Date 4-9-90 Inspected By SONNY HELDER
signature of inspector

Sketch Of Installation on Back or Attached

SITE PLAN FOR
BECKS CONSTRUCTION CO.


LOT NO. 11, PHASE I BRICKYARD SUE-
DIVISION, CITY OF NAPOLEON, HENRY CO. OHIO.

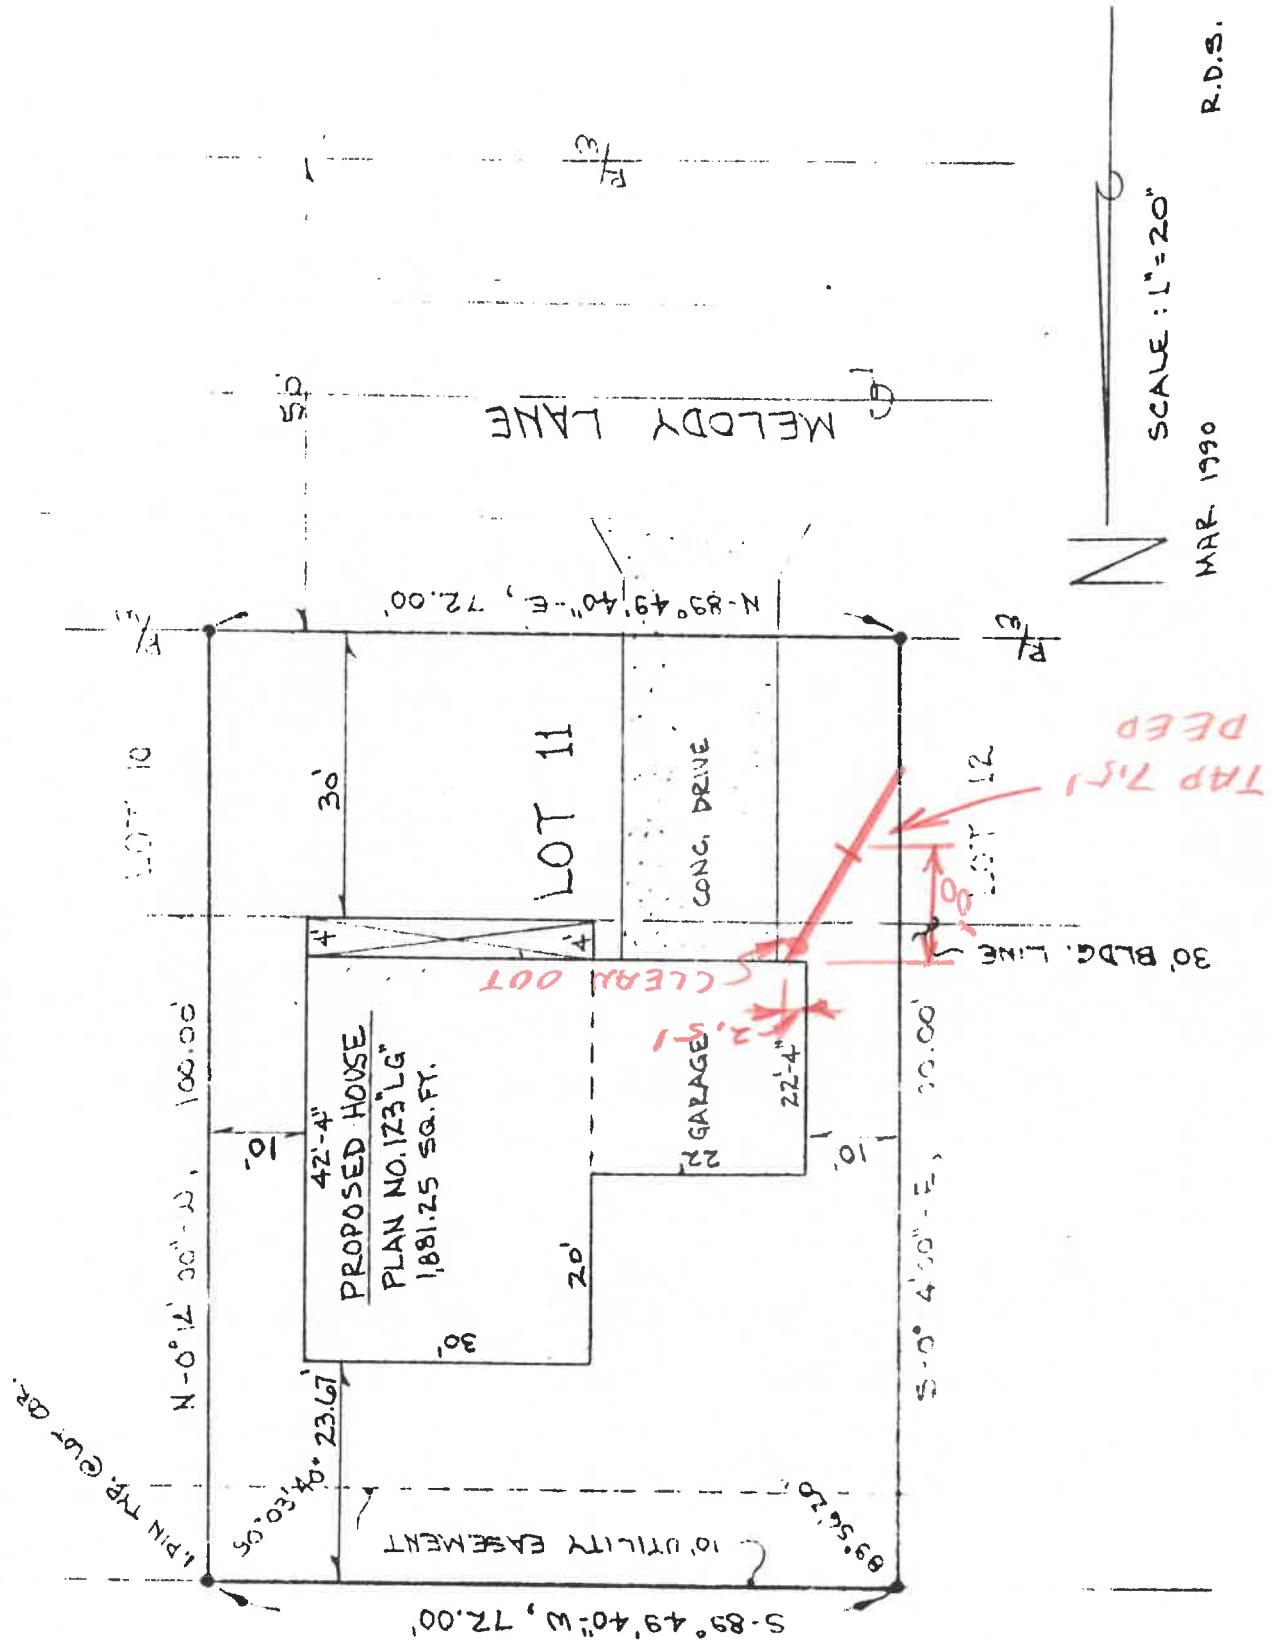

TO: 592-1537 FROM:

SUBJECT: DATE:

Lot 11

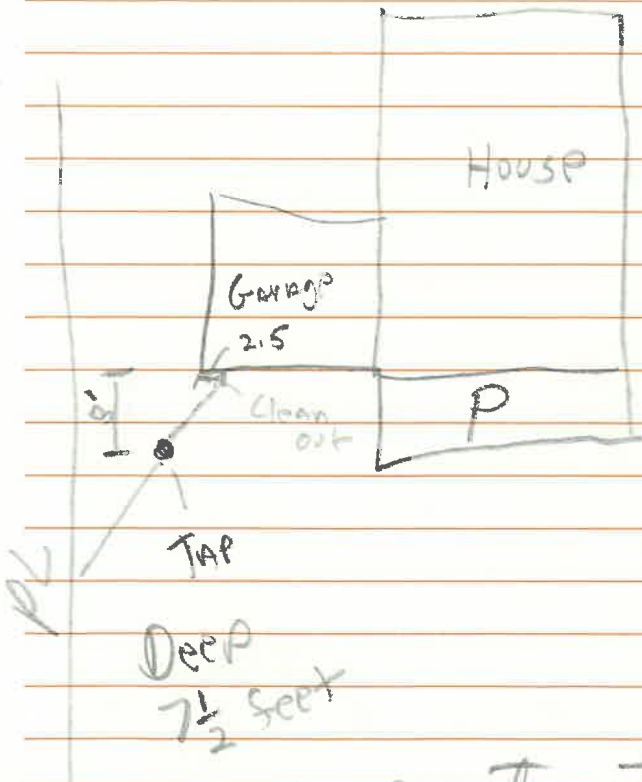

Becks Construction

4-9-90

Hausman Steel Corporation

801 W. Goodale Boulevard • Columbus, OH 43212

614/221-3194 • FAX 614/224-1679

HAUSMAN IS OUR NAME — SERVICE IS OUR GAME

FIELD CORRECTION NOTICE

LOCATION 910 + 915 MELODY LANE PERMIT NO. 01943 & 01944

ISSUED TO BECK'S CONSTRUCTION
PERMIT HOLDER AND/OR ALL RESPONSIBLE PARTIES.

NOTICE DELIVERED TO BECK'S CONSTRUCTION 11-622 RD M

Upon inspection, violations of the C.A.B.O. Sec. SEE ATTACHED INFO were in evidence.

The following orders are hereby issued for their correction:

INSTALL 2 - 1/2" DIA x 18" ANCHOR BOLTS PER
CRAWL SPACK FOUNDATION PIER TO ATTACH THE
FLOOR GIRDERS TO THE PIERS. BOLTS TO EXTEND
15" INTO CONC. BLOCK PIERS.

PLEASE CALL FOR INSPECTION WHEN CORRECTIONS HAVE BEEN COMPLETED. ACCEPTANCE AND APPROVAL BY AN INSPECTOR OF THIS DEPARTMENT IS REQUIRED AND MUST BE CORRECTED

ON OR BEFORE INSTALLING FLOOR DECK

DATE 4-9-90

BY ELDON HUBER
INSPECTOR

PINK - ORIGINAL COPY WHITE - FIELD COPY YELLOW - FILE COPY