

APPLICATION FOR PERMIT TO TAP SEWER

Owner MARIE PAUNING
ADDRESS _____
CONTRACTOR BECK'S CONSTRUCTION
ADDRESS 11622 RDM TEL. 592-8307

NO. SA 001987
BLDG. PERMIT 01398
~~PERMIT~~ INSPECTION FEE \$ 60.00
STREET BOND N.A.
DATE PAID 6-29-87

For office use only

LOCATION OF CONNECTION

Street and No. 925 MELODY LAKE Sanitary Storm _____
Lot No. 7 Subdivision BRICKYARD SUB DIV. Size of Tap 4"
Size and Type of Sewer 4" P.V.C. ALL WORK MUST BE INSPECTED
Street to be opened-Yes _____ No Opening bond fee set by Engineer \$ N.A.
Street opening agreement approval date _____

I certify that the sewer will be used only as indicated and no other drainage will be connected.

Date 7/30/1987 Signature Robert S Beck
Owner-Builder-Agent

DO NOT WRITE BELOW THIS LINE

INSPECTION RECORD


Date Inspected _____ Size and Type of Sewer _____
Location SEE ATTACHED SITE Depth _____ Type of Test _____
Inspected and Approved by: ^{PLAW} Malcolm Helberg 7-24-87
Inspector Date

Additional information _____




Send copy to: _____

SKETCH OF INSTALLATION - ON BACK


SANITARY SEWER
TAP

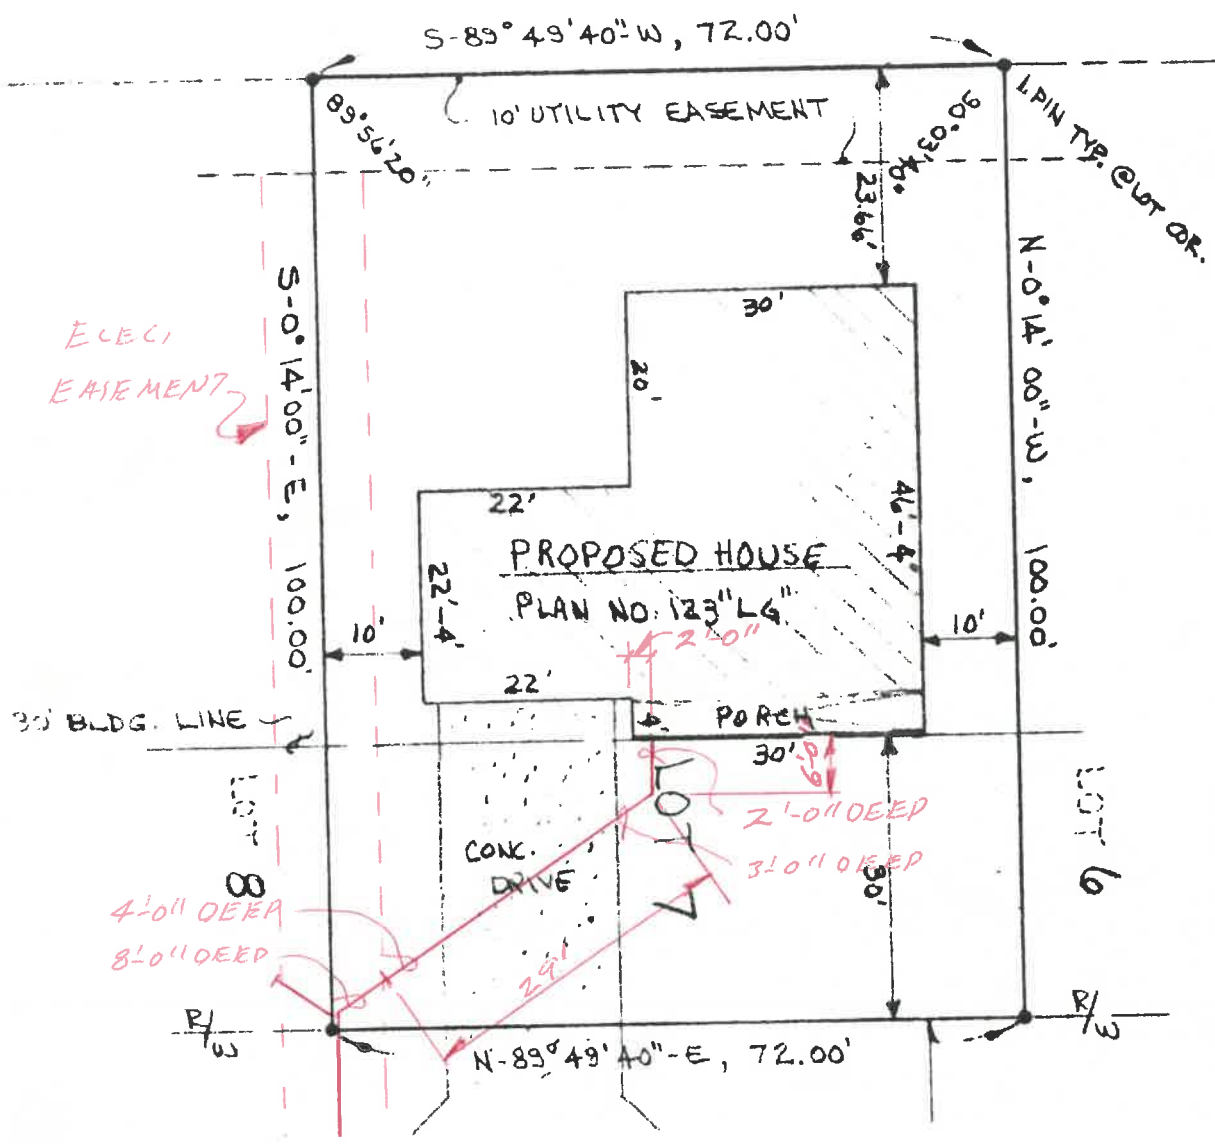

SITE PLAN FOR
BECKS CONSTRUCTION CO.
LOT NO. 7, PHASE I BRICKYARD SUB
DIVISION, CITY OF NAPOLEON, HENRY CO. OHIO

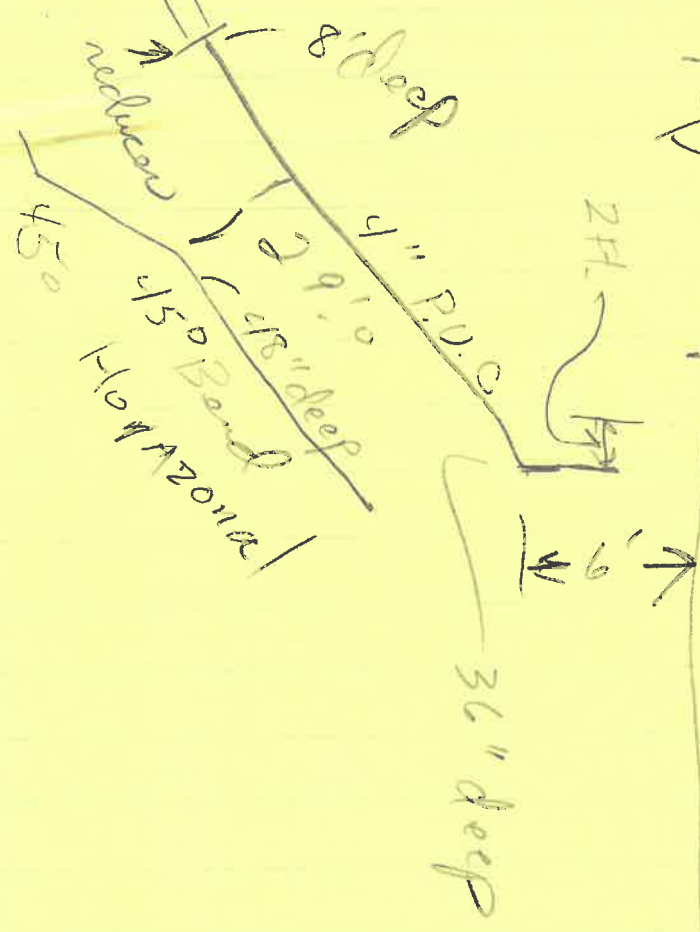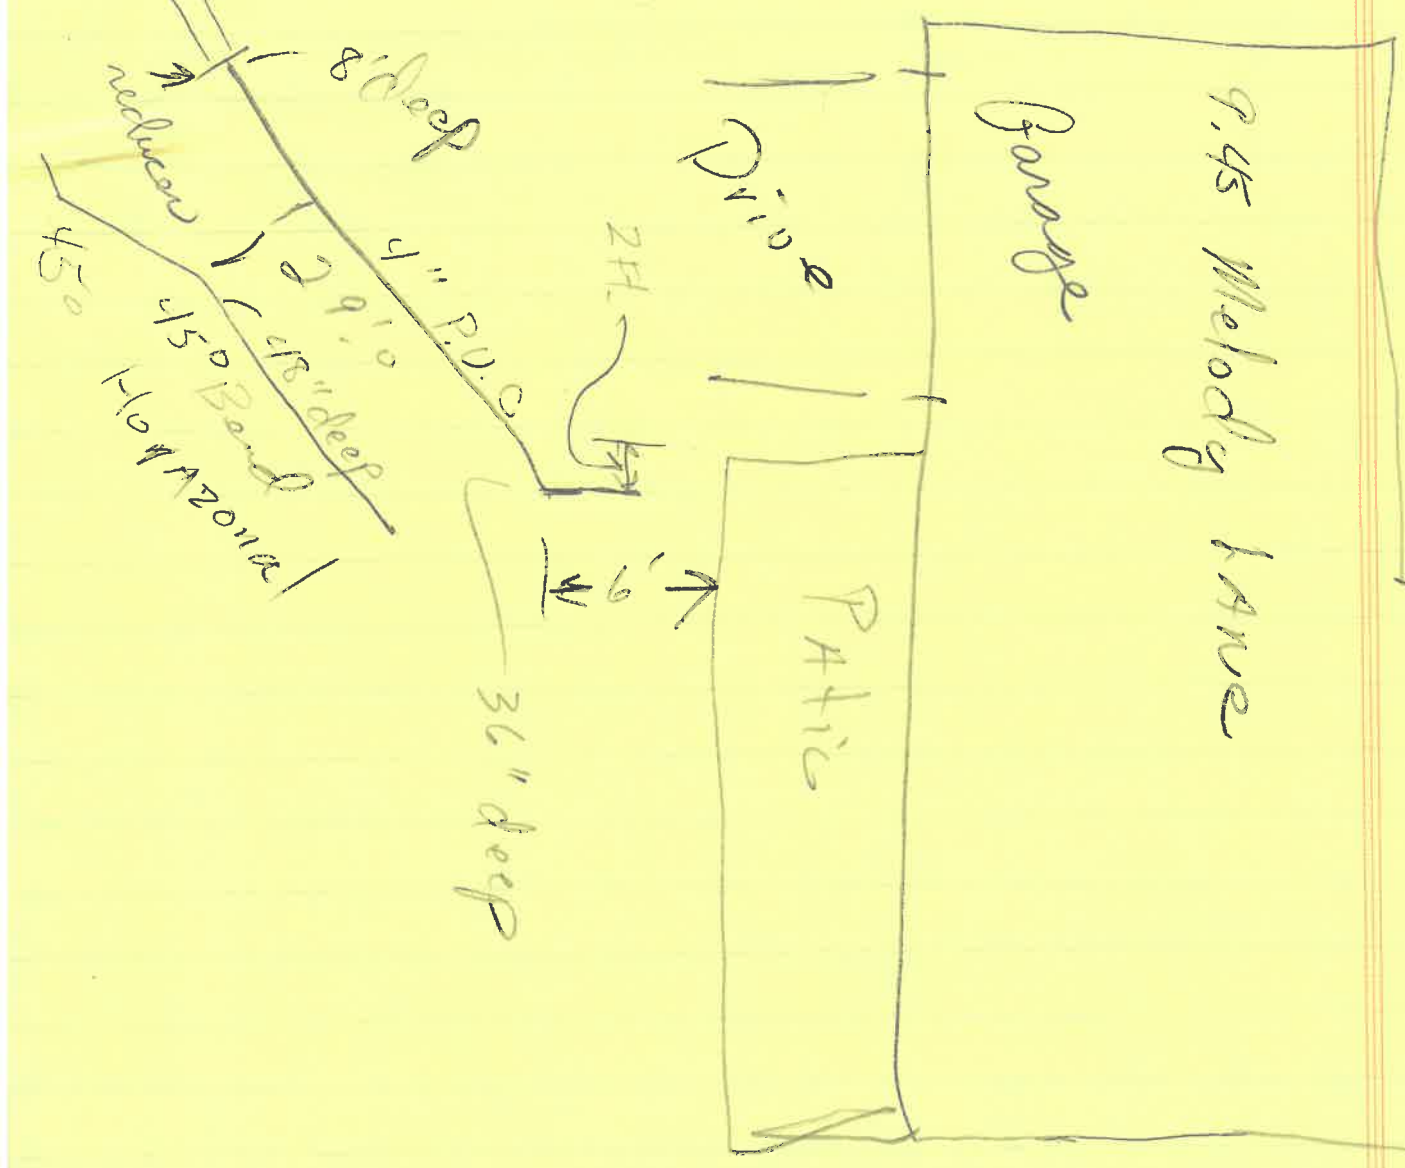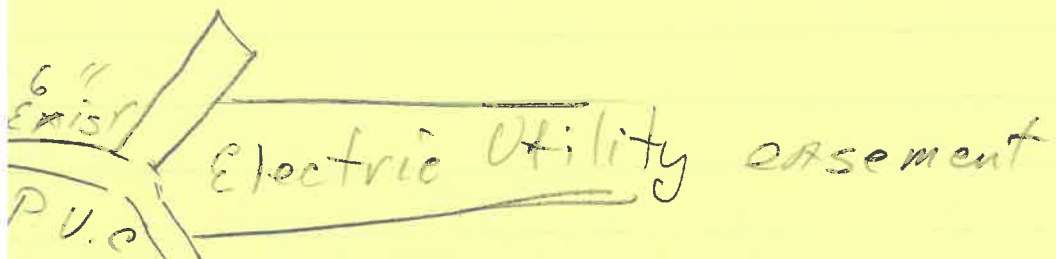

**SITE PLAN FOR
BECKS CONSTRUCTION CO.
LOT NO. 7, PHASE I BRICKYARD SUB-
DIVISION, CITY OF NAPOLEON, HENRY CO. OHIO.**

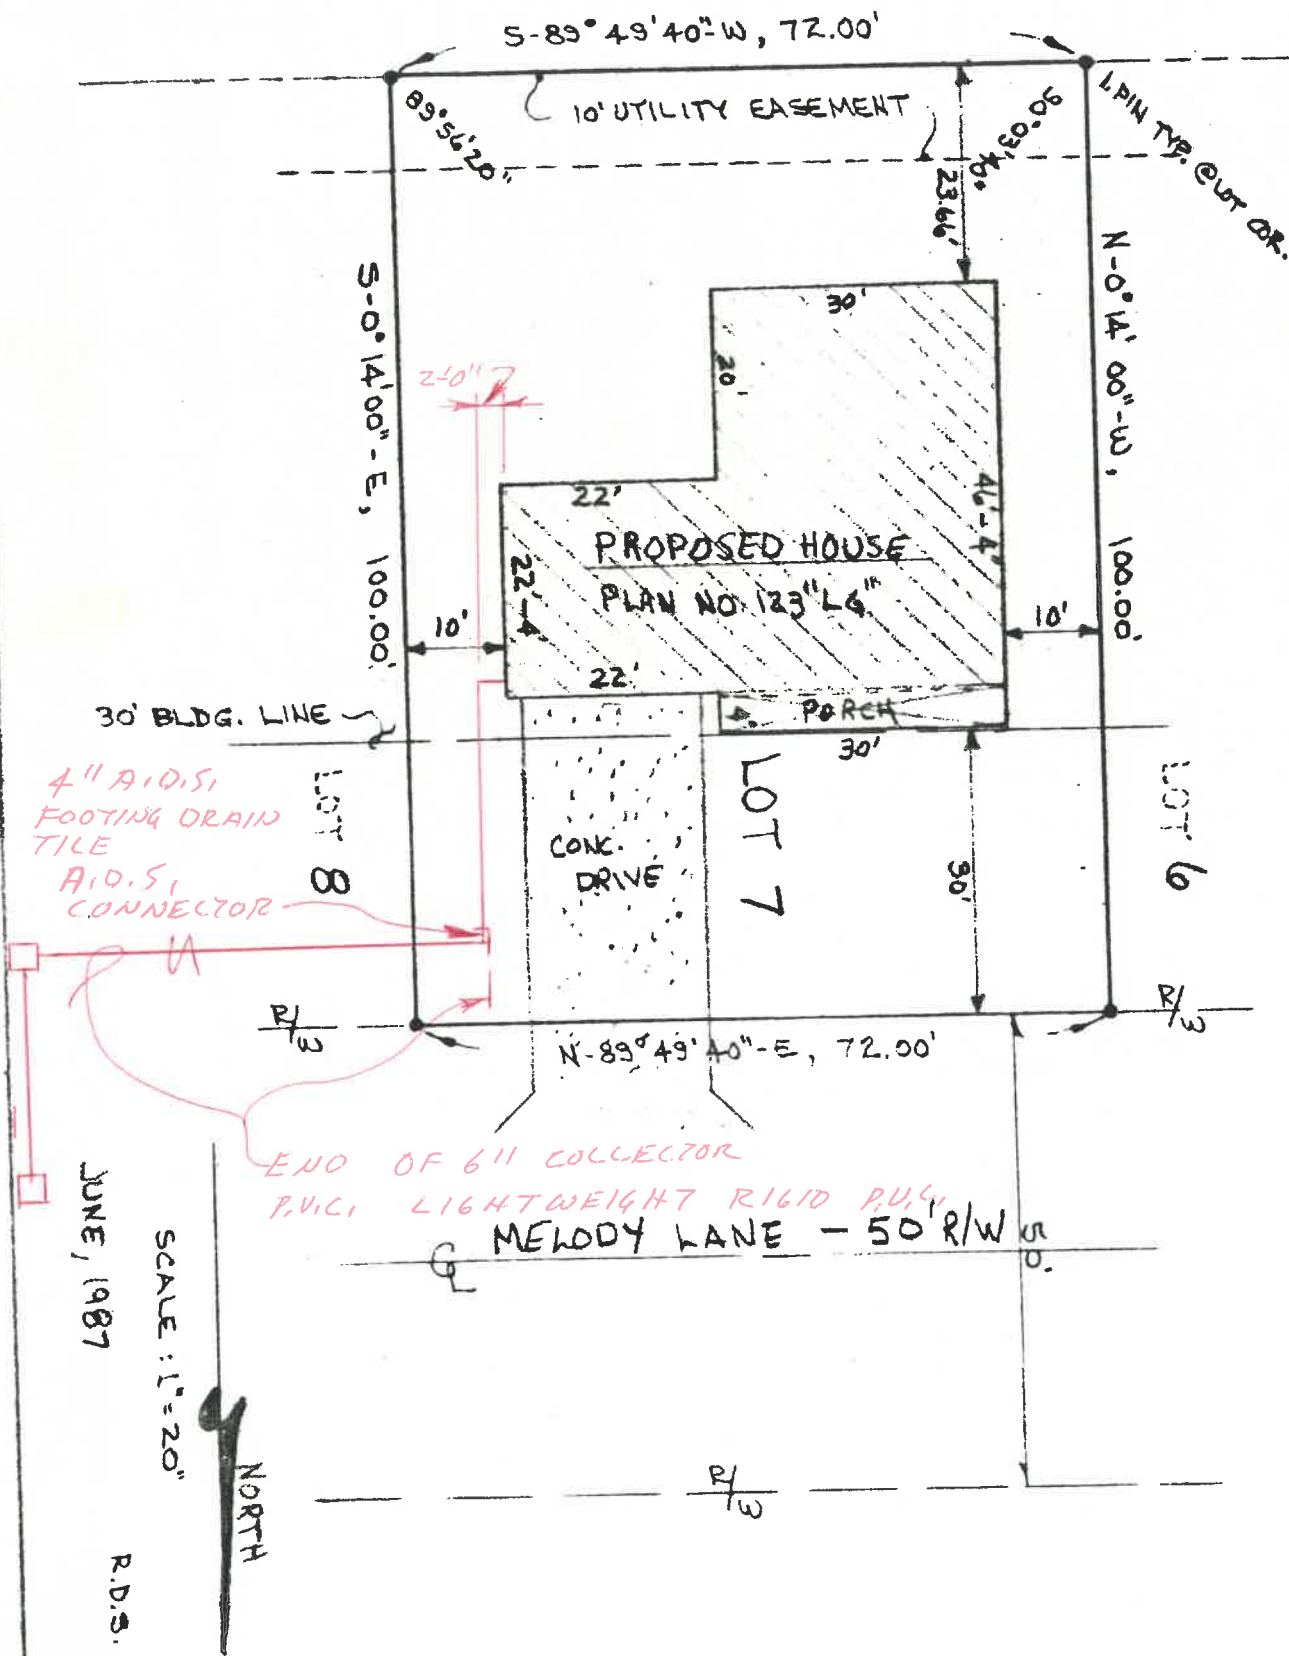

Prop kind
and electric assessment

7-24-87

Footer tile
Inspection

4" Footer
tile down
A.D.S.


2 ft

Garage

Drive

4" San Clean out

End 6" collector
P.U.C.

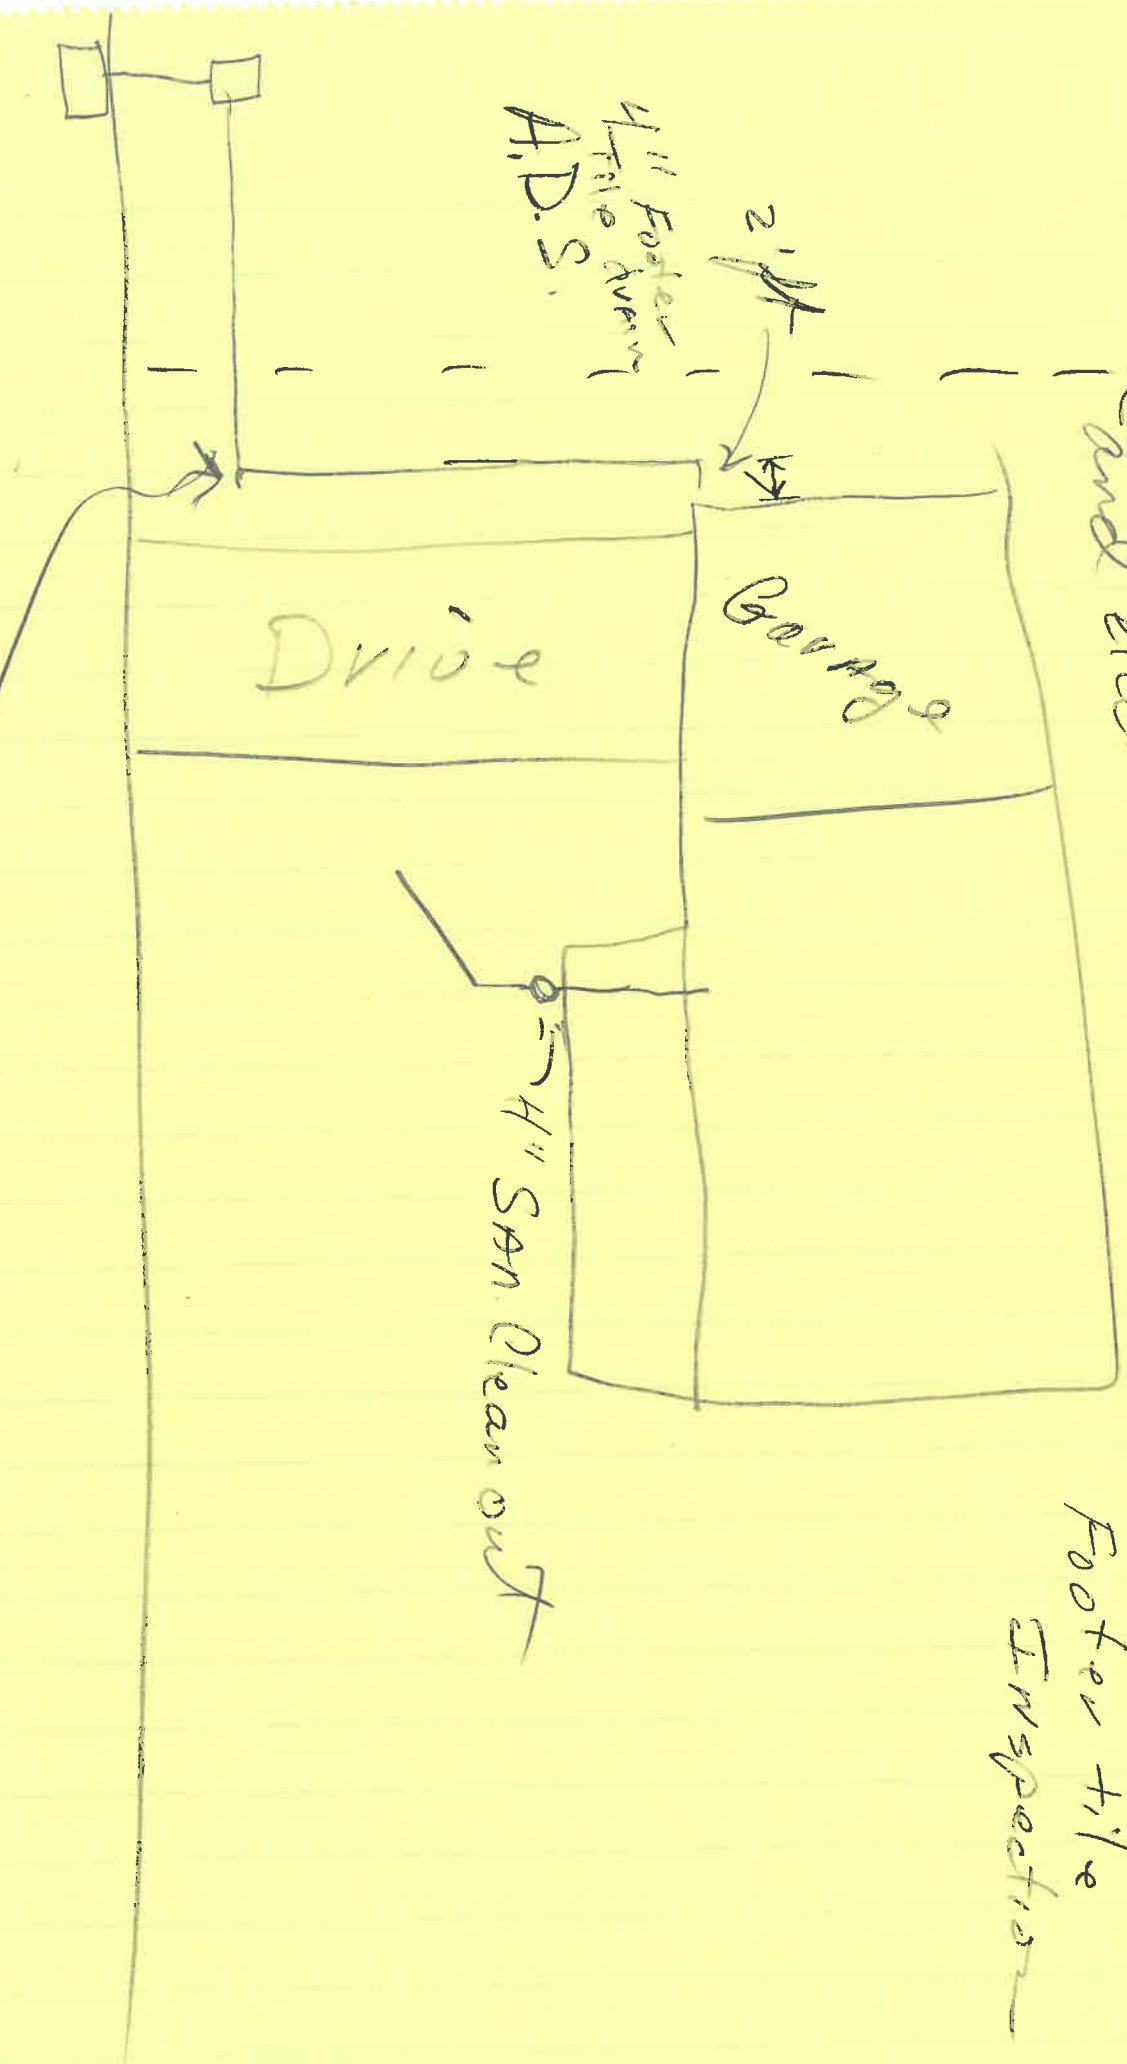

CITY OF NAPOLEON

255 W. Riverview

NAPOLEON, OHIO 43545

message

reply

to [BECK'S CONSTRUCTION
11622 RD M
NAP, OHIO]

FOLD

subject REF 925 MELODY LAKE
PERMIT NO 01398 \$787.⁰⁰

THIS PERMIT IS READY TO BE
PICKED UP.

BRING ALONG RON MEYER'S HEATING
LAYOUT WHEN YOU COME IN TO
PICK UP THE PERMIT.

date 7-24-87 signed ELOON HUBER

date _____ signed _____

SENDER: Mail white and pink copies with carbon intact.

RECEIVER: Reply, retain white copy, return pink copy.

NOTE: PERMIT NO
01359 10.⁰⁰
DEMOLITION @ 521 E. WASH
IS ALSO READY TO
BE PICKED UP