

WATER TAPPING PERMIT

issued by

The Napoleon Water Distribution Department

255 West Riverview Ave. Napoleon, Ohio 43545 Ph. 592-4010

Permit No. W- 0023 Issued 5-14-92 Received of Becks Const. (\$ 375 ) .00

(Charge for tapping permit to supply water service to) Lot No. 14 Sub Div. Brickyard Subdivision

Street No. 940 Melody Tap Size 1 " Cost \$ 375 .00 Plumber Meyers P+H


Date completed \_\_\_\_\_ Approved by \_\_\_\_\_  
water distribution dept. finance director

Name \_\_\_\_\_ Size of tap 1" Date 5-27-92 Street and No. 940 Melody

Old Tap No. \_\_\_\_\_ New Tap No. 9218 Size and Kind of Main 8" PVC

Location of Main 10' North of North Corp Depth of Main 5'

Distance from Hydrant/Valve 65' West of Hyd. 393 Distance to Curb Stop from Corp. 2'

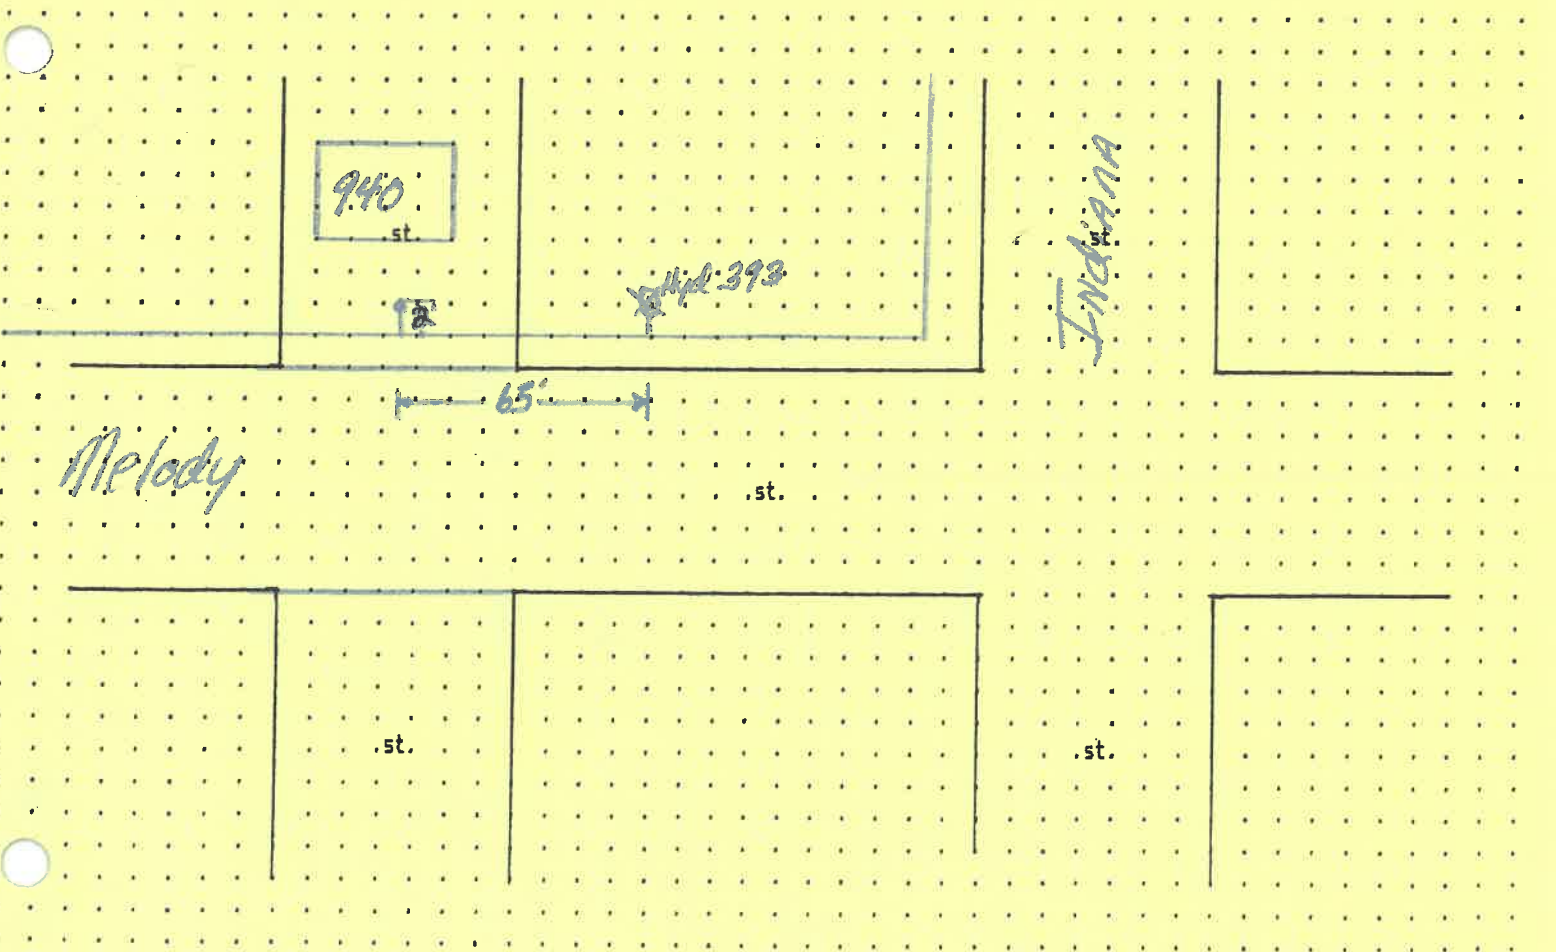

WATER TAPPING PERMIT

issued by

The Napoleon Water Distribution Department

255 West Riverview Ave. Napoleon, Ohio 43545 Pn. 592-4010

Permit No. W- 0023 Issued 5-14-92 Received of Becks Coast (\$ 375 ).00

(Charge for tapping permit to supply water service to) Lot No. 1A Sub Div. Brickyard Subdivision

Street No. 940 Melody Tap Size 1 " Cost \$ 375 .00 Plumber Meyers P+H


Date completed \_\_\_\_\_ Approved by \_\_\_\_\_  
water distribution dept. \_\_\_\_\_ finance director \_\_\_\_\_

Name \_\_\_\_\_ Size of tap 1" Date 5-27-92 Street and No. 940 Melody

Old Tap No. \_\_\_\_\_ New Tap No. 9218 Size and Kind of Main 8" PVC

Location of Main 10' North of North curb Depth of Main 5'

Distance from Hydrant/Valve 65' West of Hyd 393 Distance to Curb Stop from Corp. 2'

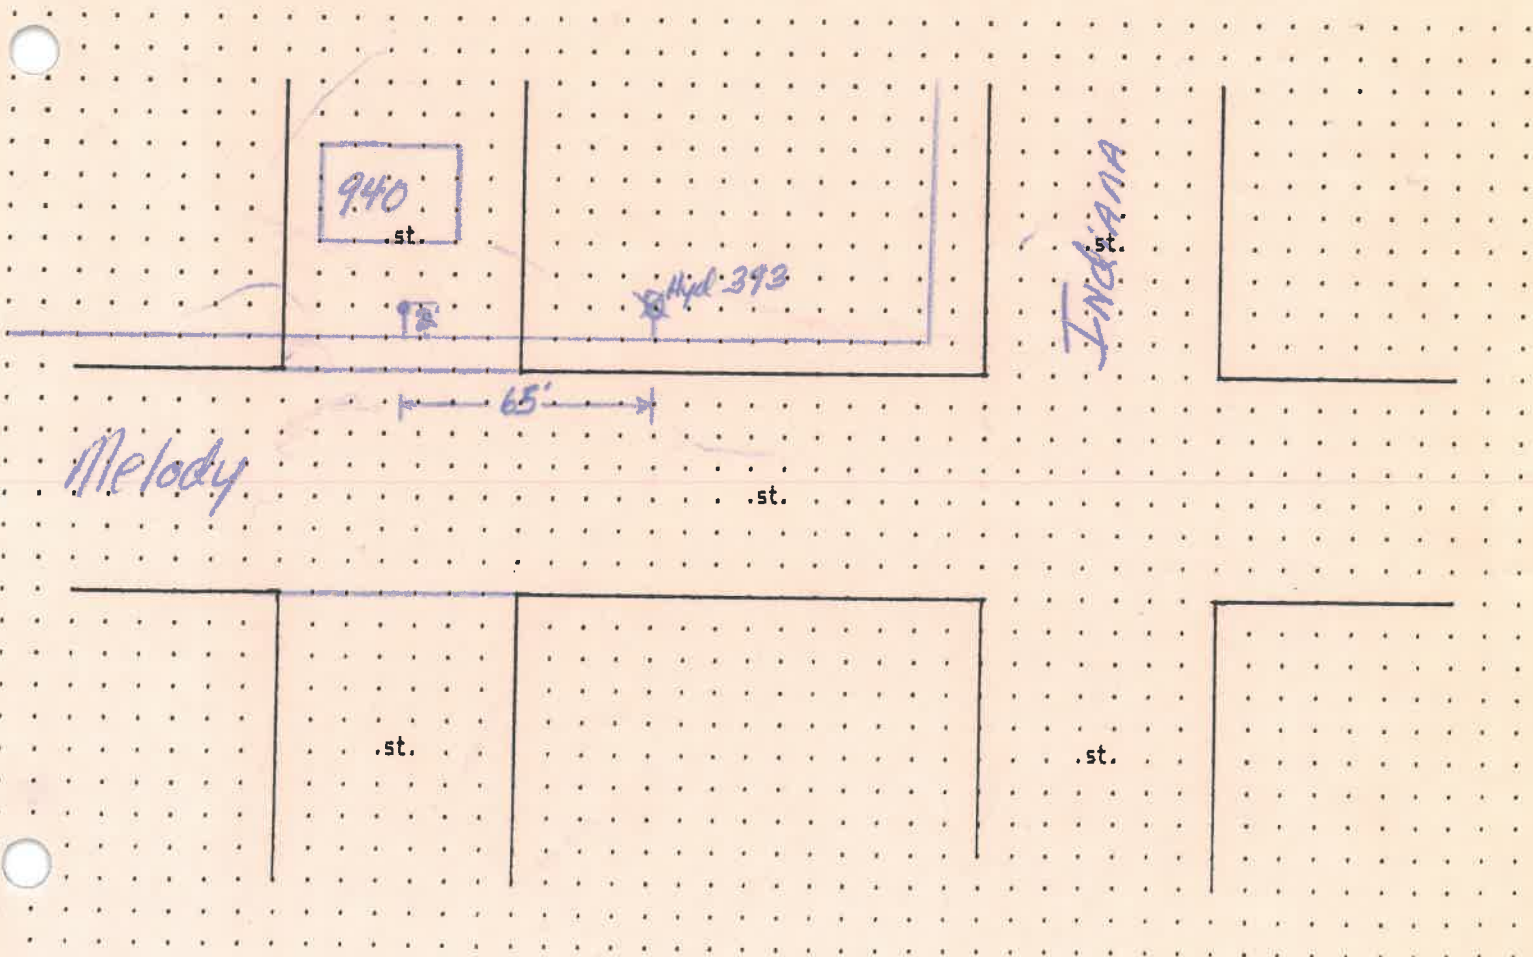

WATER TAPPING PERMIT

issued by

The Napoleon Water Distribution Department

255 West Riverview Ave. Napoleon, Ohio 43345 Pn. 592-4010

Permit No. W- 0023 issued 5-14-92 Received of Becks Const. (\$ 375 ) .00

(Charge for tapping permit to supply water service to) Lot No. 14 Sub Div. Brickyard Subdivision

Street No. 940 Melody Tap Size 1 \* Cost \$ 375 .00 Plumber Meyers P+H

Date completed \_\_\_\_\_ Approved by \_\_\_\_\_  
water distribution dept. finance director


Name \_\_\_\_\_ Size of tap \_\_\_\_\_ Date \_\_\_\_\_ Street and No. \_\_\_\_\_

Old Tap No. \_\_\_\_\_ New Tap No. \_\_\_\_\_ Size and Kind of Main \_\_\_\_\_

Location of Main \_\_\_\_\_ Depth of Main \_\_\_\_\_

Distance from Hydrant/Valve \_\_\_\_\_ Distance to Curb Stop from Corp. \_\_\_\_\_

COMPLETED

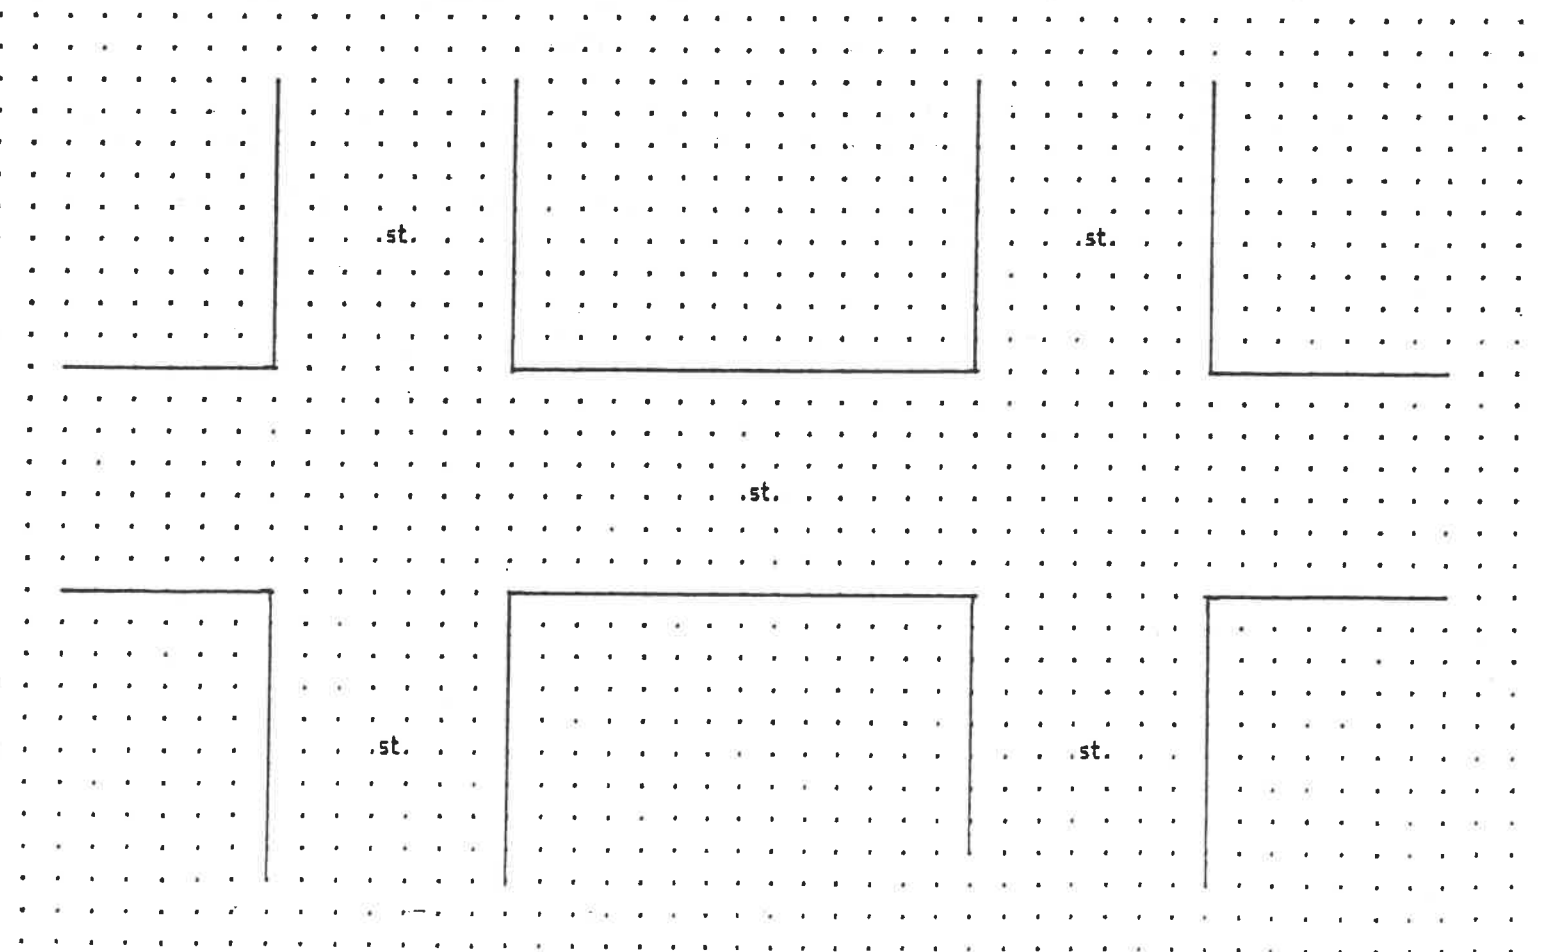

WATER TAPPING PERMIT

issued by

The Napoleon Water Distribution Department

255 West Riverview Ave. Napoleon, Ohio 43545 Ph. 592-4010

Permit No. W- 0023 Issued 5-14-92 Received of Beck's Const. (\$ 375 ) .00

(Charge for tapping permit to supply water service to) Lot No. 14 Sub Div. Brickyard Subdivision

Street No. 940 Melody Tap Size 1 Cost \$ 375 .00 Plumber Meyers P+H

Date completed \_\_\_\_\_ Approved by \_\_\_\_\_ water distribution dept. \_\_\_\_\_ finance director

Name \_\_\_\_\_ Size of tap \_\_\_\_\_ Date \_\_\_\_\_ Street and No. \_\_\_\_\_

Old Tap No. \_\_\_\_\_ New Tap No. \_\_\_\_\_ Size and Kind of Main \_\_\_\_\_

Location of Main \_\_\_\_\_ Depth of Main \_\_\_\_\_

Distance from Hydrant/Valve \_\_\_\_\_ Distance to Curb Stop from Corp. \_\_\_\_\_

COMPLETED

.st.

.st.

METER SOCKET RELEASE

issued by

The Napoleon Electric Distribution Department

639 Industrial Drive Napoleon, Ohio 43545 Pn. 592-9116 or 592-4010

Permit No. E-0067 Issued 5-14-92 Building permit No. 2636 Job Address 940 Melody  
 Lot Number 14 Sub Division Brickyard Subdivision  
 Owner Becks Const. Owners Address 11-622 Co. Rd. m Napoleon No. 592-8307  
 Contractor Same Contractors Address Pn. No.  
 Size of Service 200 Overhead Underground X Issued By Brent N. Dammann

Date completed Approved by electric distribution dept.  
 Size of Service Overhead Underground Street and No.  
 Old Meter No. New Meter No. Remarks

COMPLETED

Sketch of Service

