

214 2126

TAPPING PERMIT

Office of
Water Works
Napoleon, Ohio

No. W-514-88 Date 5-7-88

Received of SEK'S CONSTRUCTION
THREE HUNDRED Dollars 25

Charge for tapping permit to supply water services to Lot No. 7

Addition BECKYARD 305 DIV.

Street No. 970 MCELROY CN.

Tap Size 1 Inch Cost 300

Plumber ALBERT POLYMER

Clerk-Treasurer

Date completed 5-24-88 Serial # 8810

Bill Schmitz, Supt
Water Distribution Department

APPLICATION FOR PERMIT TO TAP SEWER

Owner DON WESTHOVEN
ADDRESS 125 W. WASHINGTON
CONTRACTOR BECK'S CONSTRUCTION
ADDRESS 11622 RD M TEL. 592-8307

NO. S.A. 0048-88
BLDG. PERMIT 01526
PERMIT FEE \$ 60.⁰⁰
INSPECTION
STREET BOND NONE
DATE PAID 4-7-88
For office use only

LOCATION OF CONNECTION

Street and No. 970 MELODY LN Sanitary Storm
Lot No. 17 Subdivision BRICKYARD SUBDIV Size of Tap 4"
Size and Type of Sewer 5.0 I.R. 35 P.V.C. ALL WORK MUST BE INSPECTED
Street to be opened-Yes No Opening bond fee set by Engineer \$ 1000R
Street opening agreement approval date _____

I certify that the sewer will be used only as indicated and no other drainage will be connected.

Date 4/19/88 Signature Robert L Beck
Owner-Builder-Agent

DO NOT WRITE BELOW THIS LINE

INSPECTION RECORD


Date Inspected 4-21-88 Size and Type of Sewer 4" 5.0 I.R. 35
Location SEE SITE PLAN Depth SEE PLAN Type of Test NONE
Inspected and Approved by: Malcolm Helberg 4-21-88
Inspector Date

Additional information _____

Send copy to: _____

SKETCH OF INSTALLATION - ON BACK

SITE PLAN FOR
BECKS CONSTRUCTION CO.
 LOT NO. 17, PHASE I BRICKYARD SUB-DIVISION, CITY OF NAPOLEON, HENRY CO. OHIO.

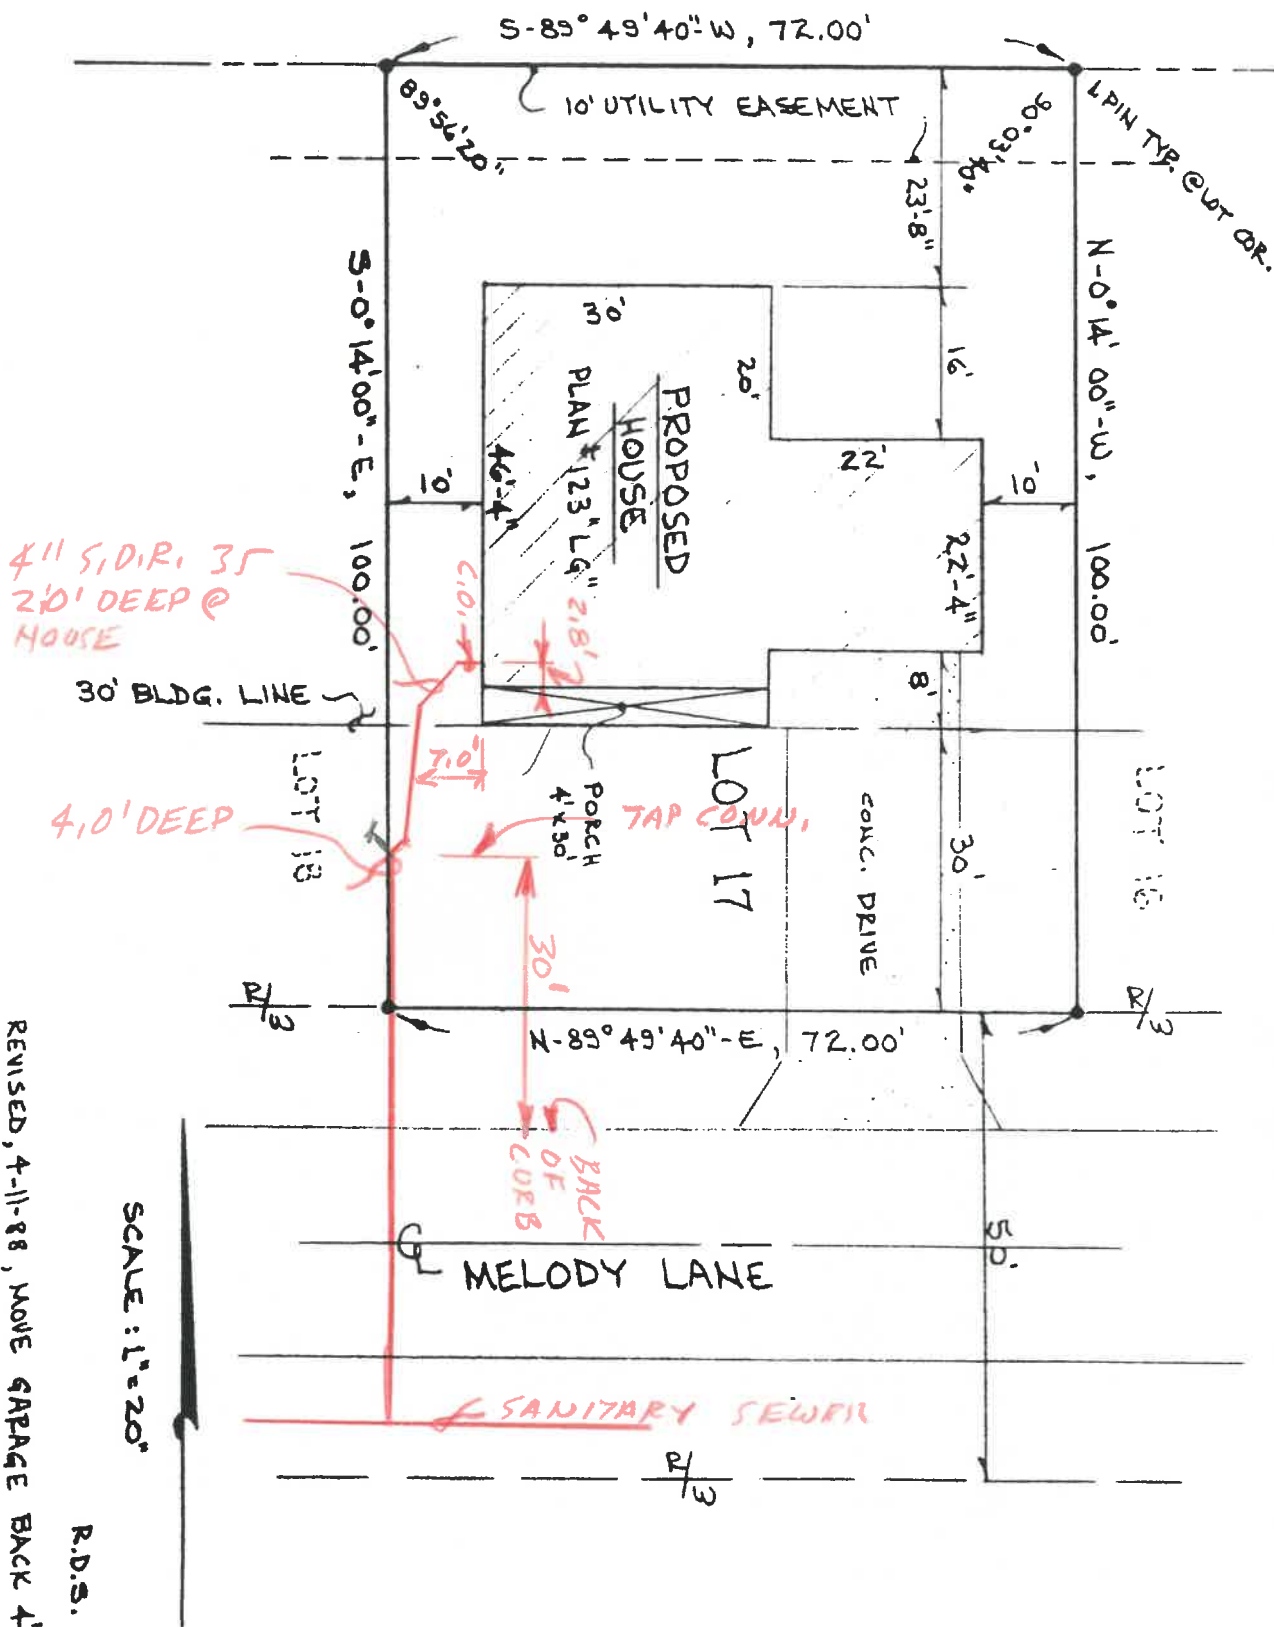

REVISED, 4-11-88, MOVE GARAGE BACK 4', R.D.S.


SCALE: 1"=20'

R.D.S.

SITE PLAN FOR
BECKS CONSTRUCTION CO.

LOT NO. 17, PHASE I BRICKYARD SUB-DIVISION, CITY OF NAPOLEON, HENRY CO. OHIO.

970 Me/Hely

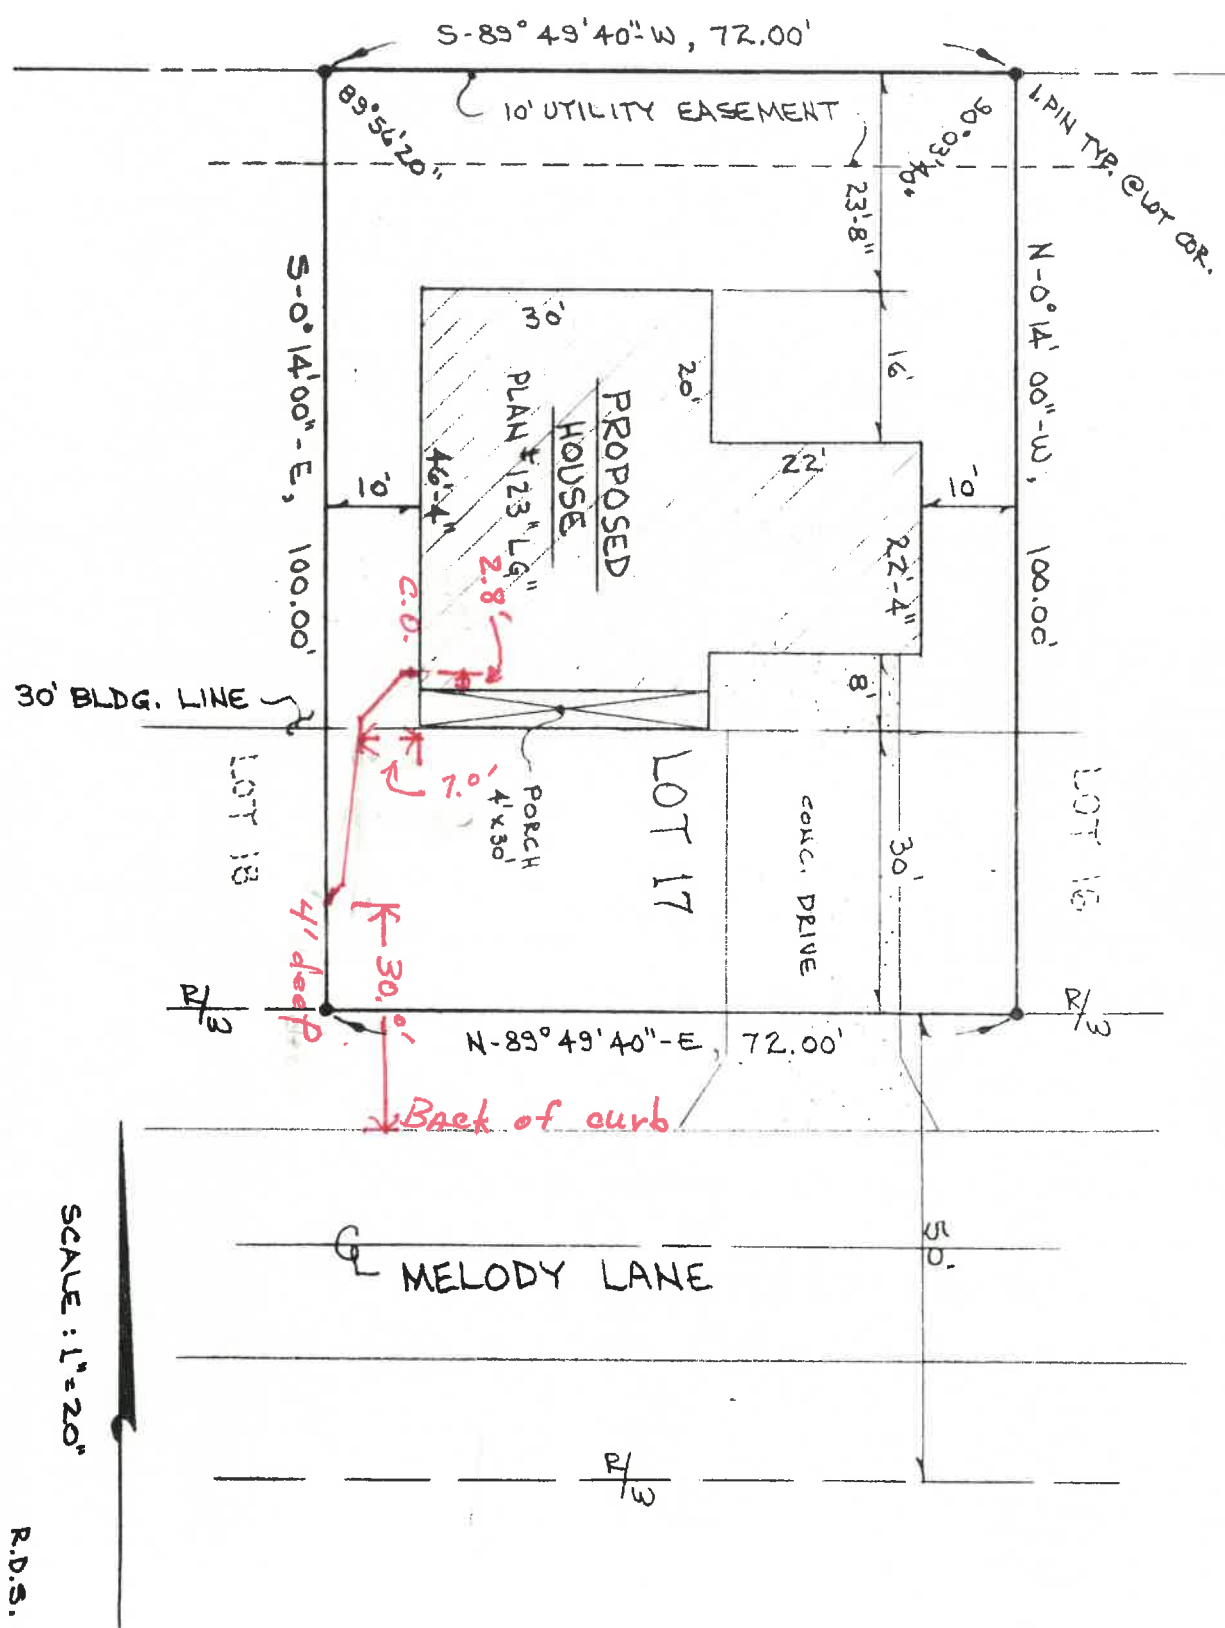

SCALE: $1''=20'$

R.D.S.

REVISED, 4-11-88, MOVE GARAGE BACK 4', R.D.S.

Field Copy