


Avenue

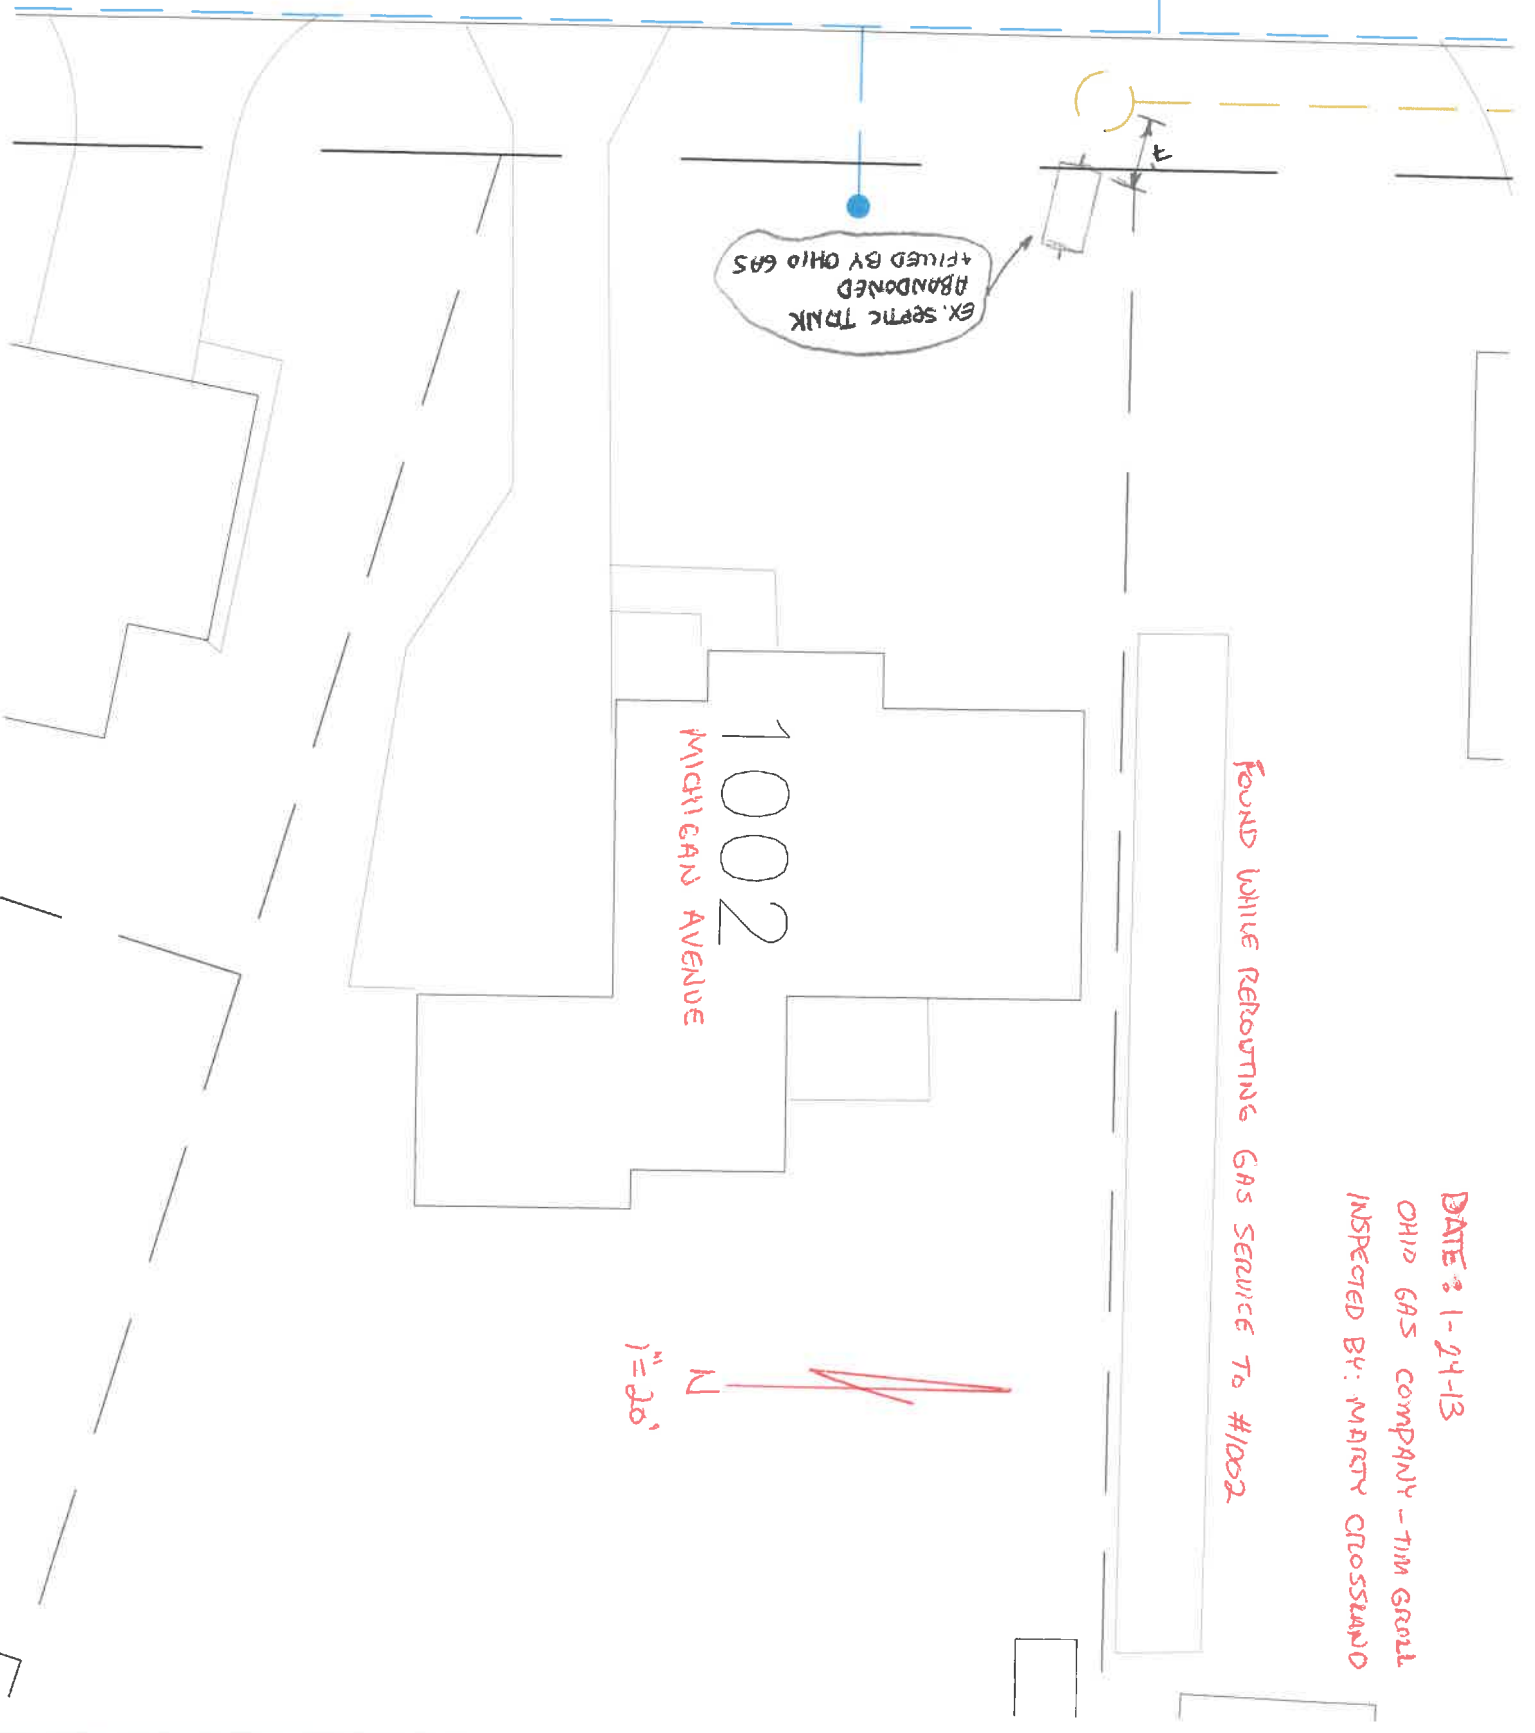

EX. SEPTIC TANK
ABANDONED BY OHIO GAS

1002
MICHIGAN AVENUE

FOUND WHILE REROUTING GAS SERVICE TO #1002

DATE: 1-24-13
OHIO GAS COMPANY - TIM GRILL
INSPECTED BY: MASTRUCROSSLAND

N
1" = 20'