

SEWER TAPPING PERMIT

Issued by

The City of Napoleon Engineering Dept.

255 West Riverview Ave. Napoleon, Ohio 43545 Pn. 592-4010

Entry No. \_\_\_\_\_

Permit No. \_\_\_\_\_ Issued 5-19-92 Build. Permit No. \_\_\_\_\_

Permit Fee \$ 35.00

Job Location OWEN SCHLOSSER

Street Bond \$ \_\_\_\_\_

Lot 1127 MICHIGAN  
sub div. or legal disc.

Date Paid 5/19/92

Issued By \_\_\_\_\_

Owner \_\_\_\_\_ Pn. \_\_\_\_\_

Address \_\_\_\_\_

Agent \_\_\_\_\_ Pn. \_\_\_\_\_

Address \_\_\_\_\_

for office use only

WORK INFORMATION

Sanitary Sewer Tap  \_\_\_\_\_ Size of Tap \_\_\_\_\_ Size and Type of Sewer 4" PVC Street to be Opened  \_\_\_\_\_  
yes no

Storm Sewer Tap \_\_\_\_\_ Size of Tap \_\_\_\_\_ Size and Type of Sewer \_\_\_\_\_ Street to be Opened  \_\_\_\_\_  
yes no

Street opening Agreement Approval Date \_\_\_\_\_ Opening Bond Fee (Set by Engineer) \_\_\_\_\_

READ AND SIGN BELOW; The undersigned hereby agrees complete the work described above and to make use of said sewers only as allowed by and in strict accordance with all applicable provisions of The Napoleon Engineering Dept. Rules and Regulations, The Napoleon Standard Specification for Water Main, Sanitary Sewer and Storm Sewer Construction and other Pertinent Sections of the Napoleon Code of Ordinances.

Date May 18, 1992 Signature of Applicant [Signature]  
Permit not valid without signature

INSPECTION RECORD \_\_\_\_\_ to be completed by the Field Inspector

Date Inspection is made \_\_\_\_\_ Size and Type of Sewer \_\_\_\_\_

Location \_\_\_\_\_ Depth \_\_\_\_\_ Type of Test \_\_\_\_\_ Additional Information \_\_\_\_\_

Date \_\_\_\_\_ Inspected By \_\_\_\_\_  
signature of inspector

Sketch Of Installation on Back or Attached

May 19th, 1992

125 Vincennes James Etall  
mossing pools  
Bonding inspection  
continuous.


Legal

5/19/92

Mort Cordes

Owen Schlosser

1127 Michigan Ave.

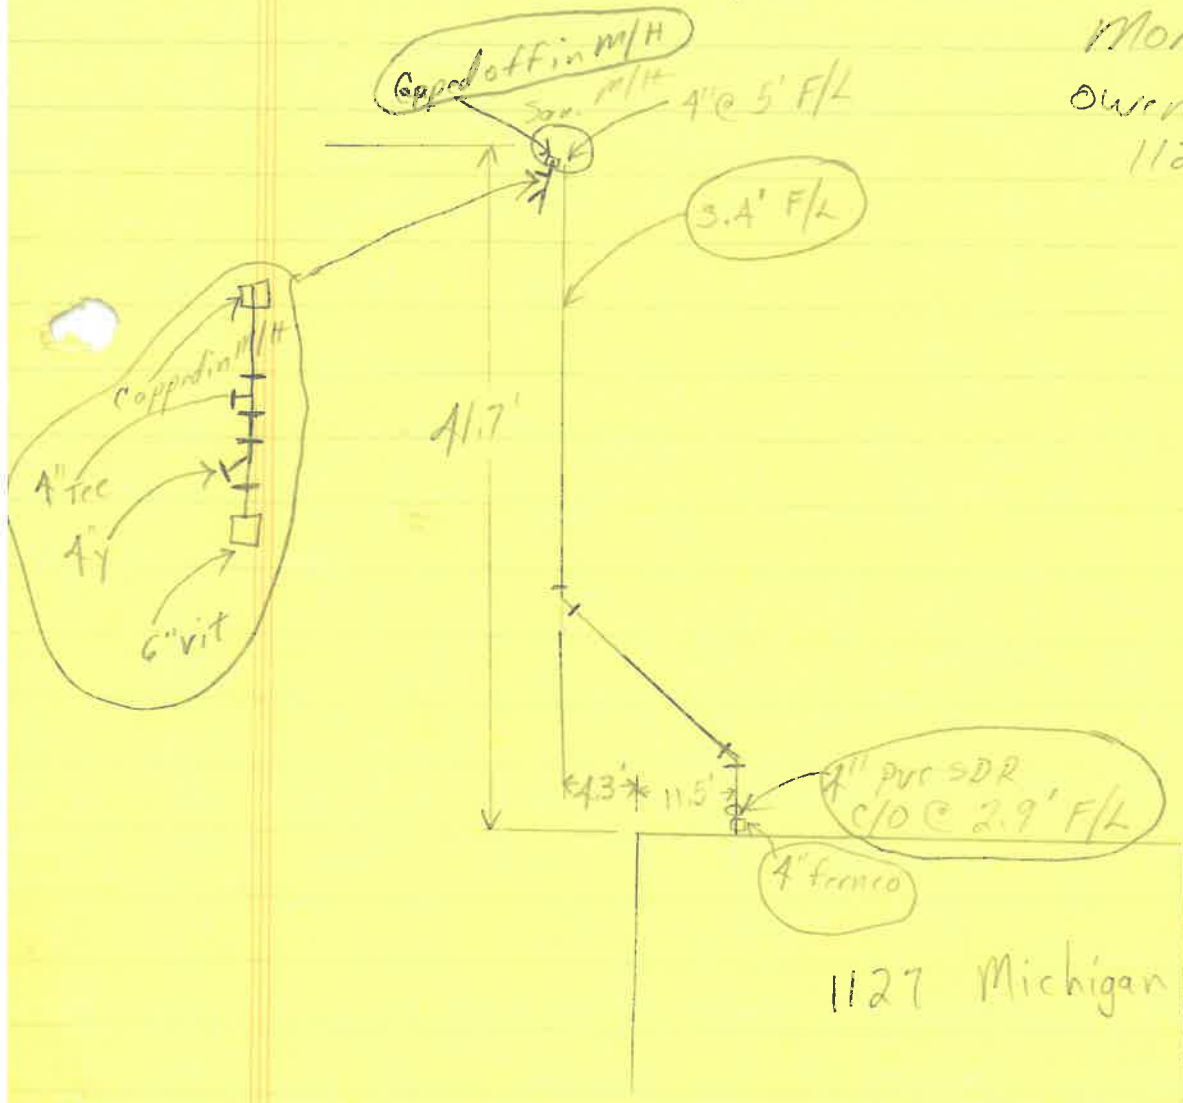

Michigan Ave.