

PERMIT

CITY OF NAPOLEON - BUILDING DEPARTMENT
 255 West Riverview Avenue, Napoleon, Ohio 43545 - 419-592-4010

Permit No. 01712 Issued 3-31-89
date

Job Location 504 Monroe
address

Lot 28 E-Pt. Original Plat
sub-div or legal discript

Issued By Eldon Huber
building official

Owner Lillian Mizer
name tel.

Address 504 Monroe

Mort Cordes
builder-eng.-etc. tel.

Address RR 4

Description of Use Residence

Residential 1
no. dwelling units

Commercial _____ Industrial _____

New _____ Add'n. _____ Alter _____ Remodel X

Mixed Occupancy _____

Change of Occupancy _____

Estimated Cost \$ 1,800.00

MIRAC

FEE	BASE	PLUS	TOTAL
<input type="checkbox"/> BUILDING			
<input type="checkbox"/> ELECTRICAL			
<input checked="" type="checkbox"/> PLUMBING	9.00	3.00	12.00
<input type="checkbox"/> MECHANICAL			
<input type="checkbox"/> DEMOLITION			
<input type="checkbox"/> ZONING			
<input type="checkbox"/> SIGN			
WATER TAP			
SEWER TAP			
TEMP. ELECT.			
ADDITIONAL PLAN REVIEW	Struct. _____ hrs	Elect. _____ hrs	
TOTAL FEES.....			12.00
LESS MIN. FEES PAID			
BALANCE DUE.....			

ZONING INFORMATION N.A.

district GB	lot dimensions	area	front yd	side yds	rear yd
max hgt	no pkg spaces	no ldg spaces	max cover	petition or appeal req'd	date appr

WORK INFORMATION: N.A.

Size: Length _____ Width _____ Stories _____ Ground Floor Area _____

Height _____ Building Volume (for demo. permit) _____ cu. ft.

Electrical: NA
brief description

Plumbing: Replace washer drain.
brief description

Mechanical: N.A.
brief description

Sign: _____ Dimensions _____ Sign Area _____
type

Additional Information: _____

PAID

Date _____ Applicant Signature _____ owner-agent **MAR 31 1989**

INSPECTION RECORD

	UNDERGROUND			ROUGH-IN						FINAL		
	Type	Date	By	Type	Date	By	Type	Date	By	Type	Date	By
PLUMBING	Building Drains			Drainage, Waste & Vent Piping			Indirect Waste			Drainage, Waste & Vent Piping		
	Water Piping									Backflow Prevention		
	Building Sewer			Water Piping			Condensate Lines			Water Heater		
	Sewer Connection									FINAL APPROVAL		
MECHANICAL	Refrigerant Piping			Refrigerant Piping			Chimney(s)			Grease Exhaust System		
				Duct Furnace(s)			Fire Dampers			Air Cond. Unit(s)		
	Ducts/Plenums			Ducts/Plenums			<input type="checkbox"/> Radiant Htr(s) <input type="checkbox"/> Unit Htr(s)			Refrigeration Equipment		
				Duct Insulation			Pool Heater			Furnace(s)		
				Combustion Products Vents			Ventilation <input type="checkbox"/> Supply <input type="checkbox"/> Exhst.			FINAL APPROVAL		
ELECTRICAL	Conduits & or Cable			Conduits/Cable			<input type="checkbox"/> Range <input type="checkbox"/> Dryer			Temp Service Temp Lighting		
	Grounding & or Bonding			Rough Wiring			<input type="checkbox"/> Generator(s) <input type="checkbox"/> Motors			Fixtures Lampholders		
	Floor Ducts Raceways			Service Panel Switchboard			<input type="checkbox"/> Water Htr <input type="checkbox"/> Welder			Signs		
	Service Conduit			Busways Ducts			<input type="checkbox"/> Heaters <input type="checkbox"/> Heat Cable			Electric Mtr. Clearance		
	Temporary Power Pole			Subpanels			<input type="checkbox"/> Duct Htr(s) <input type="checkbox"/> Furnace(s)			FINAL APPROVAL		
BUILDING	Location, Set-backs, Esmt(s)			Exterior Wall Construction			Roof Covering Roof Drainage			Smoke Detector		
	Excavation						Exterior Lath			Demolition (sewer cap)		
	Footings & Reinforcing						<input type="checkbox"/> Interior Lath <input type="checkbox"/> Wallboard					
	Floor Slab			Interior Wall Construction			Fire Wall(s)			Building or Structure		
	Foundation Walls			Columns & Supports			Fireplace Chimney					
	Sub-soil Drain			Crawl Space <input type="checkbox"/> Vent <input type="checkbox"/> Access			Attic <input type="checkbox"/> Vent <input type="checkbox"/> Access					
	Piles			Floor System(s)						FINAL APPROVAL BLDG. DEPT.	4/3	EM
			Roof System			Special Insp Reports Rec'd			Certificate of Occupancy Issued			
ADDITIONAL	INSPECTIONS, CORRECTIONS, ETC.						INSPECTIONS, CORRECTIONS, ETC.					

PERMIT

CITY OF NAPOLEON - BUILDING DEPARTMENT

01712 255 West Riverview Avenue, Napoleon, Ohio 43545 - 419-592-4010

Permit No. Issued 3-31-89
date

Job Location 504 MADROR
address

Lot 28 E-PT. ORIGINAL PCAT
sub-div or legal descripr

Issued By FH
building official

Owner LILLIAN MIZEN
name tel

Address 504 MADROR

Agent MORT CORDES
builder-eng etc. tel

Address R R 4

Description of Use RESIDENCED

Residential 1 no dwelling units

Commercial Industrial

New Add'n. Alter Remodel X

Mixed Occupancy

Change of Occupancy

Estimated Cost \$ 1800.00

FEE	BASE	PLUS	TOTAL
BUILDING			
ELECTRICAL			
PLUMBING	9.00	3.00	12.00
MECHANICAL			
DEMOLITION			
ZONING			
SIGN			
WATER TAP			
SEWER TAP			
TEMP. ELECT.			
ADDITIONAL PLAN REVIEW	Struct. <u> </u> hrs	Elect. <u> </u> hrs	
TOTAL FEES.....			12.00
LESS MIN. FEES PAID <u> </u>			
BALANCE DUE.....			

ZONING INFORMATION NA

district	lot dimensions	area	front yd	side yds	rear yd
<u>GD</u>					
max hgt	no pkg spaces	no ldg spaces	max cover	petition or appeal req'd	date appr

WORK INFORMATION: NA

Size: Length Width Stories Ground Floor Area

Height Building Volume (for demo. permit) cu. ft.

Electrical: N.A.

Plumbing: REPLACE WASHER DRAW
brief description

Mechanical: N.A.
brief description

Sign: Dimensions Sign Area
type

Additional Information:

Date Applicant Signature owner-agent

BUILDING INSPECTION DEPARTMENT
APPLICATION FOR PLUMBING PERMIT
(Please print or type)

The undersigned hereby makes application for the installation or replacement of plumbing work as herein specified, agreeing to do all such work in strict accordance with the City of Napoleon's adopted Plumbing Codes. (1, 2 and 3 family dwelling units only).

Owner's Name LILLIAN MIZER Address 504 MOUROE

Plumbing Contractor MORT CORDES Telephone No. 599-3777

Address ~~504 MOUROE~~ 224 NAP OH

General Contractor _____ telephone no. _____

Address _____

Location of Project 504 MOUROE Cost of Project _____

Work Information:

No. of dwelling units _____ New _____ Replacement Addition _____

Brief description of work: INSTALL NEW WASHDR DRAIN
TO REPLACE OLD ONE RUN INTO DOWNSPOUT DRAIN

Is water tap required NO Size _____ Type of Pipe _____

Is sewer tap required ~~NO~~ YES Size 4 Type of Pipe 4" S.D.R. 35

Type of Water Distribution pipe _____

Type of Drainage, Waste and Vent Pipe SCH 40 P.V.C.

Size of main building drain _____ Size of main vent pipe _____

Water closets _____ Bathtubs _____ Shower _____
No. Trap Size No. Trap Size

lavatories _____ Kitchen Sink _____ Disposal _____
No. Trap Size No. Trap Size No. Trap Size

Dishwasher _____ Clothes Washer 1 1 1/2" Other _____
No. Trap Size No. Trap Size No. Trap Size

All installations are subject to plumbing tests and/or inspections.

Date _____ Applicant's Signature _____

PERMIT NO. _____
PERMIT FEE \$ _____

APPLICATION FOR PERMIT TO TAP SEWER

Owner Vito Mizer
ADDRESS 504 MONROE
CONTRACTOR MORT CORDES
ADDRESS RP# 4 TEL. 758-3855

NO. S.A. 0093-89
BLDG. PERMIT 01712
PERMIT FEE \$ 60.⁰⁰
STREET BOND 1.⁰⁰
DATE PAID 3-31-89

For office use only

LOCATION OF CONNECTION

Street and No. 504 MONROE Sanitary _____ Storm _____
Lot No. _____ Subdivision _____ Size of Tap _____
Size and Type of Sewer 4" POC ALL WORK MUST BE INSPECTED
Street to be opened-Yes _____ No X Opening bond fee set by Engineer \$ _____
Street opening agreement approval date _____

I certify that the sewer will be used only as indicated and no other drainage will be connected.

Date March 29/89 Signature [Signature]
Owner-Builder-Agent

DO NOT WRITE BELOW THIS LINE


INSPECTION RECORD

Date Inspected _____ Size and Type of Sewer _____
Location _____ Depth _____ Type of Test _____
Inspected and Approved by: _____
Inspector _____ Date _____

Additional information _____


Send copy to: _____


SKETCH OF INSTALLATION - ON BACK

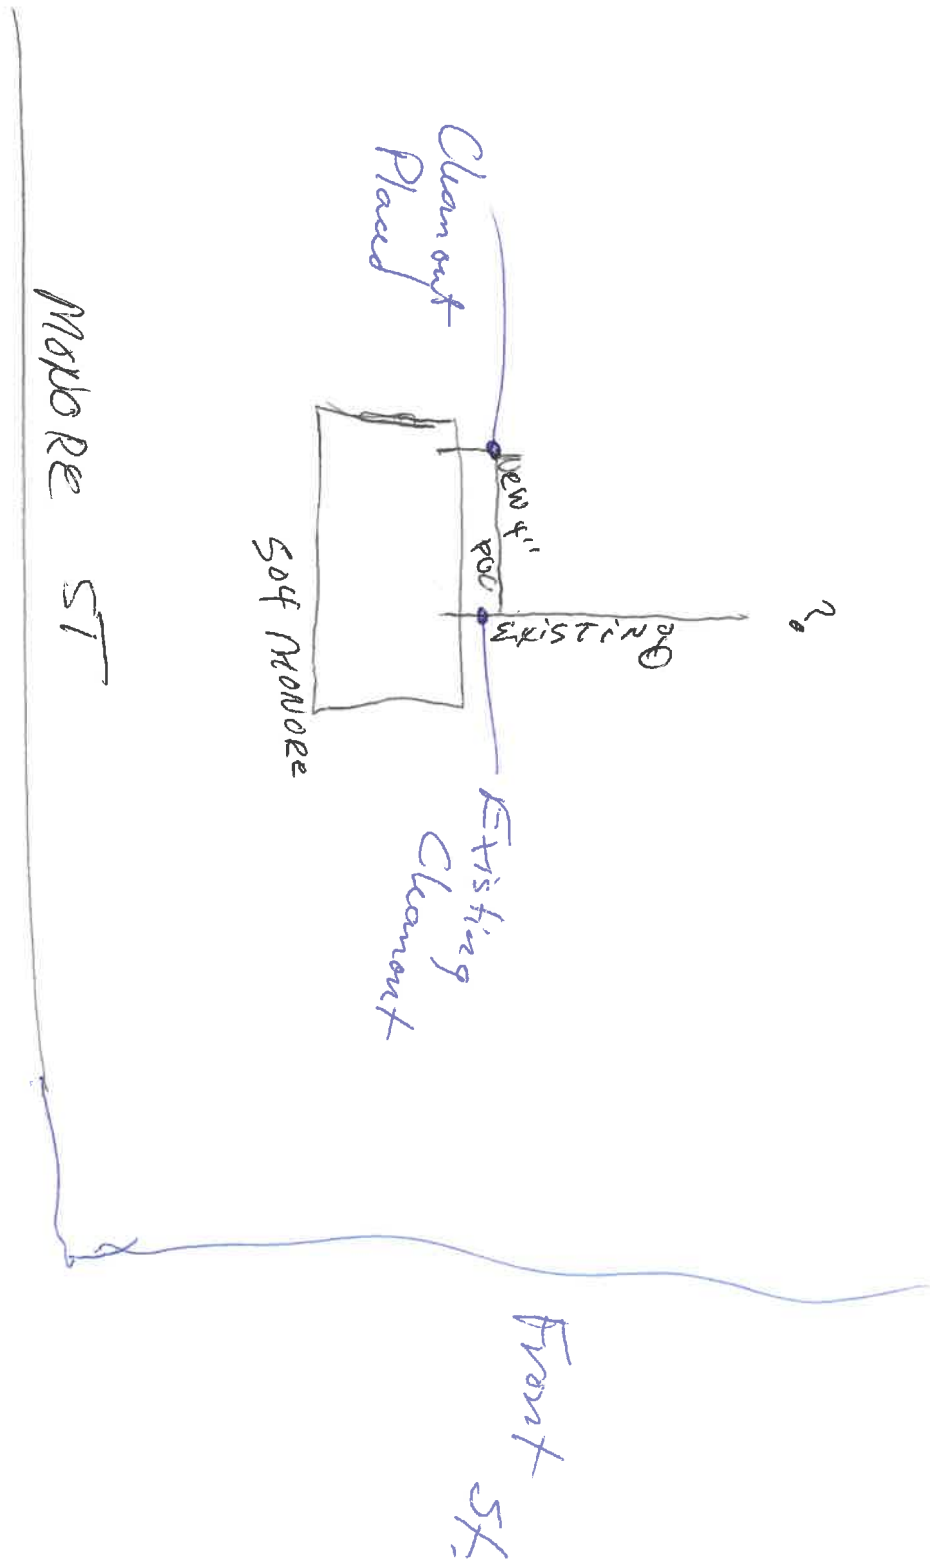

CITY OF NAPOLEON
ENGINEERING DEPT.
255 W RIVERVIEW
NAPOLEON, OH 43545

JOB 509 MONROE ST
SHEET NO S.T. # SA0093-89 OF _____
CALCULATED BY 51 DATE 7-31-89
CHECKED BY _____ DATE _____
SCALE _____

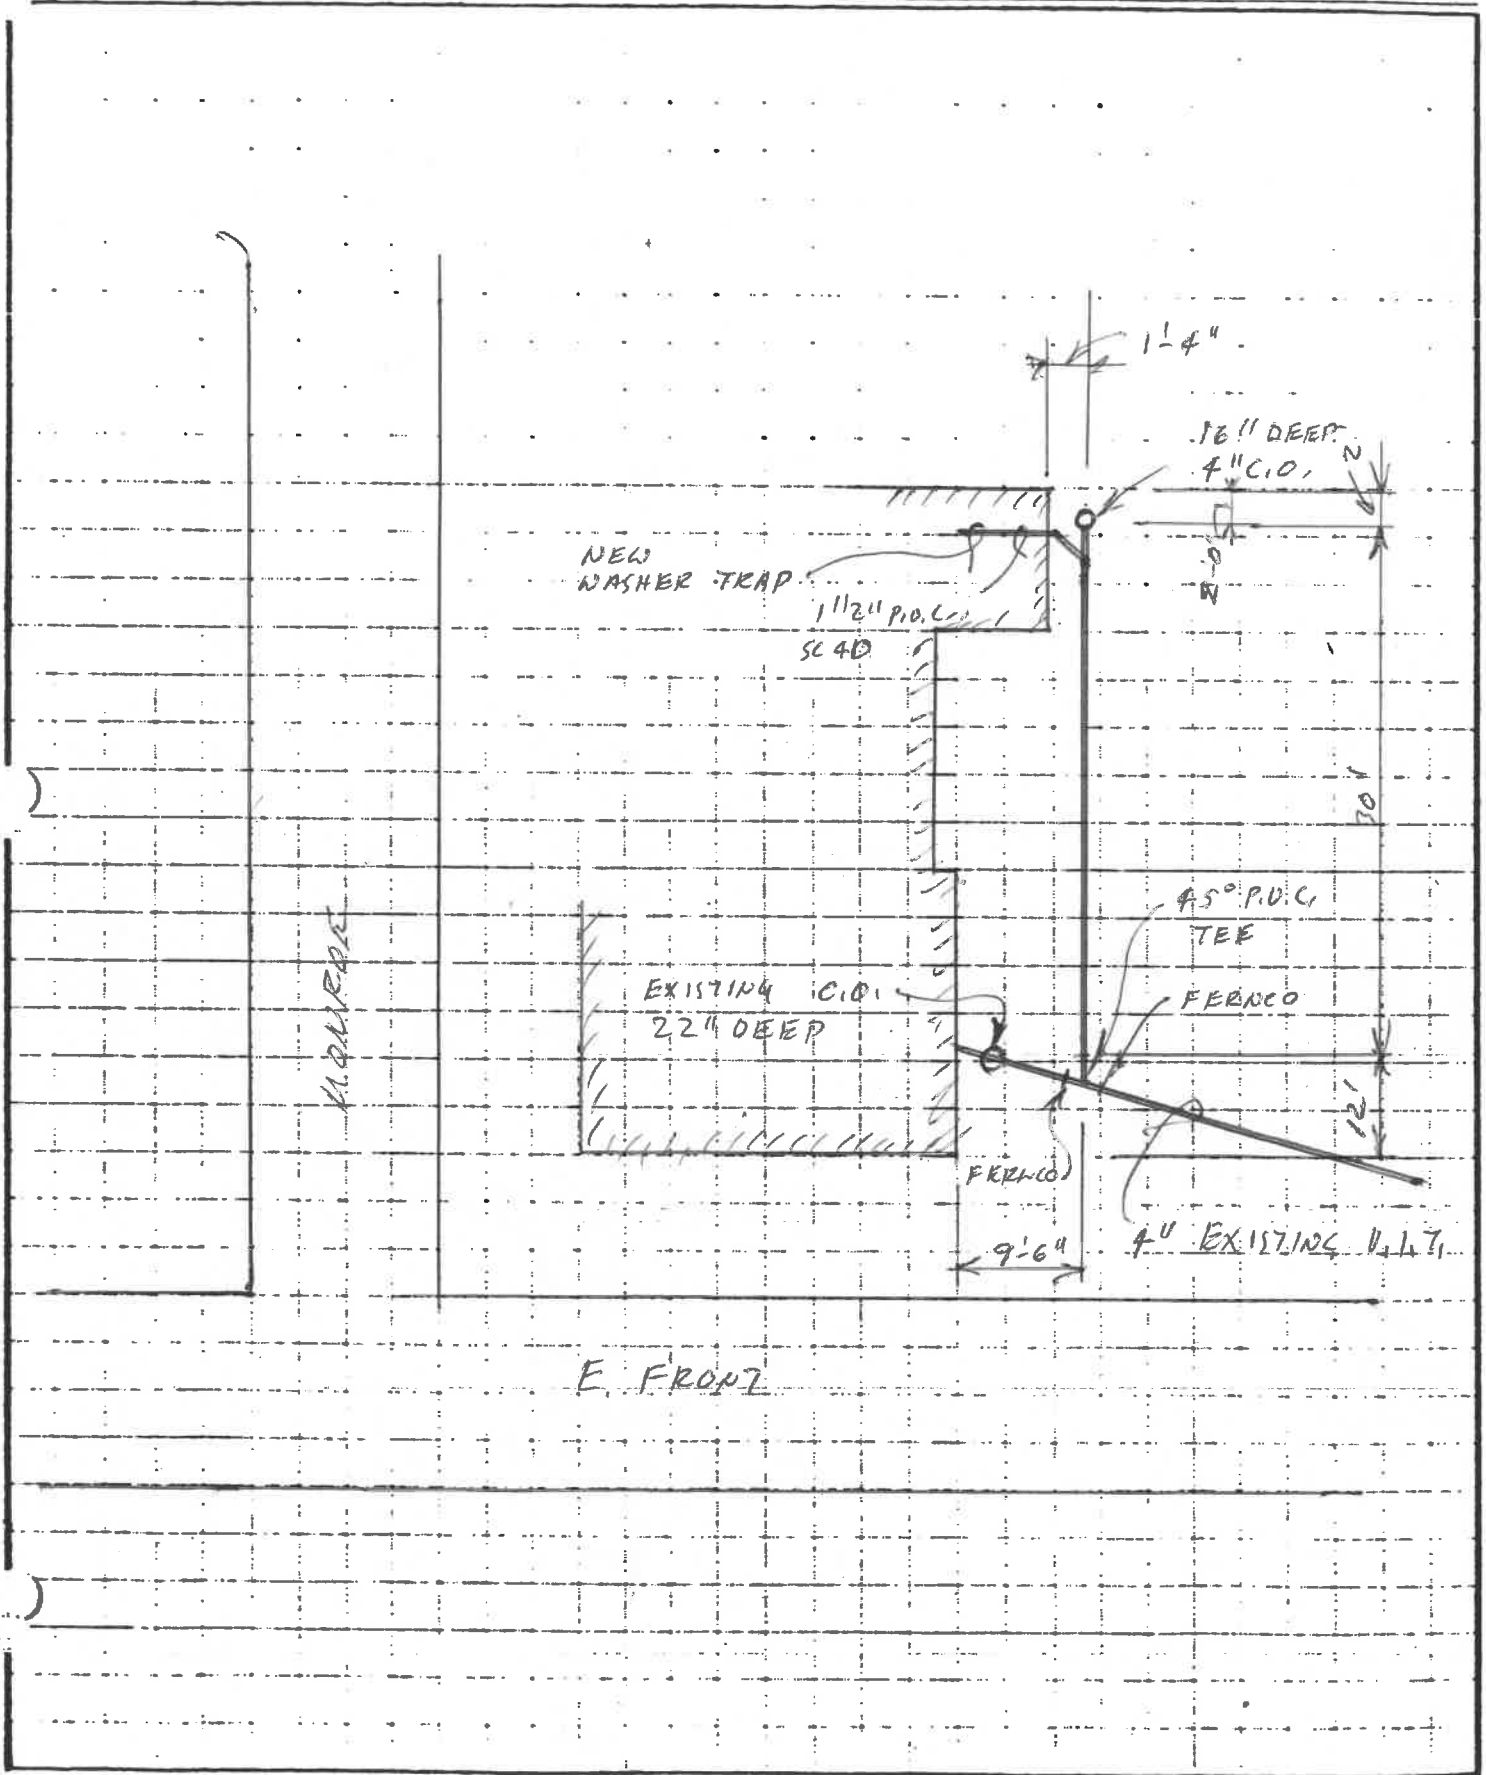

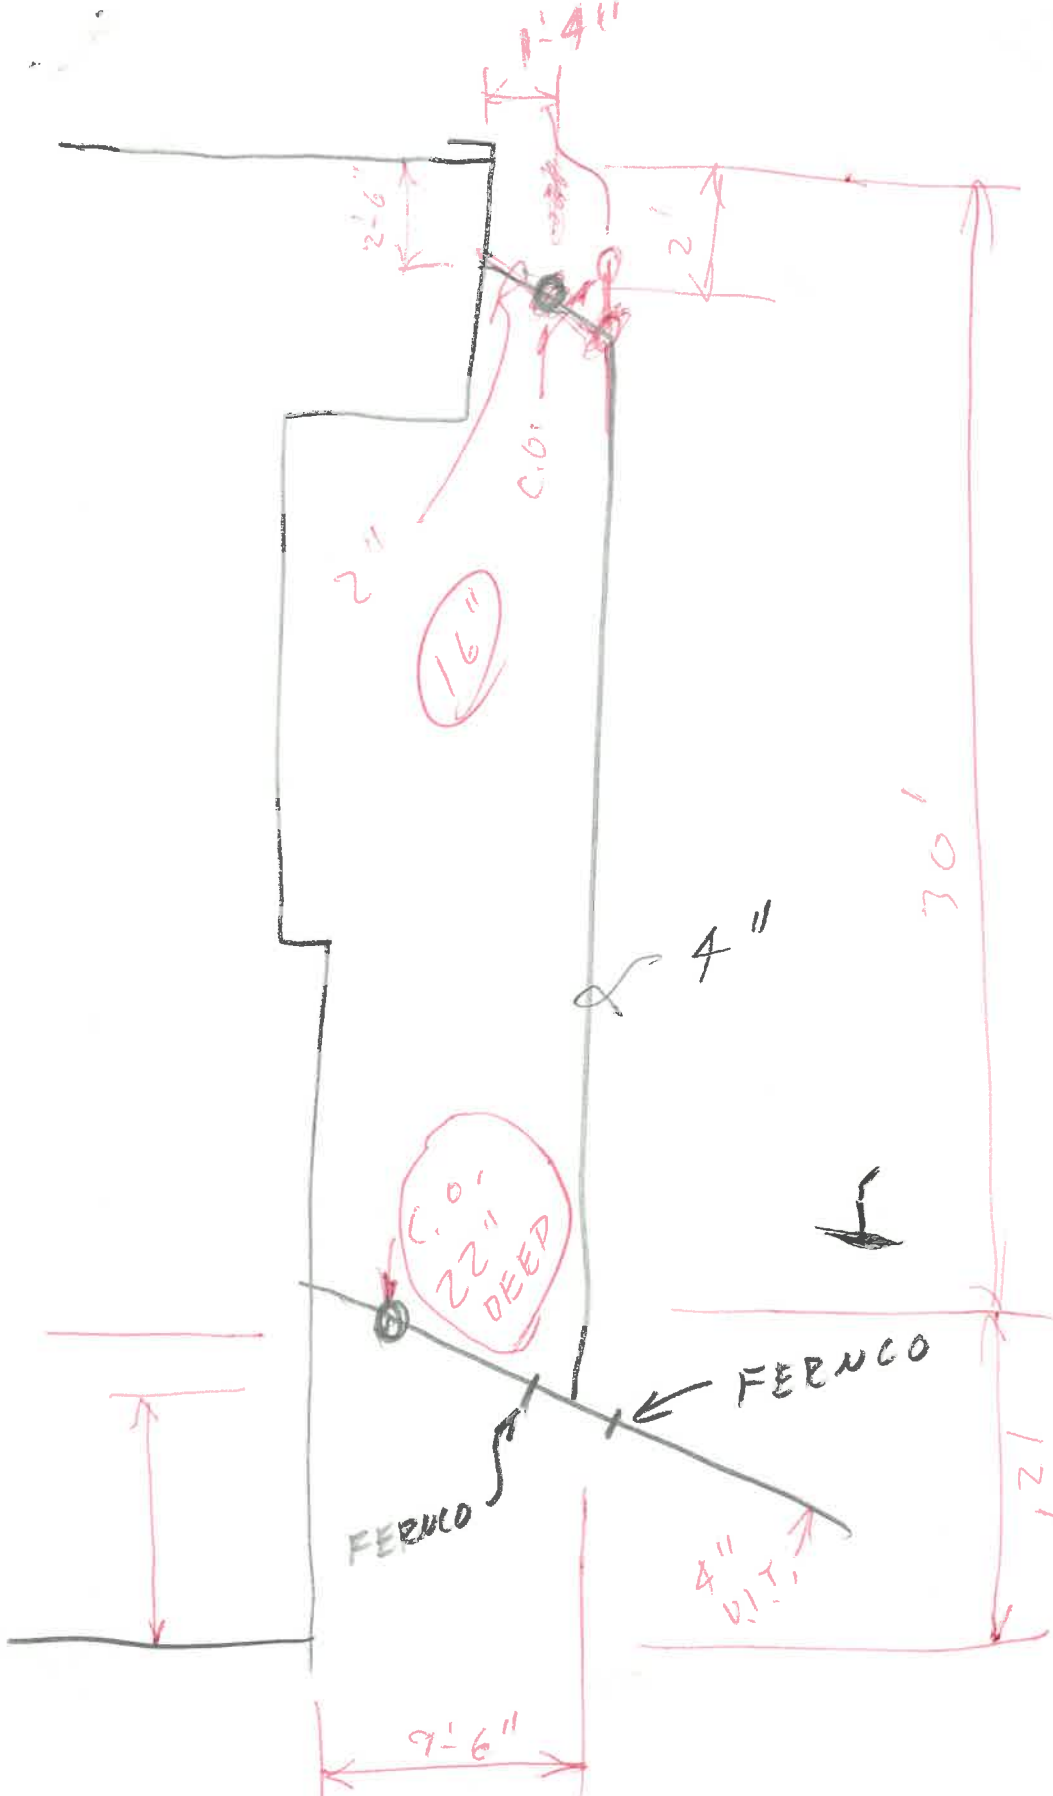

FRONT

CITY OF NAPOLEON
 BUILDING INSPECTION DEPARTMENT
 APPLICATION FOR BUILDING PERMIT
 (Please print or type)

The undersigned hereby makes application for construction, installation, or alteration work as herein specified, agreeing to do all such work in strict accordance with the City of Napoleon's adopted Building Codes.

Location of project _____ Cost of project _____

Owner's Name _____ Address _____

Contractor _____ Telephone No. _____

Address _____

Lot Information: (Not required for siding job)

Lot No. _____ Subdivision _____

Zoning District _____ Lot Size _____ ft. X _____ ft. Area _____ sq. ft.

Setbacks: Front _____ Right Side _____ Left Side _____ Rear _____

Work Information:

Residential _____ Commercial _____ Industrial _____

New Construction _____ Addition _____ Remodel _____

Accessory Building _____ Siding _____ (Specific Type) _____

Brief Description of Work: _____

Size: Length _____ Width _____ No. of Stories _____

Area: 1st Floor _____ sq. ft. Basement _____ sq. ft.

2nd Floor _____ sq. ft. Accessory Bldg. _____ sq. ft.

3rd Floor _____ sq. ft. Other _____ sq. ft.

Additional Information: _____

APPLICATION FOR PERMIT SHALL BE ACCOMPANIED BY TWO COMPLETE SETS OF PLANS INCLUDING: ELEVATIONS, FLOOR PLANS, CROSS SECTIONS AND PLOT PLAN. IF ADDITION OR REMODELING, SHOW ALL EXISTING STRUCTURES AND THEIR SIZE AND LOCATION. ALL PLANS SHALL BE DRAWN TO SCALE.

Date _____ Applicant's Signature _____

PERMIT FEE \$

PERMIT NO.