
## SEWER TAPPING PERMIT

Issued by

## The City of Napoleon Engineering Dept. 255 West Riverview Ave. Napoleon, Ohio 43545 Pn. 592-4010

Entry No.	255 West Riverview Ave. Napoleon, 8	hio 43545 Pn. 592-4010
Permit No. <u>SA 0139</u> Issued <u>5-10-9</u>	20_Build. Permit No	. Permit Fee \$ Nowe
Job Location 1371 OAKWOOL		Street Bond \$
Lot 540 1/4 SE 1/4 SECTION /2	DAP TOWNSHIP	Date Paid
Issued By M. Helbery		•
Owner Clarence yocom	Pn. 592-3245	•
Address 1371 Dakwood	Aue.	• •
Agent Same	Pn	•
Address		. for office use only
WORK INFORMATION		
763 110	· · · · · · · · · · · · · · · · · · ·	411 Street to be Opened
Storm Sewer Tap Size of Tap	Size and Type of Sewer	yes no Street to be Opened
Street opening Agreement Approval Date	Wowe Opening Bond F	ee (Set by Engineer) None
by and in strict accordance with all applica Standard Specification for Water Main, Sanit	ble provisions of The Napoleon Enginee ary Sewer and Storm Sewer Construction	ove and to make use of said sewers only as allowed ring Dept. Rules and Regulations, The Napoleon and other Pertinent Sections of the Napoleon
Date <u>5-10-90</u> Si	onature of Applicant	of your
	Per	e Joenne rmit not valid without signature
		~~~~~~~~~~~~~~~~~~~~~~~~~~~~~~~~~~~~~~~
		to be completed by the Field Inspector
Date Inspection is made <u>5-25-90</u>	Size and Type of Sewer	411 214.61
Location SEK PLAN Depth	Type of Test Additi	ional Information
	POV TO SECOND SE	
		7 0 h a a a a a a a a a a a a a a a a a a
Date <u>5-21-90</u> Inspec	ited By Ecoon Ho	UBER
	signatu	ure of inspector

Sketch Of Installation on Back or Attached

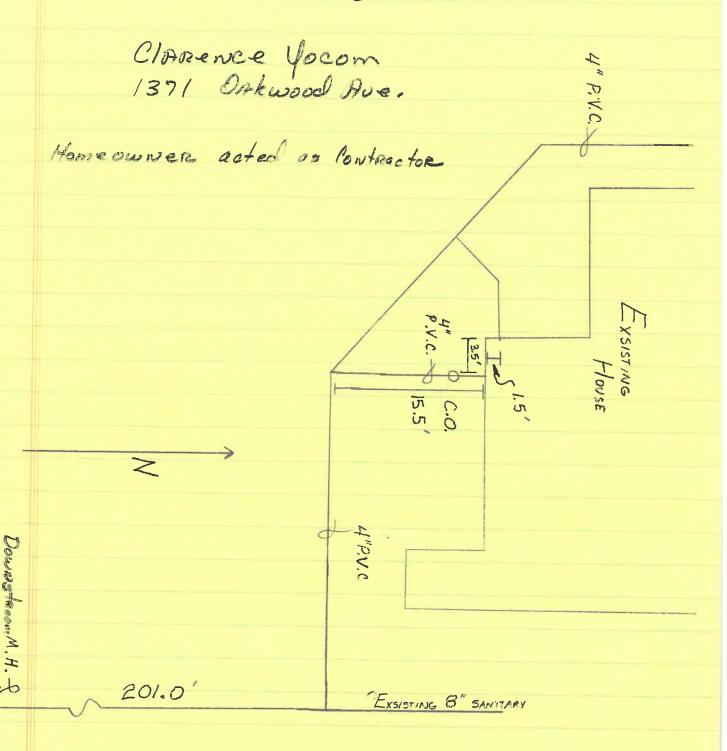

R