

14'-5"

Delete + Credit

~~HENRY COUNTY~~

15'

15'

CHILD SUPPORT ENFORCEMENT AGENCY

33'-7"

Stud mounting

SCALE 1/2" = 1'-0"

15" INJECTION MOLDED PLASTIC LETTERS.

HELVETICA LETTER STYLE

BAKED ENAMEL FINISH


FINISH COLOR: #2030 Green (verify w/ C.M.)
match commissioners letters)

DRAWINGS INDICATE STAND OFF.


SPECIFICATIONS CALL FOR NO STAND OFF.

STAND OFF DISTANCE: match existing @ commissioners
verify w/ C.M.

SEE GEMINI COLOR CHART FOR AVAILABLE PLASTIC COLORS

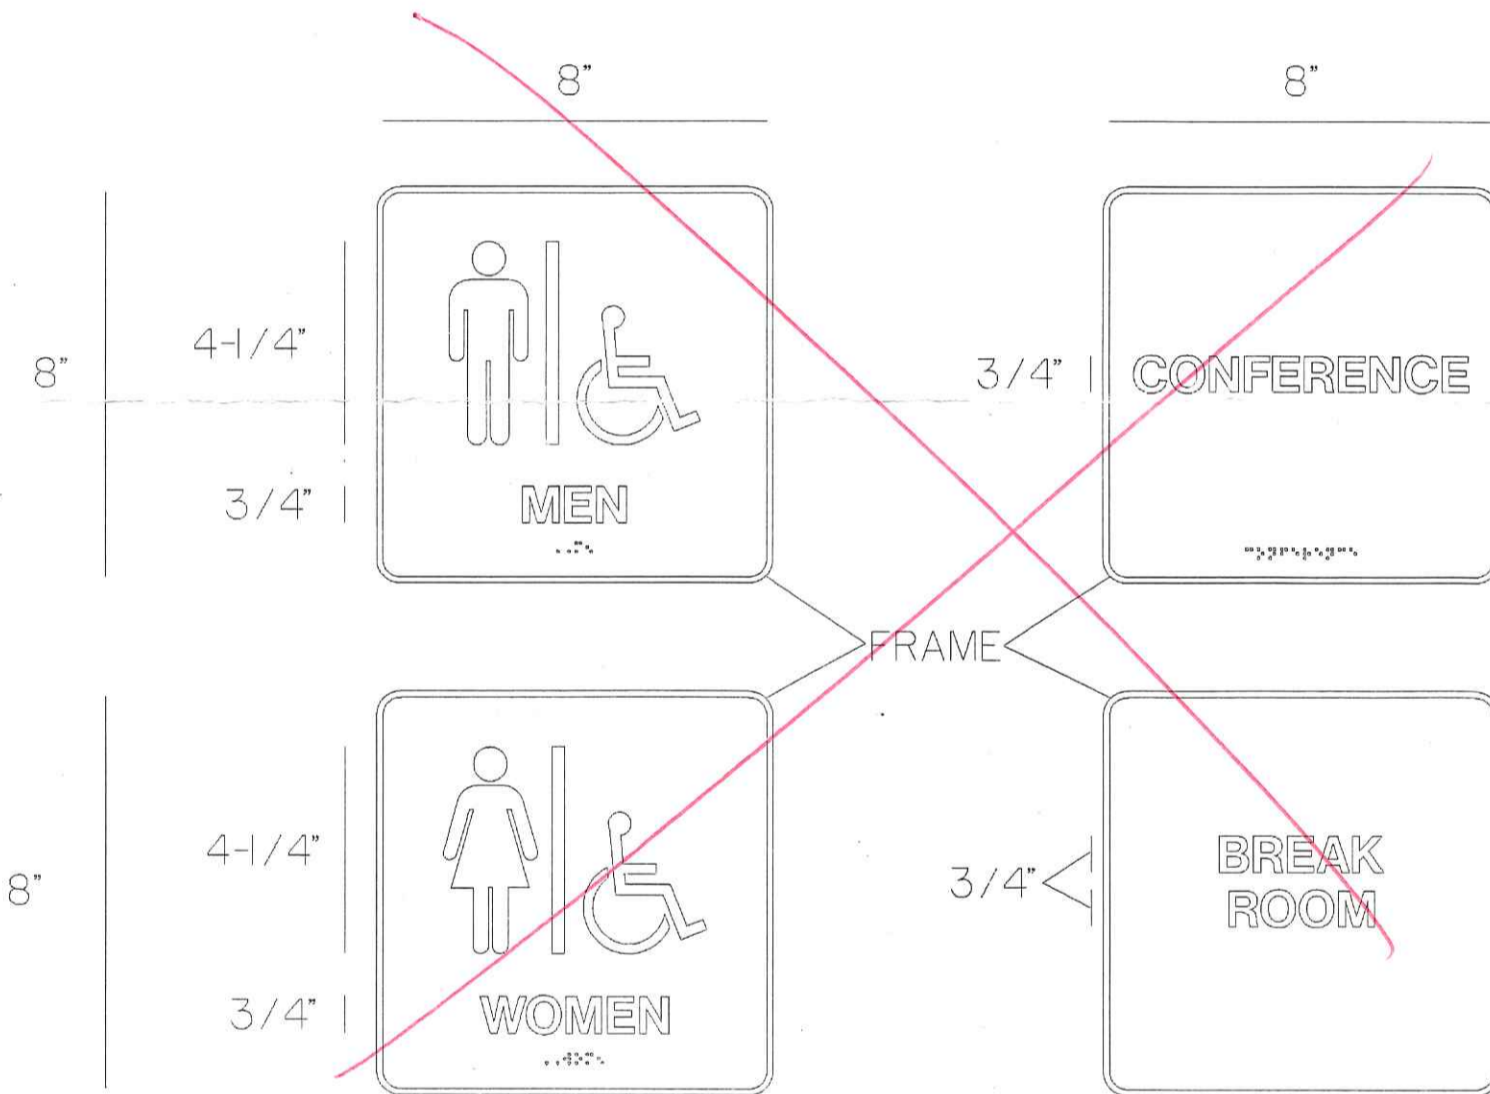

By Others

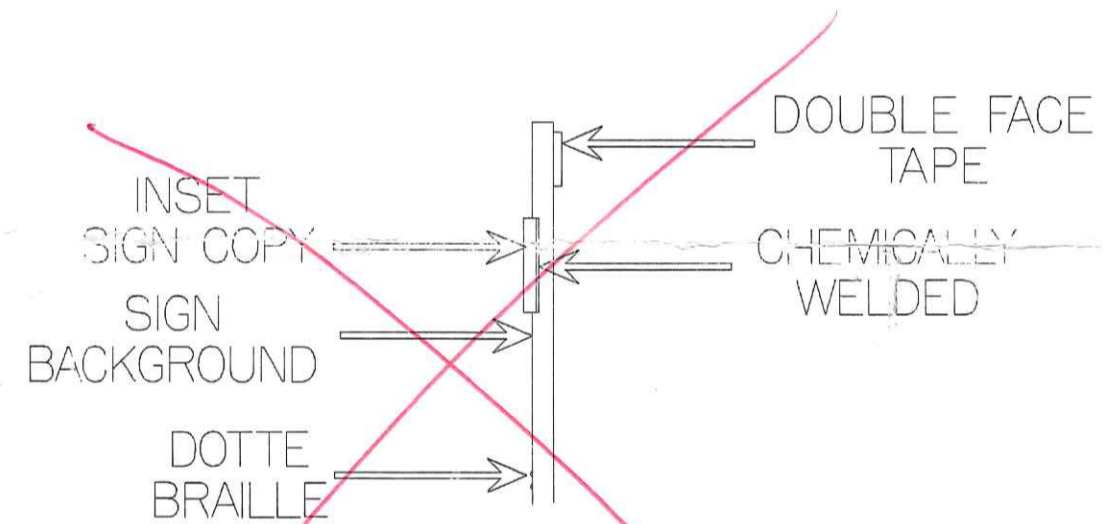

SIGN DETAIL
NO SCALE
SIGN AFFIXED TO WALL
WITH DOUBLE FACE TAPE

SHOP DRAWINGS REVIEW

NO EXCEPTIONS TAKEN REVISE AND RESUBMIT

REJECTED SUBMIT SPECIFIED ITEM

FURNISH AS SUBMITTED FURNISH AS NOTED

THIS CHECK IS ONLY FOR GENERAL CONFORMANCE WITH THE DESIGN CONCEPT OF THE PROJECT AND GENERAL CONFORMANCE WITH THE INFORMATION GIVEN IN THE CONTRACT DOCUMENTS. NOTATIONS, DIMENSIONS, AND REQUIREMENTS OF THE CONTRACT DOCUMENTS AND DO NOT AUTHORIZE ANY CHANGES INCLUDING ANY RESPONSES UNLESS STATED IN ACCORDANCE WITH THE CONTRACTOR'S RESPONSIBILITY FOR ALL QUANTITIES AND DIMENSIONS. FOR SELECTIVE FABRICATION PROCESSES, FOR TECHNIQUES OF ASSEMBLY AND PERFORMING HIS WORK IN A SAFE MANNER.

TECHNICON DESIGN GROUP, INC. DATE: 2/13/08

BY: Denise Annissen

SCALE 3" = 1'-0"

ADA SIGNS INSTALLED PER ADA SPECIFICATIONS

TYPICAL 8" x 8" SIGNS WITH 3/8" RADIUS CORNERS

LETTER & SYMBOL COLOR: _____

BACKGROUND COLOR: _____

PLASTIC FRAME COLOR: _____

SEE ROWMARK COLOR CHART SIGN COLORS

DESIGNER COLOR CHART FOR FRAME COLOR

SIGNAGE LIST: (QTY 1 EACH)

- DOOR NUMBER SIGN COPY
- I03 WORK AREA
- I04 CONFERENCE
- I05 INTERVIEW
- I06 WORK AREA
- I07 DIRECTOR
- I08 OFFICE
- I10 FILES
- III STORAGE
- I12 WOMEN (W/ H/C SYMBOL)
- I13 MEN (W/ H/C SYMBOL)
- I14 JANITOR
- I15 BREAK ROOM
- I17 SERVER

SHOP DRAWINGS REVIEWED

No Exceptions Taken

See Markings

Work to be done in accordance with Specifications.

THE SPIEKER COMPANY

By Ryan Keller Date 2-7-08

1809 Oakwood

HENRY COUNTY CHILD SUPPORT ENFORCEMENT AGENCY		
	WO # 8362	1-30-08
ARCHITECTURAL ARTS. DIVISION OF DIGIMATICS, INC.		
SIGNAGE		JKB