

SEWER TAPPING PERMIT

Issued by

The City of Napoleon Engineering Dept.

255 West Riverview Ave. Napoleon, Ohio 43545 Ph. 592-4010

Entry No. _____

Permit No. SA 0125 Issued 6-6-89 Build. Permit No. _____

Permit Fee \$ 31726.00

Job Location Oakwood Plaza 1851 OAKWOOD

Street Bond \$ 2000.00

Lot NW 114 NE 114 SECTION 12 NAPOLEON TOWNSHIP
sub div. or legal disc.

Date Paid 7-13-89

Issued By EJ

Owner Hutchens Co. Pn. _____

Address Aickens S. Carolina

Agent Vernon Nagel Inc Pn. 592-3861

Address Napoleon, Ohio

for office use only

WORK INFORMATION

Extention Ext 10"

Sanitary Sewer Tap Size of Tap 8" Size and Type of Sewer 10" PVC Street to be Opened

Storm Sewer Tap _____ Size of Tap _____ Size and Type of Sewer _____ Street to be Opened _____

Street opening Agreement Approval Date _____ Opening Bond Fee (Set by Engineer) _____

READ AND SIGN BELOW; The undersigned hereby agrees complete the work described above and to make use of said sewers only as allowed by and in strict accordance with all applicable provisions of The Napoleon Engineering Dept. Rules and Regulations, The Napoleon Standard Specification for Water Main, Sanitary Sewer and Storm Sewer Construction and other Pertinent Sections of the Napoleon Code of Ordinances.

Date 6-6-89 Signature of Applicant Vernon Nagel Inc. [Signature]
Permit not valid without signature

INSPECTION RECORD _____ to be completed by the Field Inspector

Date Inspection is made _____ Size and Type of Sewer 8" SIDR 35 ASTM 3079



Location SEE PLAN Depth SEE PLAN Type of Test AIR TEST Additional Information SEE ATTACHMENT

DRAWINGS

Date 7-21-89 Inspected By SOOPY HELPER
signature of inspector

Sketch Of Installation on Back or Attached

WAL-MART SANITARY SEWER
AIR TESTING

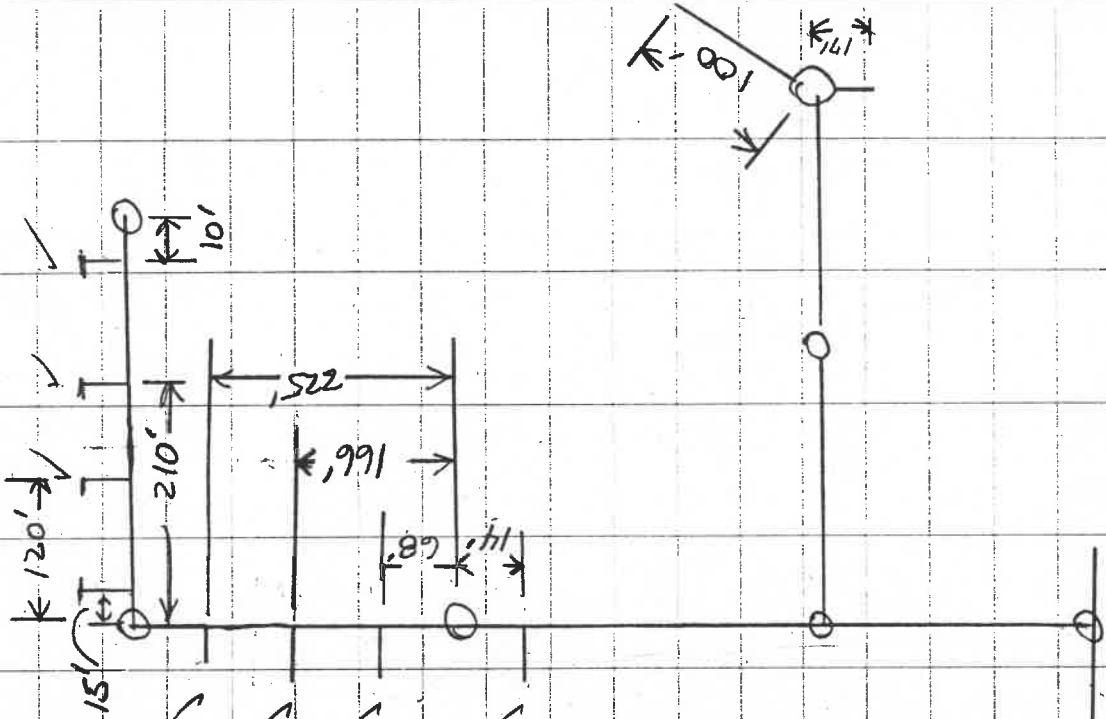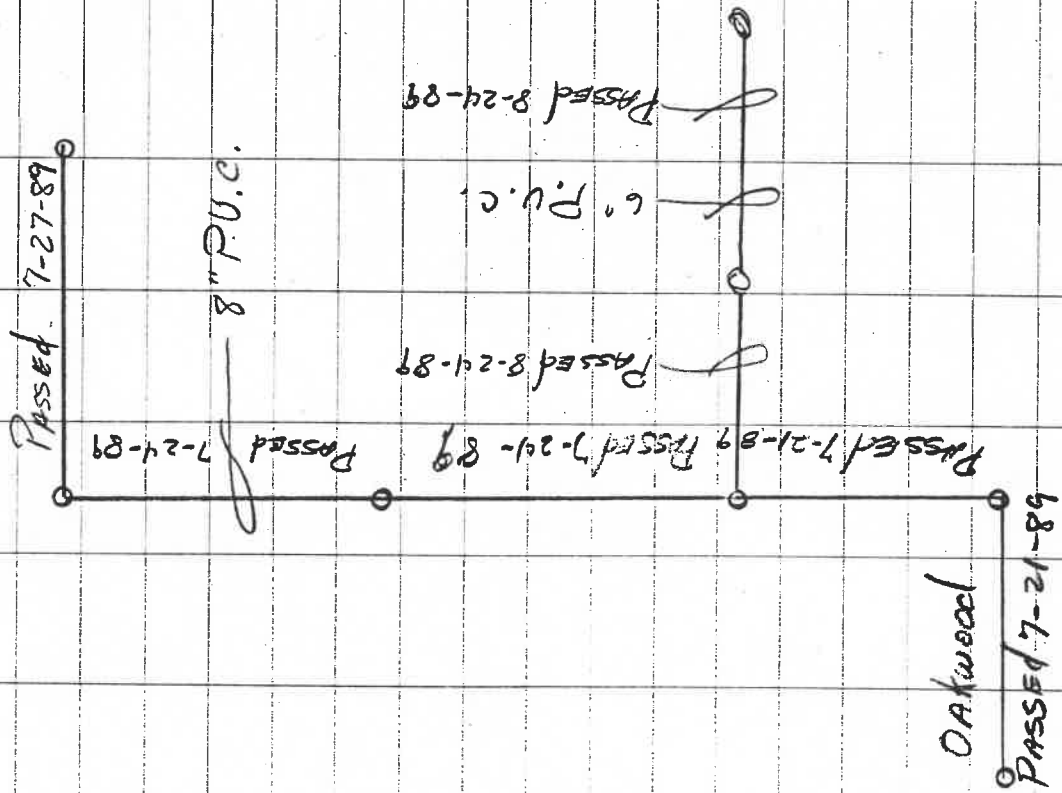

WAL-MART SANITARY SEWER
Air Testing

