

SEWER TAPPING PERMIT

Issued by

The City of Napoleon Engineering Dept.

255 West Riverview Ave. Napoleon, Ohio 43545 Pn. 592-4010

Entry No. \_\_\_\_\_

Permit No. <sup>0123</sup> ~~57-025~~ Issued 7-10-89 Build. Permit No. \_\_\_\_\_

Job Location 1220 OHIO ST

Lot \_\_\_\_\_

Issued By \_\_\_\_\_ sub div. or legal disc.

Owner Peter PHARIS Pn. 882-5511

Address 5041 BRENDEN WAY SYLVANIA O

Agent ELMER JUNGE Pn. 748-8645

Address R112 Rd 7 RTS Napoleon O

Permit Fee \$ None

Street Bond \$ \_\_\_\_\_

Date Paid \_\_\_\_\_

for office use only

WORK INFORMATION

Sanitary Sewer Tap \_\_\_\_\_ Size of Tap \_\_\_\_\_ Size and Type of Sewer \_\_\_\_\_ Street to be Opened \_\_\_\_\_

yes no

Storm Sewer Tap \_\_\_\_\_ Size of Tap \_\_\_\_\_ Size and Type of Sewer \_\_\_\_\_ Street to be Opened \_\_\_\_\_

yes no

Street opening Agreement Approval Date \_\_\_\_\_ Opening Bond Fee (Set by Engineer) \_\_\_\_\_

READ AND SIGN BELOW; The undersigned hereby agrees complete the work described above and to make use of said sewers only as allowed by and in strict accordance with all applicable provisions of The Napoleon Engineering Dept. Rules and Regulations, The Napoleon Standard Specification for Water Main, Sanitary Sewer and Storm Sewer Construction and other Pertinent Sections of the Napoleon Code of Ordinances.

Date July 10, 1989 Signature of Applicant \_\_\_\_\_

*Peter W. Pharis*

Permit not valid without signature

INSPECTION RECORD

to be completed by the Field Inspector

Date Inspection is made 8-4-89 Size and Type of Sewer 4" P.V.C. 3034

Location \_\_\_\_\_ Depth 8 to 5 Type of Test \_\_\_\_\_ Additional Information \_\_\_\_\_

SEE ATTACHED


Date 8-4-89 Inspected By Malcolm Helberg

signature of inspector

Sketch Of Installation on Back or Attached



Michigan

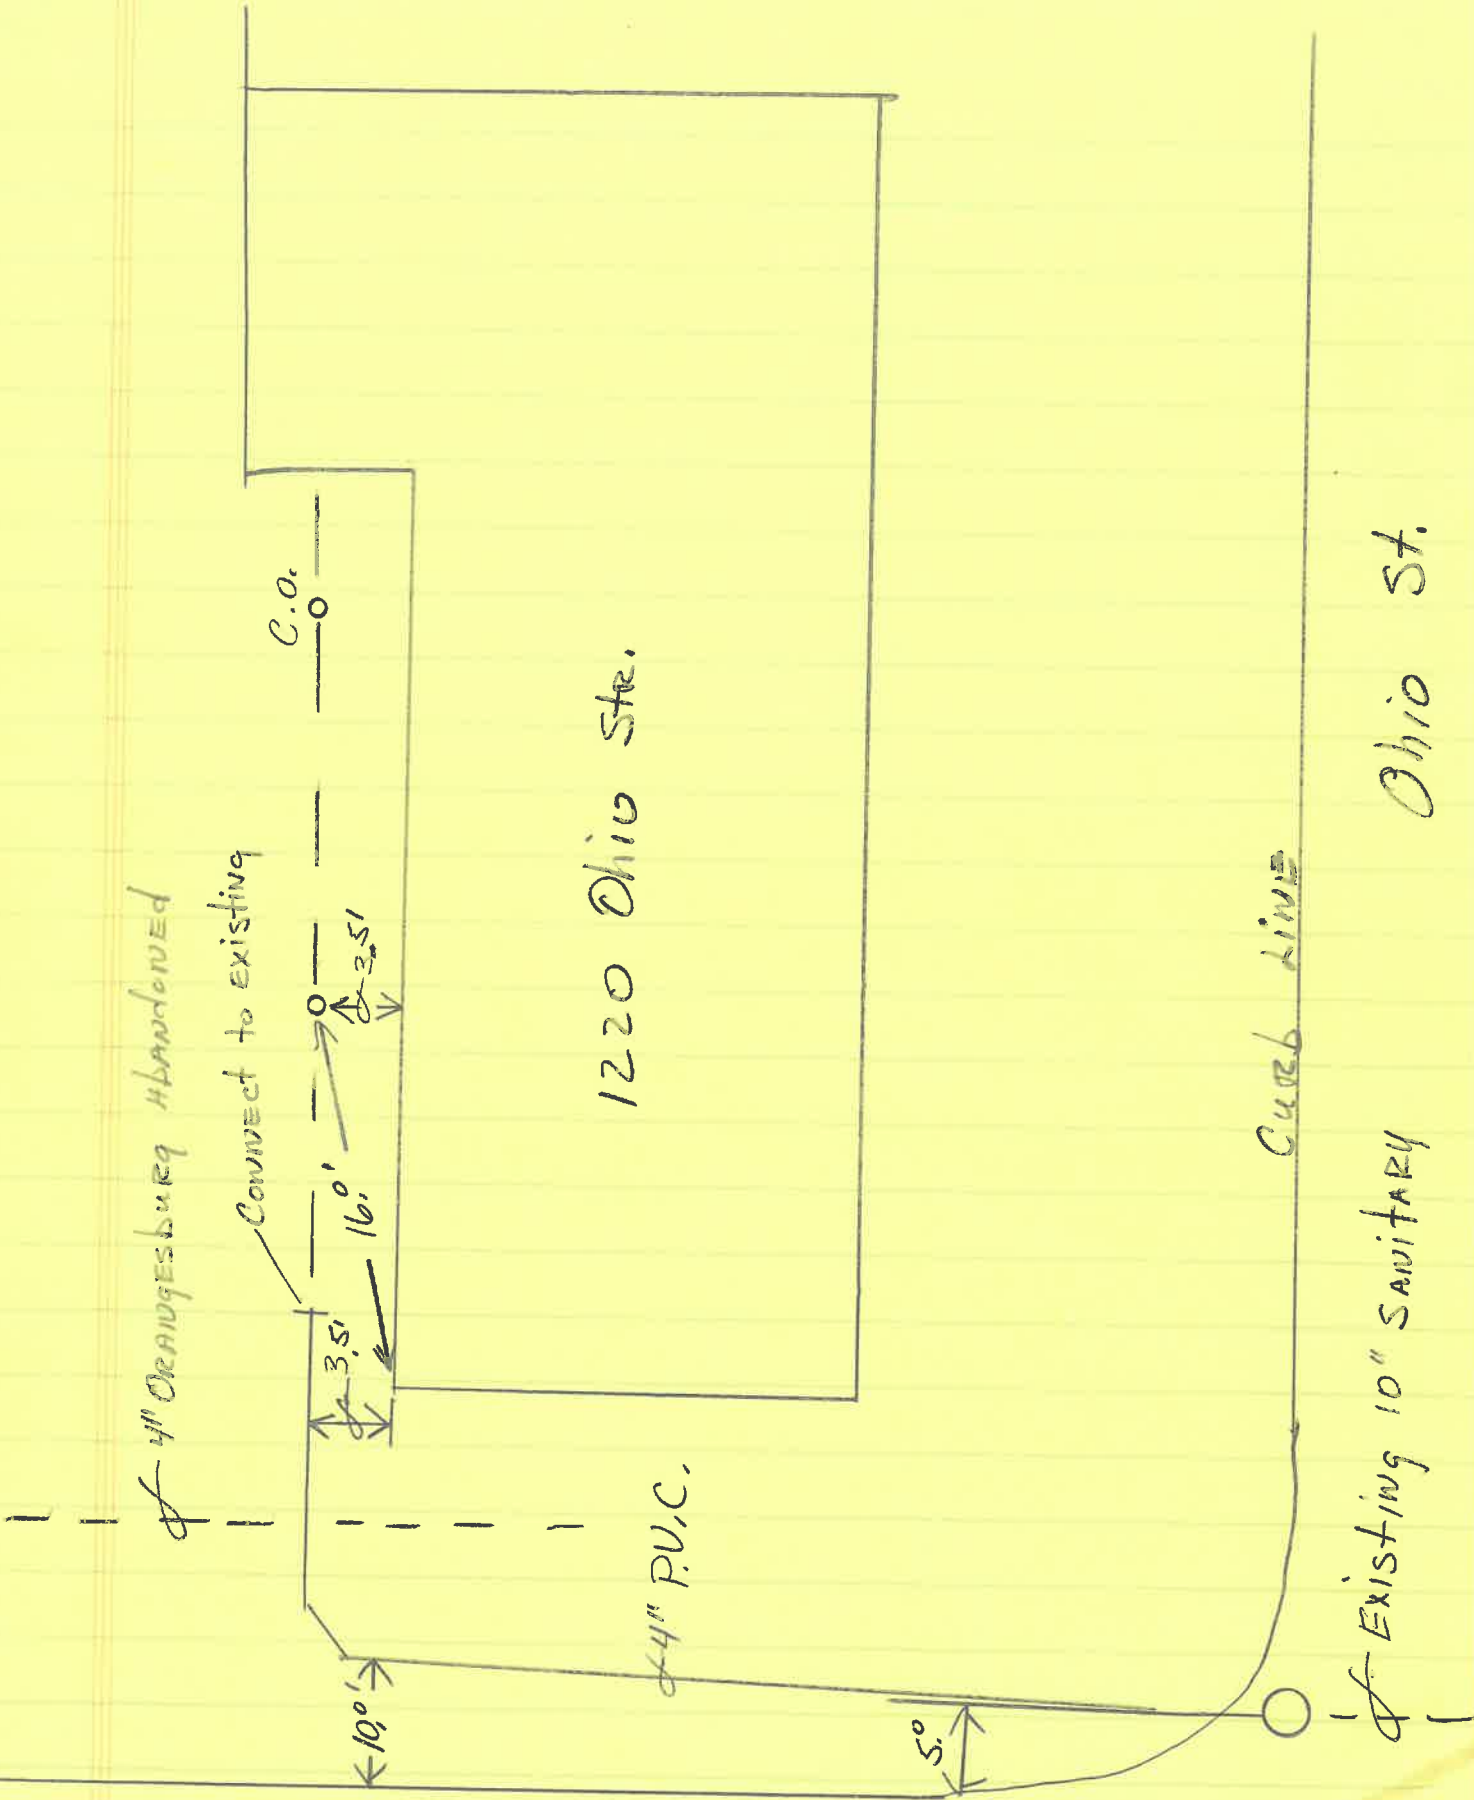

4" Orangeburg abandoned

Connect to existing

C.O.

3.5'

16.0'

10.0°

1220 Ohio Str.

4" P.V.C.

5°

CURB LINE

Existing 10" SANITARY

Ohio St.