

APPLICATION FOR PERMIT TO TAP SEWER

(Print or Type)

Owner Florence Wiechman
Address 516 Ohio St. Napoleon, Ohio
Contractor Paul's Plumbing Shop
Address 164 North St. Napoleon, Ohio Tel. 599-2431

NO. _____
BLDG. PERMIT _____
PERMIT FEE \$ _____
DATE PAID _____
for office use only

LOCATION OF CONNECTION

Street and No. 516 Ohio St. Sanitary Storm _____
Lot No. _____ Subdivision _____ Size of Tap 6"
Size and Type of Sewer _____

ALL WORK MUST BE INSPECTED

I certify that the sewer will be used only as indicated and no other Drainage will be connected.

Date 9/28/79 Signature Florence Wiechman
owner-builder agent


do not write below this line

INSPECTION RECORD

Date Inspected September 28 Size and Type of Sewer 4" Vitrified Clay
Location 516 Ohio Depth 2 1/2' Type of Test _____
Inspected and Approved By: Von Eric Berlin 9/28/79
Inspector Date
Additional Information SEPTIC TANK FILLED w/ STONE

Send copy to: FLORENCE WIECHMAN

SKETCH OF INSTALLATION

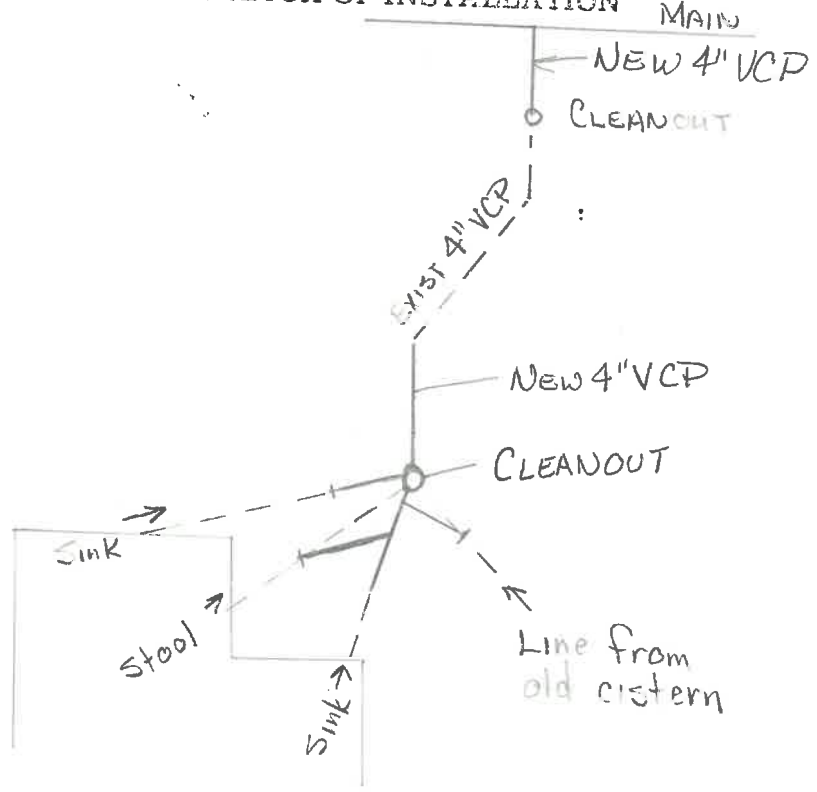

White-Applicant

Yellow-Building Dept.

Pink-Clerk-Treasurer