

WATER TAPPING PERMIT

issued by

The Napoleon Water Distribution Department

255 West Riverview Ave. Napoleon, Ohio 43545 Pn. 592-4010

Permit No. W- 0048 Issued 8-18-92 Received of German Bldg (\$ 375) .00

(Charge for tapping permit to supply water service to) Lot No. 2 Sub Div. Lutheran Home add. Replet

Street No. 1040 S. Perry Tap Size 1 " Cost \$ 375 .00 Plumber Fillings P+H
Unit # 33

Date completed _____ Approved by _____

COMPLETED

water distribution dept.


finance director

Name _____ Size of tap 1 " Date 8-4-92 Street and No. 1040 S. Perry # 33

Old Tap No. _____ New Tap No. 9237 Size and Kind of Main 8" PVC

Location of Main 7' West of West edge of Road Depth of Main 5 1/2'

Distance from Hydrant/Valve 42' S of Hyd # 429 Distance to Curb Stop from Corp. 8'

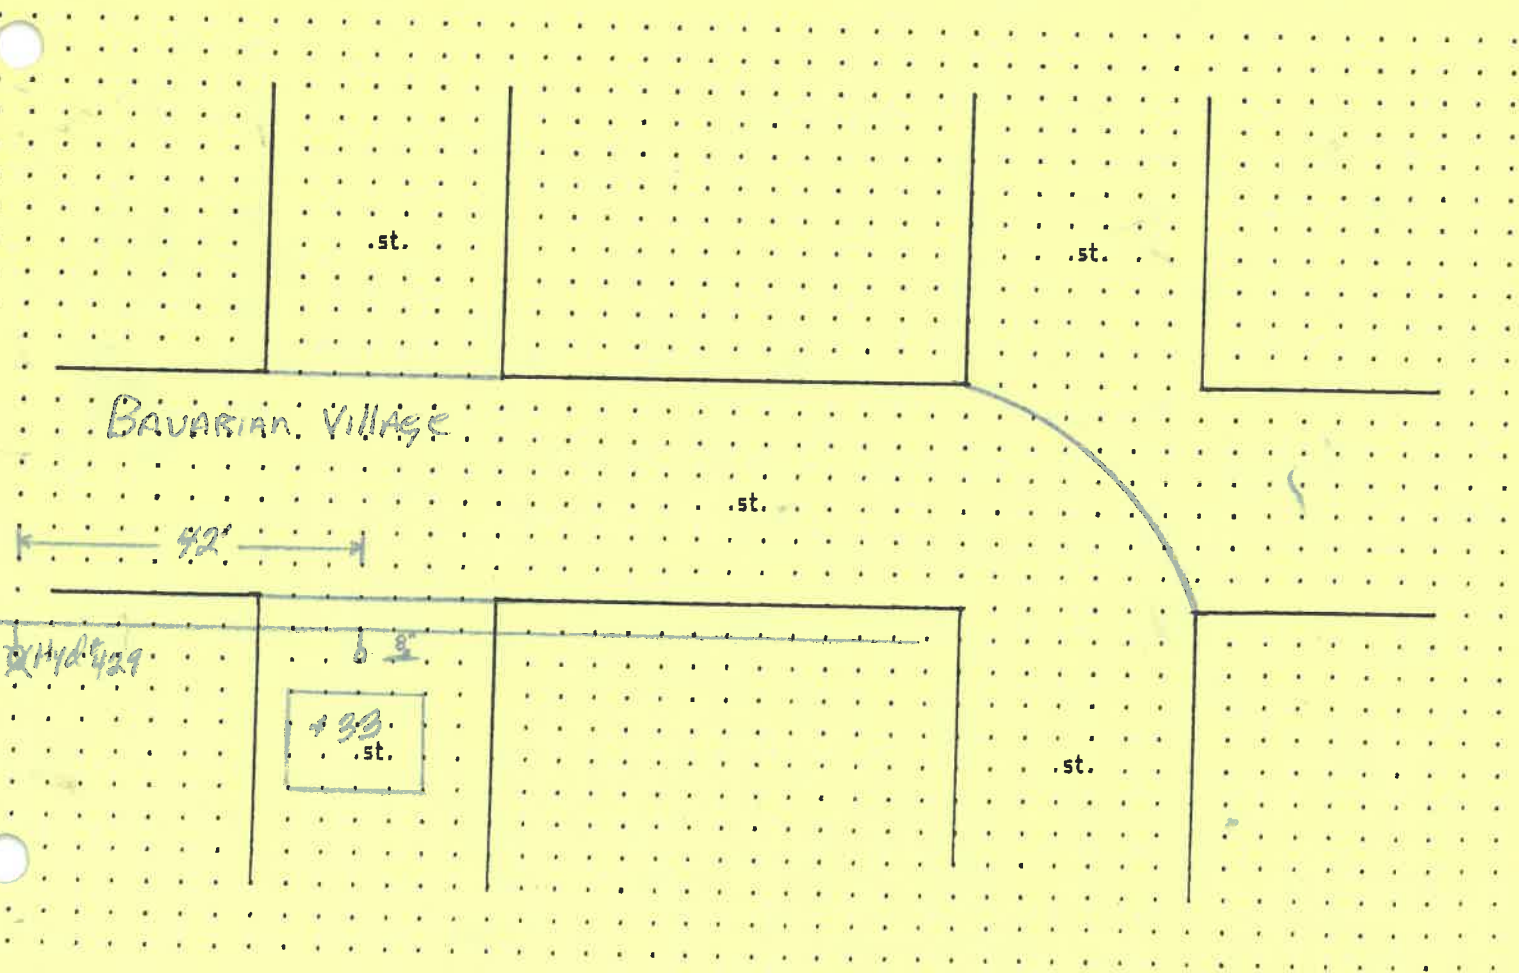

METER SOCKET RELEASE

issued by

The Napoleon Electric Distribution Department

639 Industrial Drive Napoleon, Ohio 43545 Pn. 592-9116 or 592-4010

Permit No. E-0099 Issued 9-21-92 Building permit No. 2716 Job Address 1040 S. Perry

Lot Number 2 Sub Division Lutheran Home Add. Replat Lot 3

Owner Lutheran Housing Serv. Owners Address 2411 Seaman St. Toledo, Oh Pn. No. 693-0751

Contractor Germann Bldrs Contractors Address 970 Oakwood Ave Napoleon, Oh Pn. No. 592-1806

Size of Service 200 Overhead _____ Underground X Issued By *Burt N. Samman*


COMPLETED

Date completed _____ Approved by _____

Size of Service _____ Overhead _____ Underground _____ Street and No. _____ electric distribution dept.

Old Meter No. _____ New Meter No. _____ Remarks _____

Sketch of Service

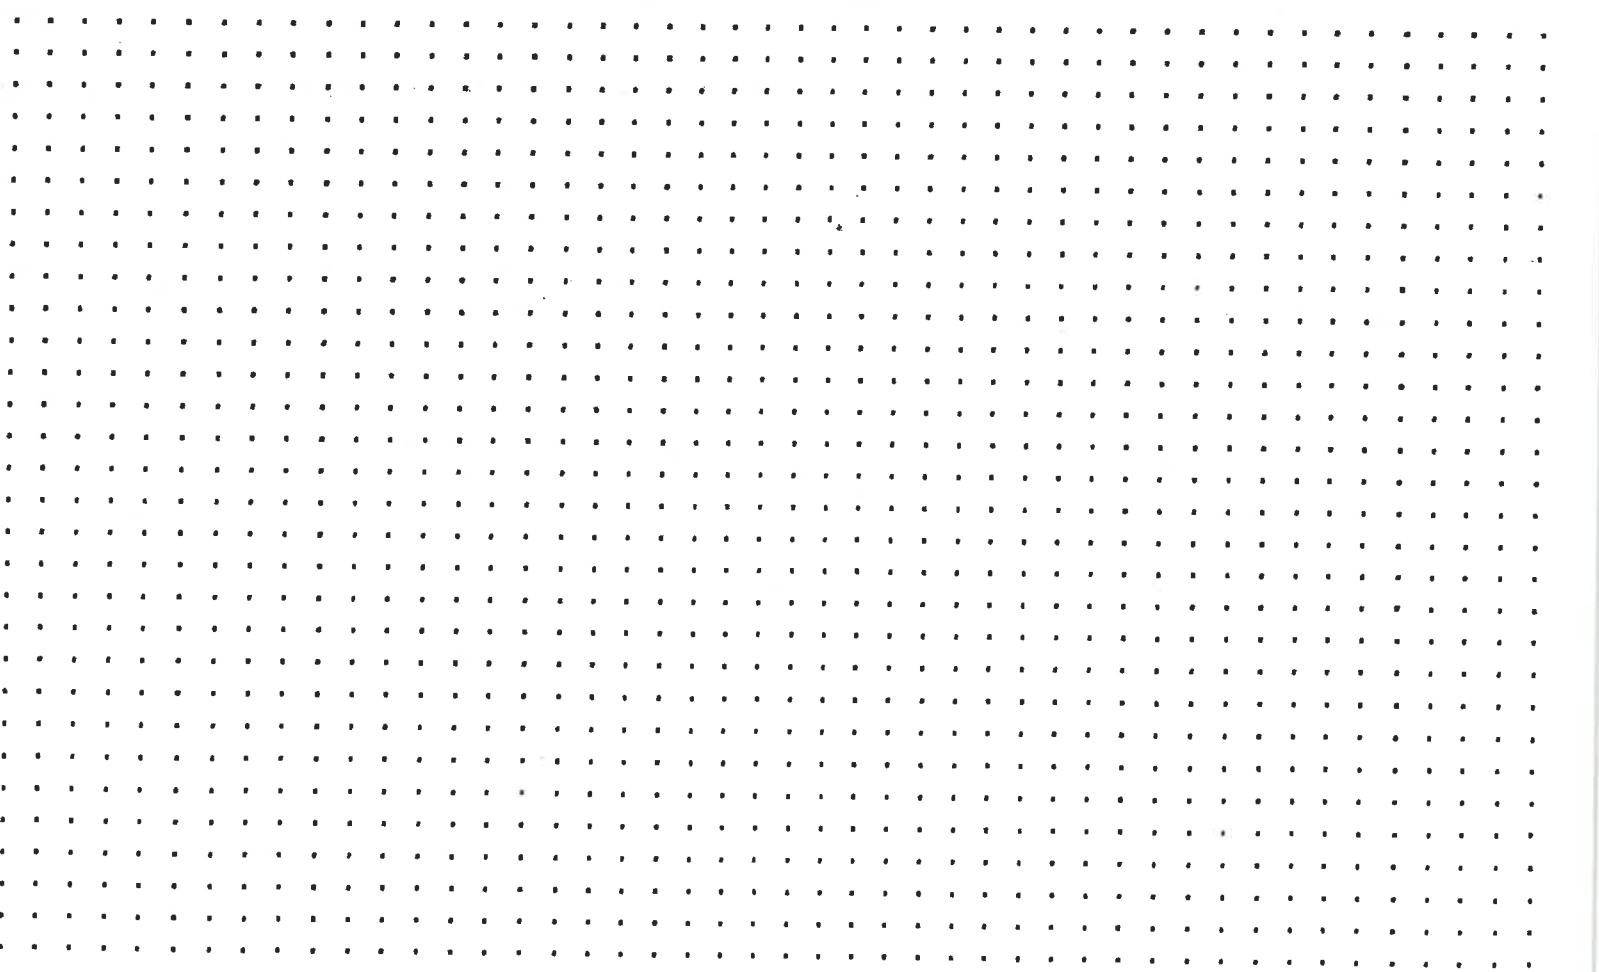

METER SOCKET RELEASE

issued by

The Napoleon Electric Distribution Department


639 Industrial Drive Napoleon, Ohio 43545 Pn. 592-9116 or 592-4010

Permit No. E-0098 Issued 9-21-92 Building permit No. 2716 Job Address 1040 S. Perry
 Lot Number 2 Sub Division Lutheran Home Add. Replat Lot 3
 Owner Lutheran Housing Serv. Owners Address 2411 Seaman St. Toledo, Oh Pn. No. 693-0751
 Contractor Gschmann Bldgs. Contractors Address 970 Oakwood Ave Napoleon Pn. No. 592-1806
 Size of Service 200 Overhead _____ Underground X Issued By Brent N. Dammann

COMPLETED

Date completed _____ Approved by _____
 Size of Service _____ Overhead _____ Underground _____ Street and No. _____ electric distribution dept.
 Old Meter No. _____ New Meter No. _____ Remarks _____

Sketch of Service

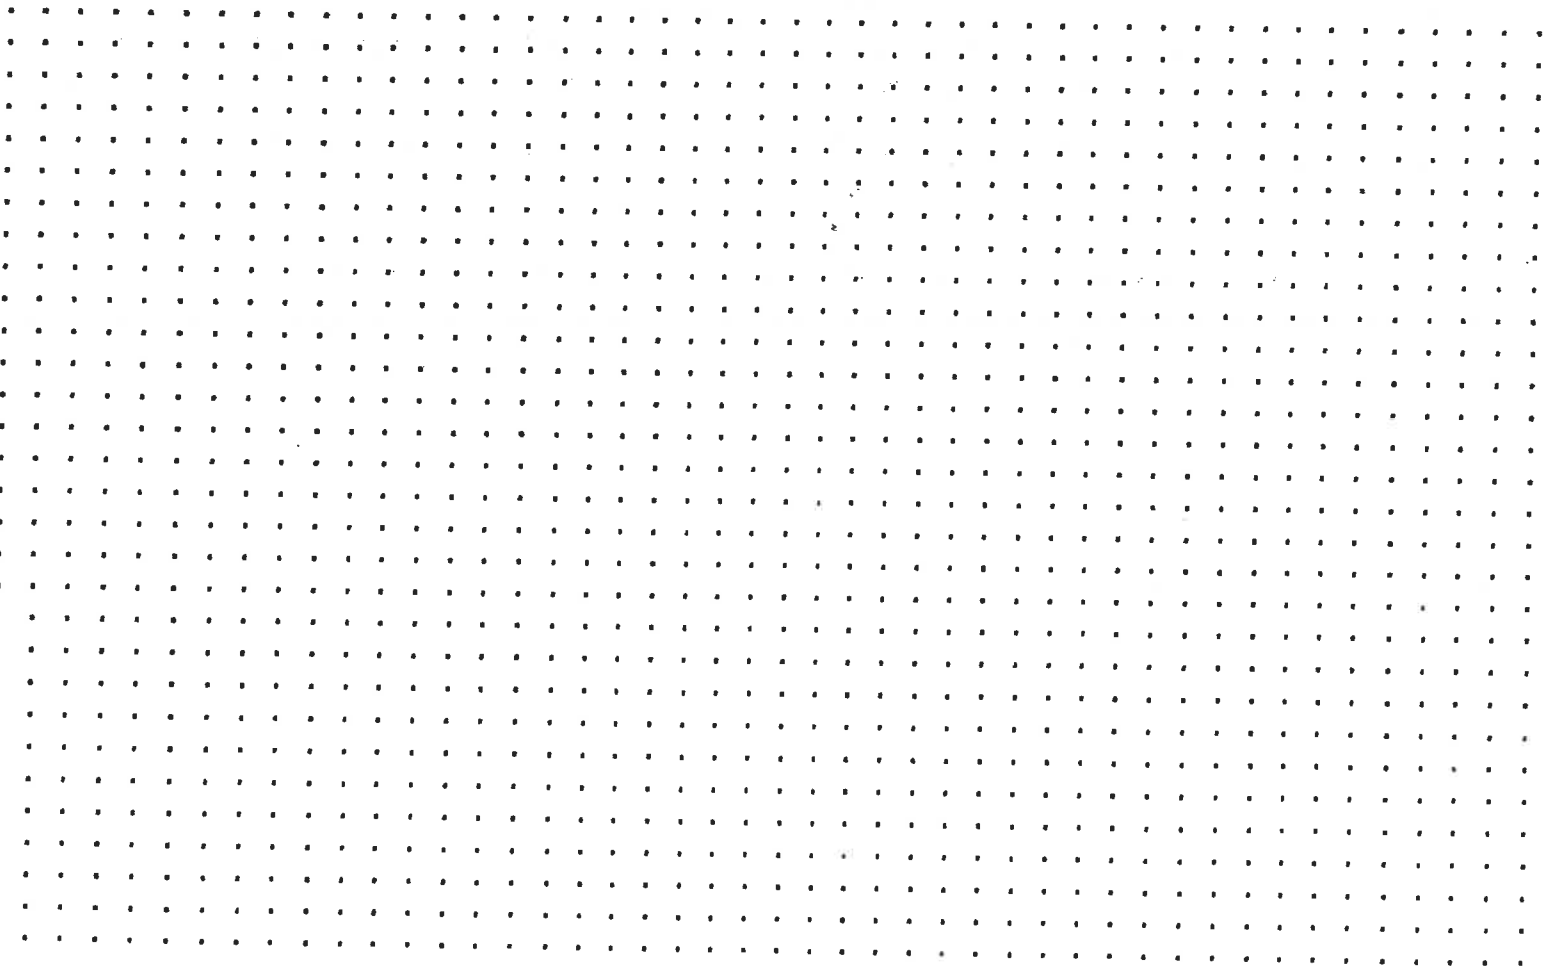

WATER TAPPING PERMIT

issued by

The Napoleon Water Distribution Department
255 West Riverview Ave. Napoleon, Ohio 43545 Pn. 592-4010

Permit No. W- 0048 Issued 8-18-92 Received of German Bldgs. \$ 375 .00

(Charge for tapping permit to supply water service to) Lot No. 2 Sub Div. Lutheran Home add. Replat

Street No. 1040 S. Perry Tap Size 1 Cost \$ 375 .00 Plumber Ellings P+H
unit #33

Date completed _____ Approved by _____
water distribution dept. finance director

Name _____ Size of tap _____ Date _____ Street and No. _____

Old Tap No. _____ New Tap No. _____ Size and Kind of Main _____

Location of Main _____ Depth of Main _____

Distance from Hydrant/Valve _____ Distance to Curb Stop from Corp. _____

