

Permit



# City of NAPOLEON

## ENGINEERING DEPARTMENT

255 W. Riverview Avenue, PO Box 151, Napoleon, OH 43545  
Phone: 419-592-4010 - Fax: 419-599-8393

Mayor  
J. Andrew Small

Members of Council  
Glenn A. Miller  
President

Terri A. Williams  
Ronald Behm  
Travis B. Sheaffer  
John A. Helberg  
Steven C. Small  
Michael J. DeWit

City Manager  
Dr. Jon A. Bisher

Finance Director  
Gregory J. Heath

Law Director  
David M. Grahm

City Engineer  
Chad E. Lulfs, P.E., P.S.

May 18, 2006

Ottawa Oil Company  
P.O. Box 346  
Ottawa, Ohio 45875

Re: **330 S. Perry Street**  
Sewer Relocation Notice

To Whom It May Concern,

Last year the City of Napoleon replaced the deteriorated sanitary main along the river with a new sanitary main along E. Maumee Avenue. Sanitary leads were installed to the right-of-way line for each property when the main was installed. Because of the deterioration of the existing main, property owners are required to tie into the new sanitary services that have been provided. All expenses to make this tie in are the responsibility of the property owner.

This letter shall serve as notice that you have ninety (90) days from the date listed above to address this situation. If actions are not taken by such time, water service to the property shall be terminated. Please contact our office for all appropriate permits and to schedule inspections. If you have any questions or require additional information, please contact me at your convenience.

Yours truly,

Chad E. Lulfs, P.E., P.S.  
City of Napoleon Engineer

cc: Jon A. Bisher, City Manager  
Tom Zimmerman, Building & Zoning Inspector  
Rex Moll, Construction Inspector

CEL/als

Ottawa Oil



330 PERRY STREET


120 E.

*From 1/2 of San. MH #3 casting*

26.5' STA. 3+00, 23' LT.  
18"~8" SANITARY W/ PLUG  
(NOT SHOWN IN PROFILE)  
INV. 8" = 655.20

Ex. R/W

Ex: 4" Walk

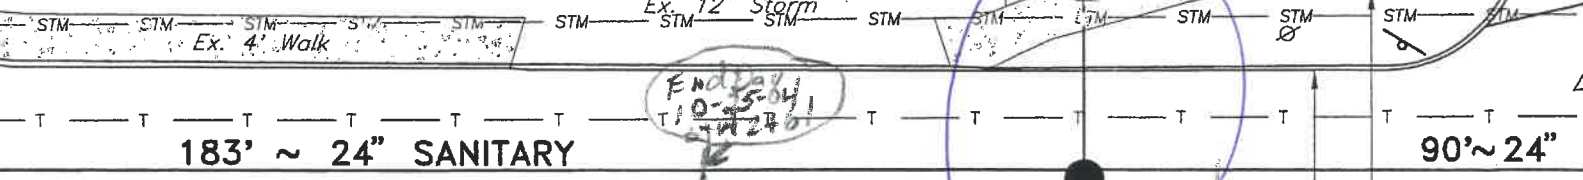

*End Day 10-25-04  
10-24-04*

*End Day 10-22-04  
STA. 3+04  
76' L.F.*

2+00

PROP. SAN. MH. #3

3+00


44' PVMT. R/W

PROP.

Ex. San. MH #20  
Rim = 670.00  
Inv. 4" SE = 665.00  
Inv. 8" NE = 664.40 (PLUG)

(TO BE REMOVED)

(TO BE ABANDONED)

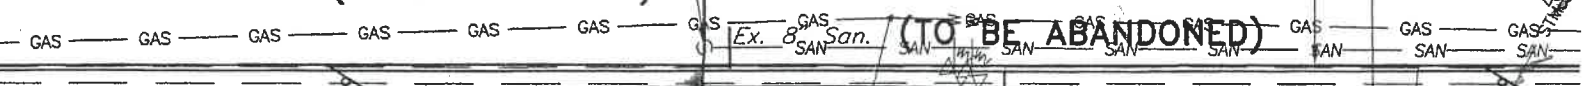


Armain (Campbell Soup)

Ex. 4" Walk

Ex. R/W

*Ex. 6" cast Iron  
5' Deep*

111 E. MAUMEE AVENUE

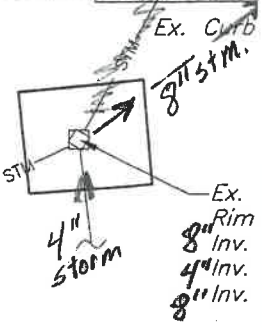

125 E. MAUMEE AVENUE

STA. 2+61, 24' RT.  
25"~6" SANITARY  
CONNECT TO EX. 4" SERVICE

MAUMEE AVENUE

Ex. @ Grade



# City of NAPOLEON, OHIO

255 West Riverview Avenue - P.O. Box 151  
Napoleon, Ohio 43545  
Telephone: 419/592-4010 Fax: 419/599-8393  
www.napoleonohio.com

## Fax Transmission

Mayor  
J. Andrew Small

Members of Council  
Glenn A. Miller, President  
Terri A. Williams  
Michael J. DeWit  
Steven C. Small  
James Hershberger  
Travis B. Sheaffer  
John A. Helberg

City Manager  
Dr. Jon A. Bisher

Finance Director  
Gregory J. Heath

Law Director  
David M. Grahn

To: Jill Welch

COMPANY NAME: \_\_\_\_\_

FAX NUMBER: 523.6549

NUMBER OF PAGES (INCLUDING COVER PAGE): 1

FROM: Chad Gulfs

DATE: 7/21/06 TIME: \_\_\_\_\_

OPERATOR: \_\_\_\_\_

COMMENTS:  
\_\_\_\_\_  
\_\_\_\_\_  
*Please call (419) 592-4010 if you have any trouble receiving this  
Transmission or you did not receive the number of pages shown above.*