


120 Pontious  
Nickelson  
Mort Cordes

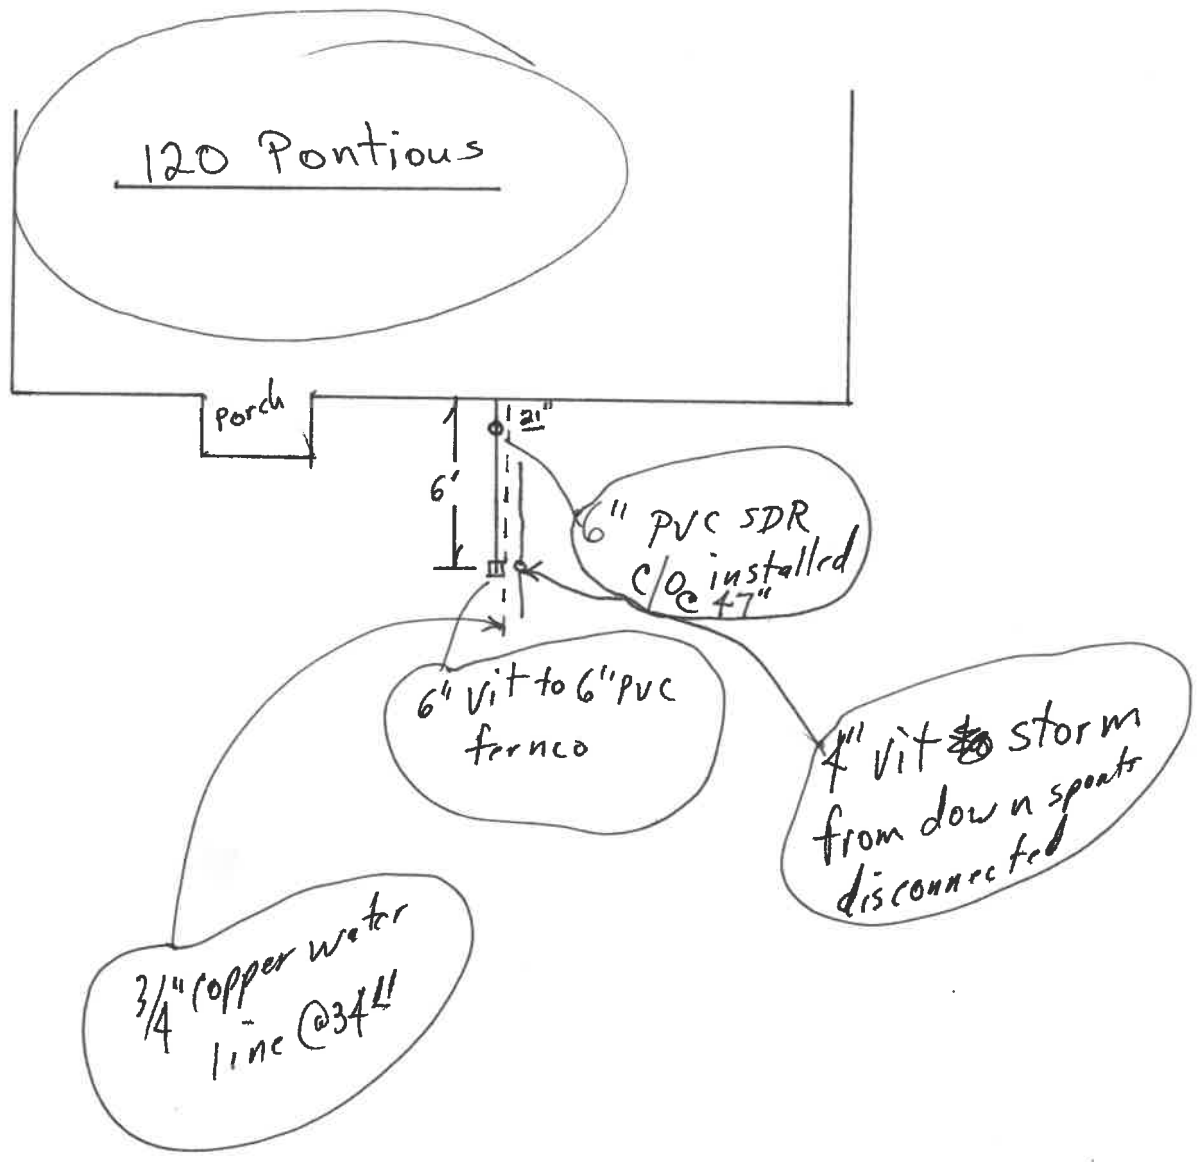

PAID  
JUL 15 1993  
CASH ON DELIVERY

SEWER TAPPING PERMIT

Issued by

The City of Napoleon Engineering Dept.

255 West Riverview Ave. Napoleon, Ohio 43545 Pn. 592-4010

Entry No. \_\_\_\_\_

Permit No. **00427** Issued 7-15-93 Build. Permit No. \_\_\_\_\_

Job Location 120 Pontious Pl.

Lot \_\_\_\_\_

Issued By BND sub div. or legal disc.

Owner Low Mickelson Pn. \_\_\_\_\_

Address 120 Pontious Pl. Napoleon, Oh

Agent \_\_\_\_\_ Pn. \_\_\_\_\_

Address 1631 Co. Rd. Pl RRA

Napoleon, Ohio

WORK INFORMATION

Sanitary Sewer Tap \_\_\_\_\_ Size of Tap \_\_\_\_\_ Sewer repair Size and Type of Sewer \_\_\_\_\_ Street to be Opened \_\_\_\_\_  
yes no

Storm Sewer Tap \_\_\_\_\_ Size of Tap \_\_\_\_\_ Size and Type of Sewer \_\_\_\_\_ Street to be Opened \_\_\_\_\_  
yes no

Street opening Agreement Approval Date \_\_\_\_\_ Opening Bond Fee (Set by Engineer) \_\_\_\_\_

READ AND SIGN BELOW; The undersigned hereby agrees complete the work described above and to make use of said sewers only as allowed by and in strict accordance with all applicable provisions of The Napoleon Engineering Dept. Rules and Regulations, The Napoleon Standard Specification for Water Main, Sanitary Sewer and Storm Sewer Construction and other Pertinent Sections of the Napoleon Code of Ordinances.

Date 7-15-93 Signature of Applicant BND

Permit not valid without signature

INSPECTION RECORD \_\_\_\_\_ to be completed by the Field Inspector

Date Inspection is made \_\_\_\_\_ Size and Type of Sewer \_\_\_\_\_

Location \_\_\_\_\_ Depth \_\_\_\_\_ Type of Test \_\_\_\_\_ Additional Information \_\_\_\_\_

Date \_\_\_\_\_ Inspected By \_\_\_\_\_

signature of inspector

Sketch Of Installation on Back or Attached

PAID

JUL 15 1993

CITY OF NAPOLEON

PAID

JUL 15 1993

CITY OF NAPOLEON

Permit Fee \$ 25.00  
 Street Bond \$ \_\_\_\_\_  
 Date Paid 7/15/93  
for office use only