

APPLICATION FOR PERMIT TO TAP SEWER

(Print or Type)

Owner Delbert Oberhouse NO. _____
Address 1069 Reynolds BLDG. PERMIT _____
Contractor Delbert Oberhouse PERMIT FEE \$ _____
Address Reynolds Tel. 758-3162 DATE PAID _____
for office use only

LOCATION OF CONNECTION
Street and No. 1069 Reynolds Sanitary Storm
Lot No. 96 Subdivision 2nd MARYDOPP MAP Size of Tap _____
Size and Type of Sewer 4" PVC ALL WORK MUST BE INSPECTED


I certify that the sewer will be used only as indicated and no other Drainage will be connected.
Date July 12, 1979 Signature Delbert Oberhouse owner-builder-agent
do not write below this line


INSPECTION RECORD

Date Inspected 7-12-79 Size and Type of Sewer 4" PVC
Location SIDE TO REAR Depth SEE DWG Type of Test _____
Inspected and Approved By: George Weinreich Inspector Date 7-12-79
Additional Information SEPTIC TANK FILLED w/ STONE

Send copy to: DELBERT OBERHOUSE

SKETCH OF INSTALLATION

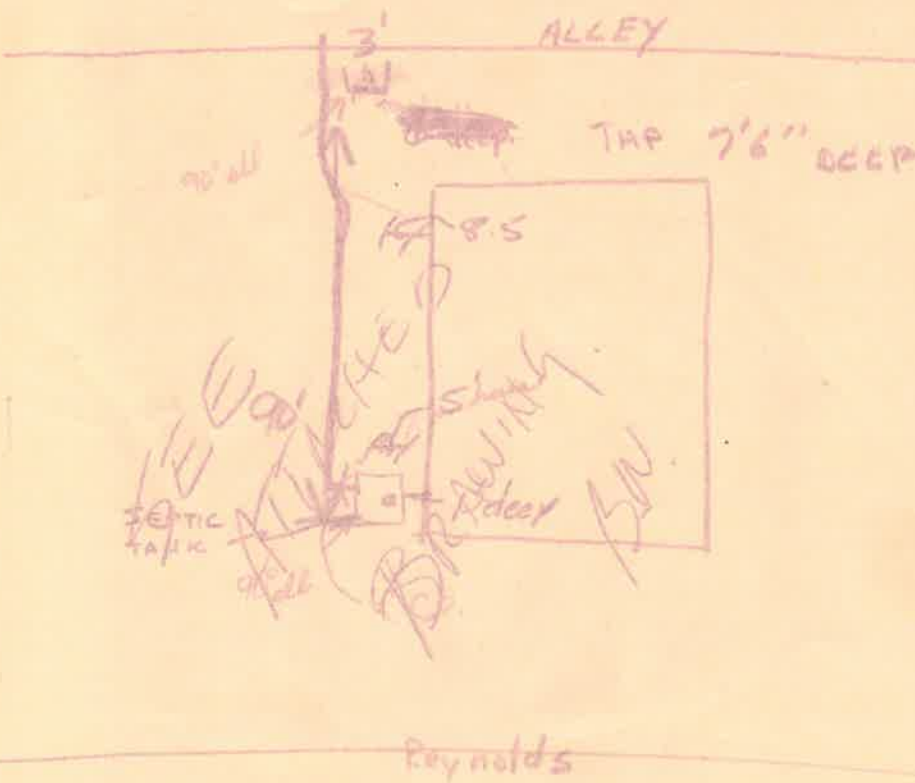

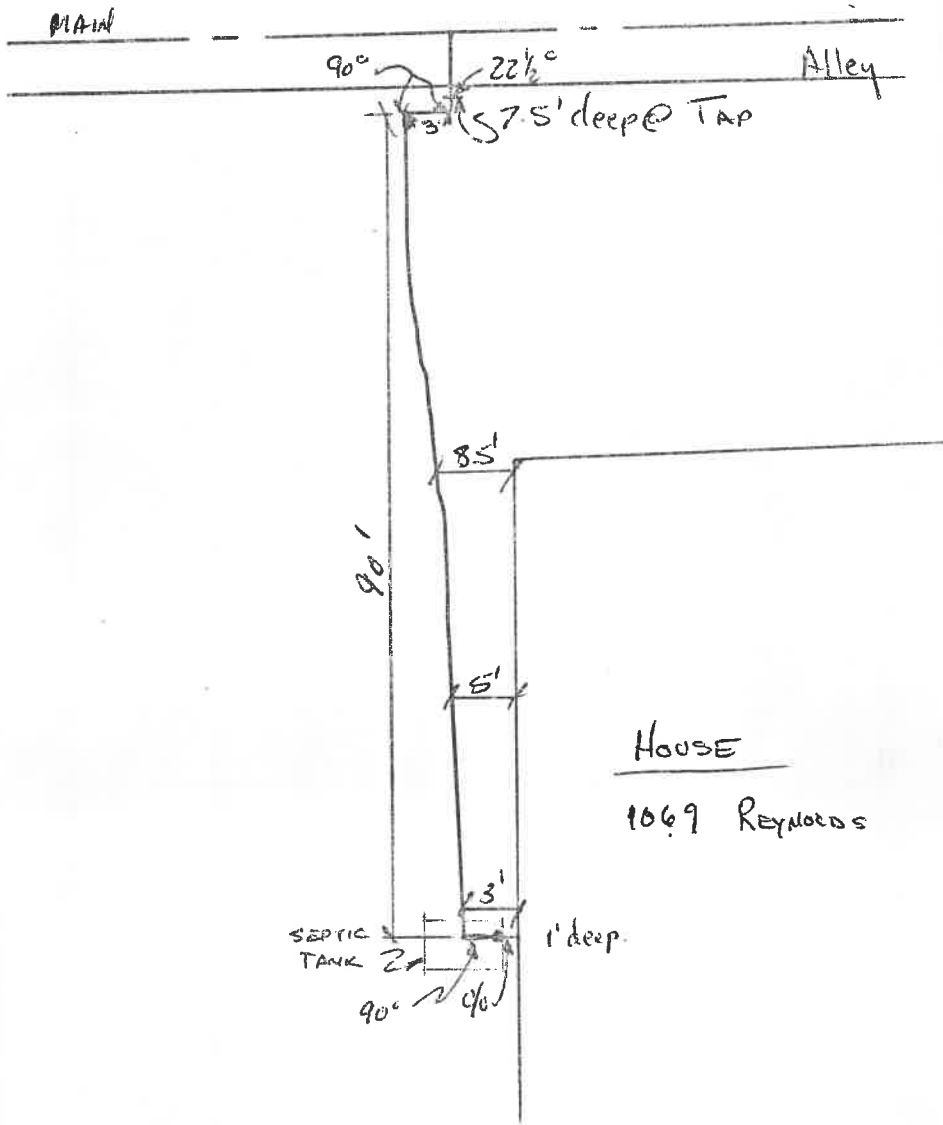

REYNOLDS ST